The sketch below is made solely for the purpose of assisting in locating said premises and the Company assumes no liability for variations, if any, in dimensions and location ascertained by actual survey.

Application No. R-8033

Permit No. 71904

"CERTIFICATE NO. 71904"

TICOR TITLE INSURANCE of California

DEC 27 1994

WATER RESOURCES DEPARTMENT SALEM, OREGON

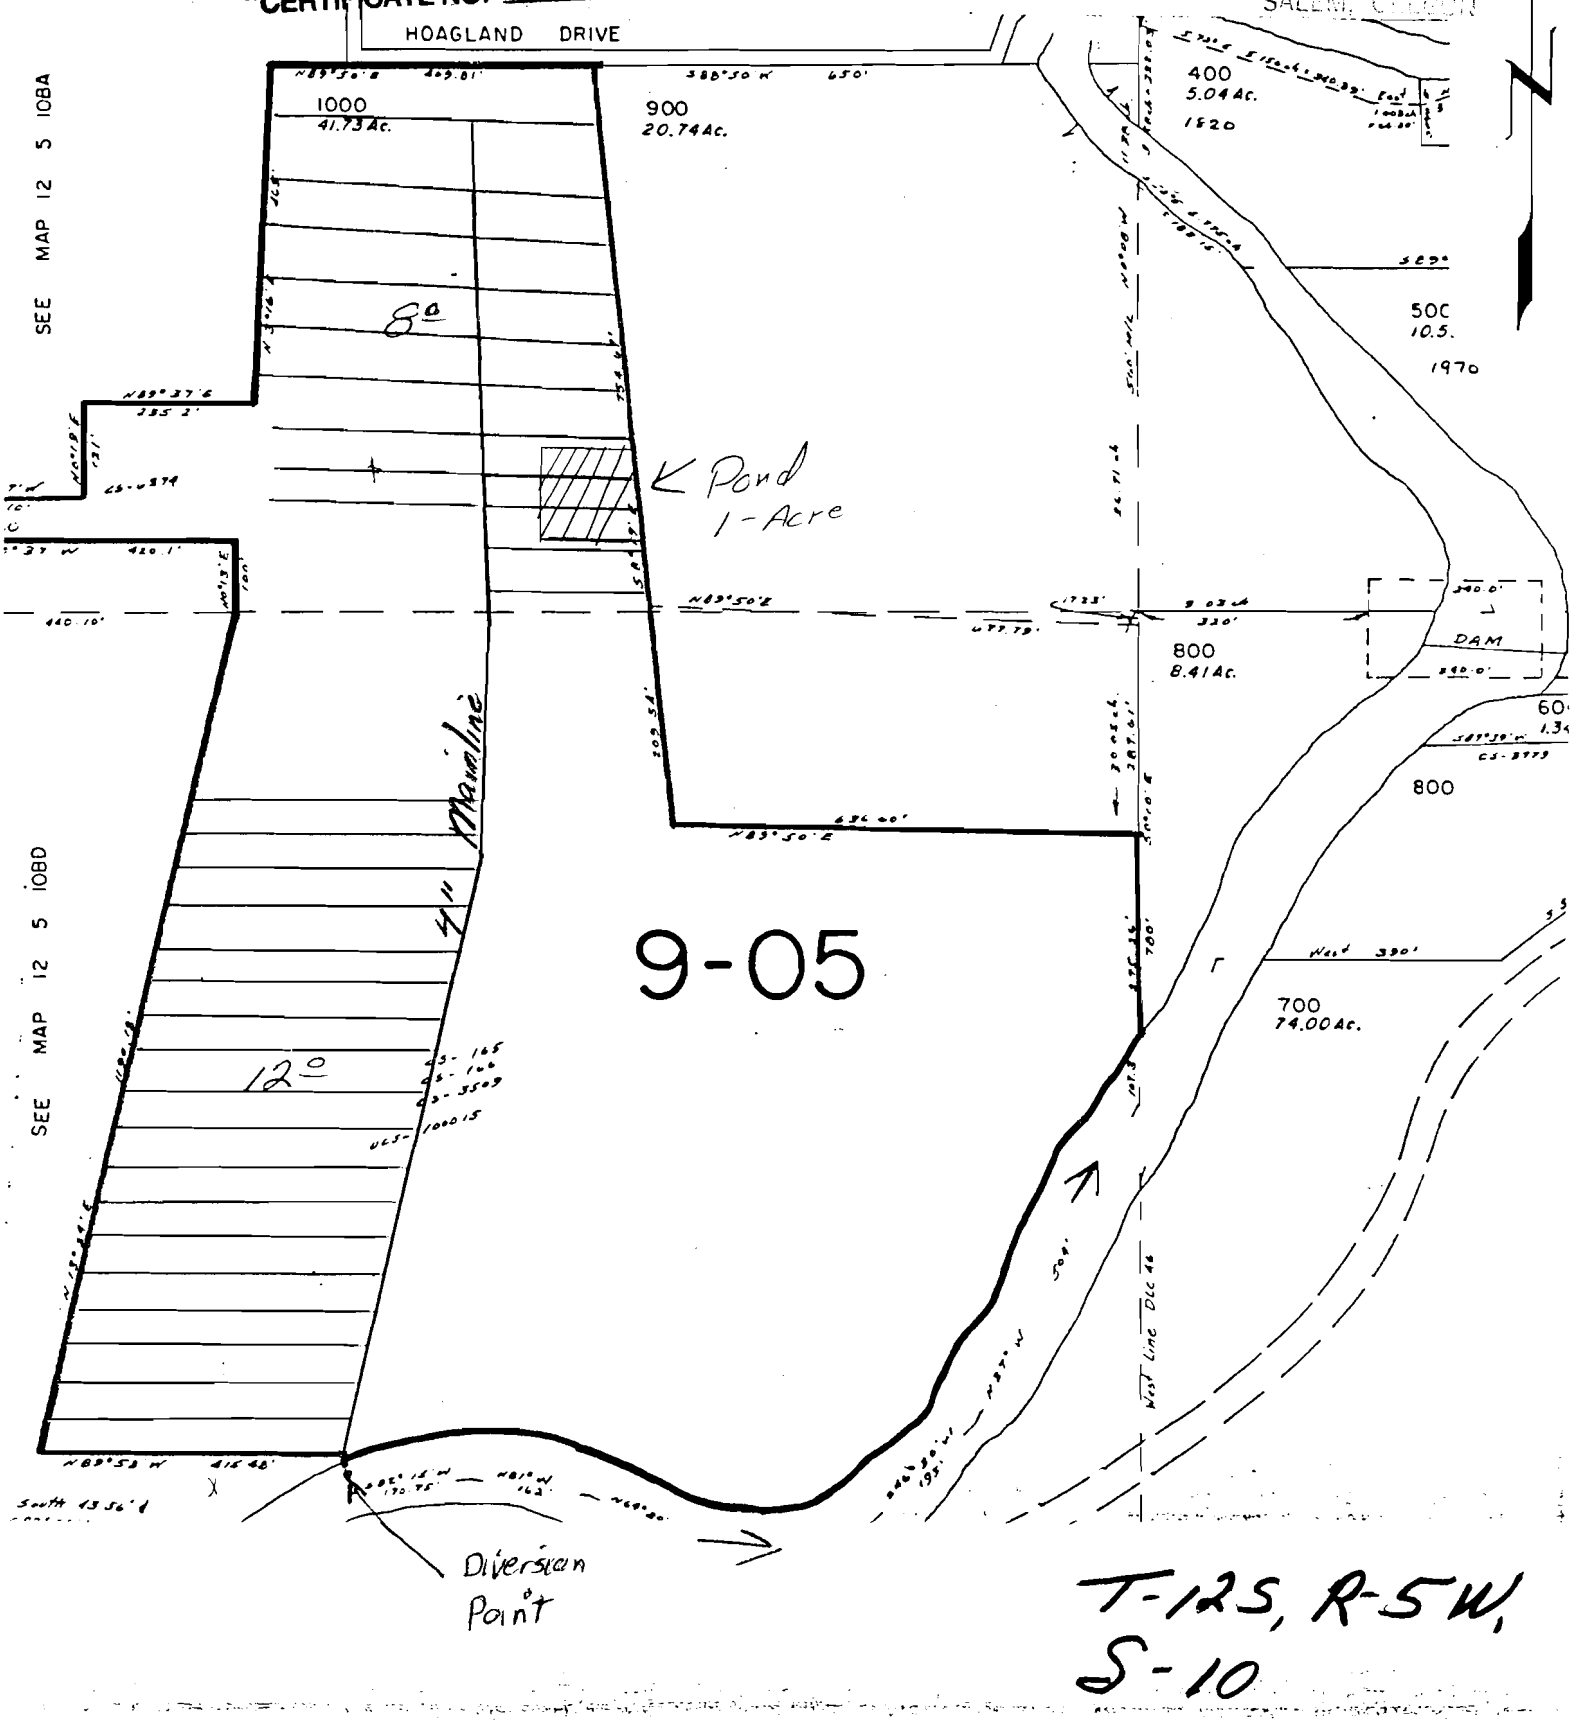

T-12S, R-5W, S-10