



THIS MAP IS FURNISHED AS A CONVENIENCE IN LOCATING PROPERTY AND THE COMPANY ASSUMES NO LIABILITY FOR ANY VARIATIONS AS MAY BE DISCLOSED BY ACTUAL SURVEY



First American Title Insurance Company of Oregon

an assumed business name of TITLE INSURANCE COMPANY OF OREGON
310 S.W. FOURTH AVENUE, PORTLAND, OR 97204
(503) 222-3651

MAP 2 3E 10

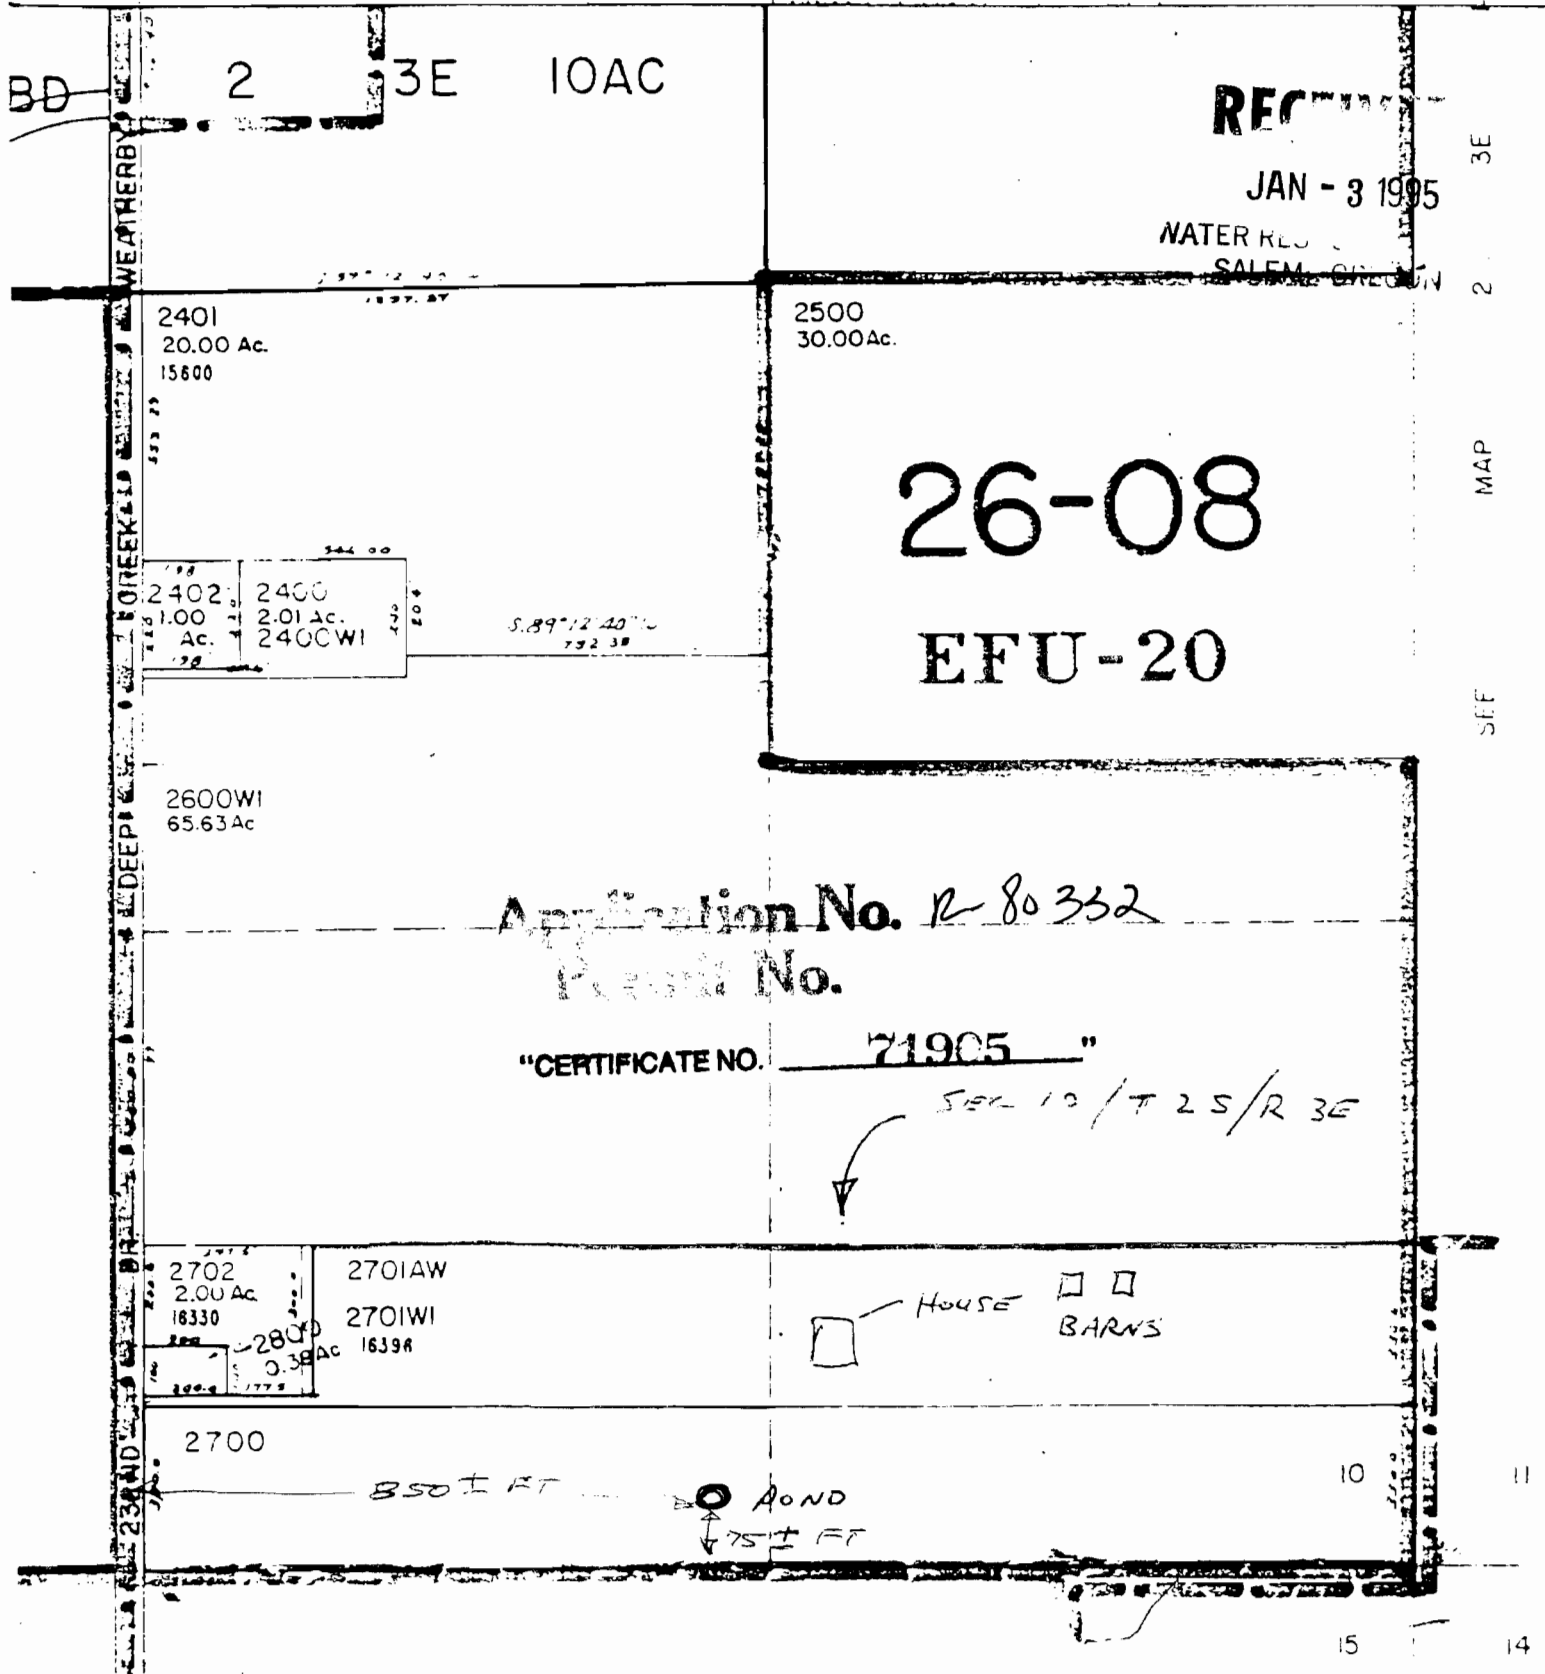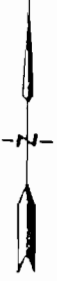

RECORDED
JAN - 3 1995
WATER REC
SALEM OREGON

26-08
EFU-20

Application No. R 80332

"CERTIFICATE NO. 71905"


HOUSE [] []
BARNS [] []

POND
850 ± FT
75 ± FT