

Range 39E

OREGON-UNION CO.  
7.5 MINUTE SERIES (TOPOGRAPHIC)

241  
(RON)

428

55'


429

PALMER JUNCTION 12 MI.

2 670 000 FEET

117°52'30"

45°37'30"

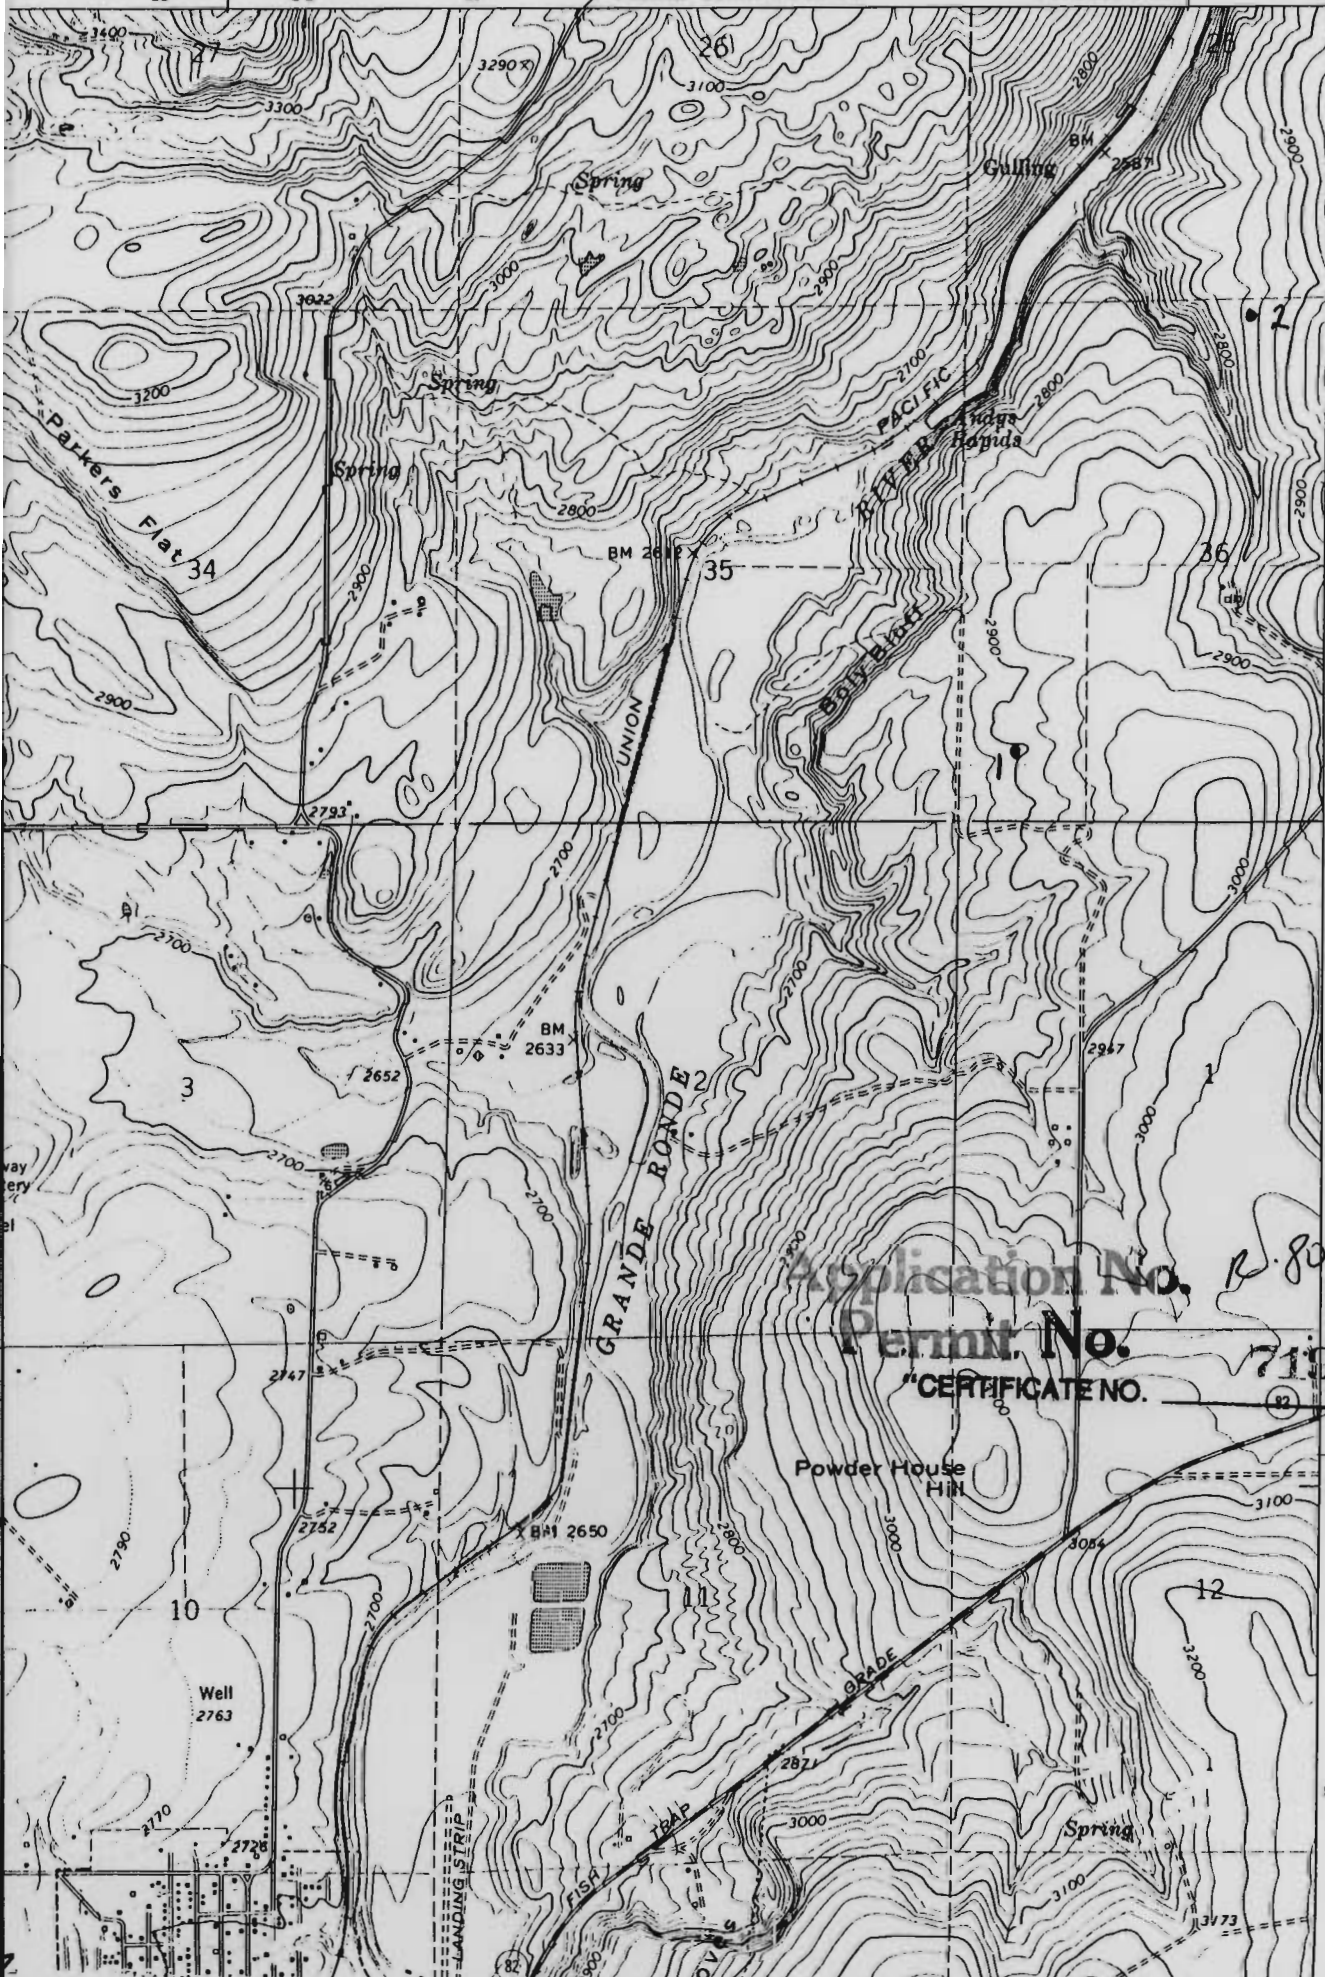

RECEIVED  
DEC 27 1994

SALEM, OREGON

720 000  
FEET

T. 2 N

T. 1 N

5049

5049

5047

Application No. R-80340  
Permit No. 71913  
"CERTIFICATE NO."

Powder House  
HIN

BM 2650












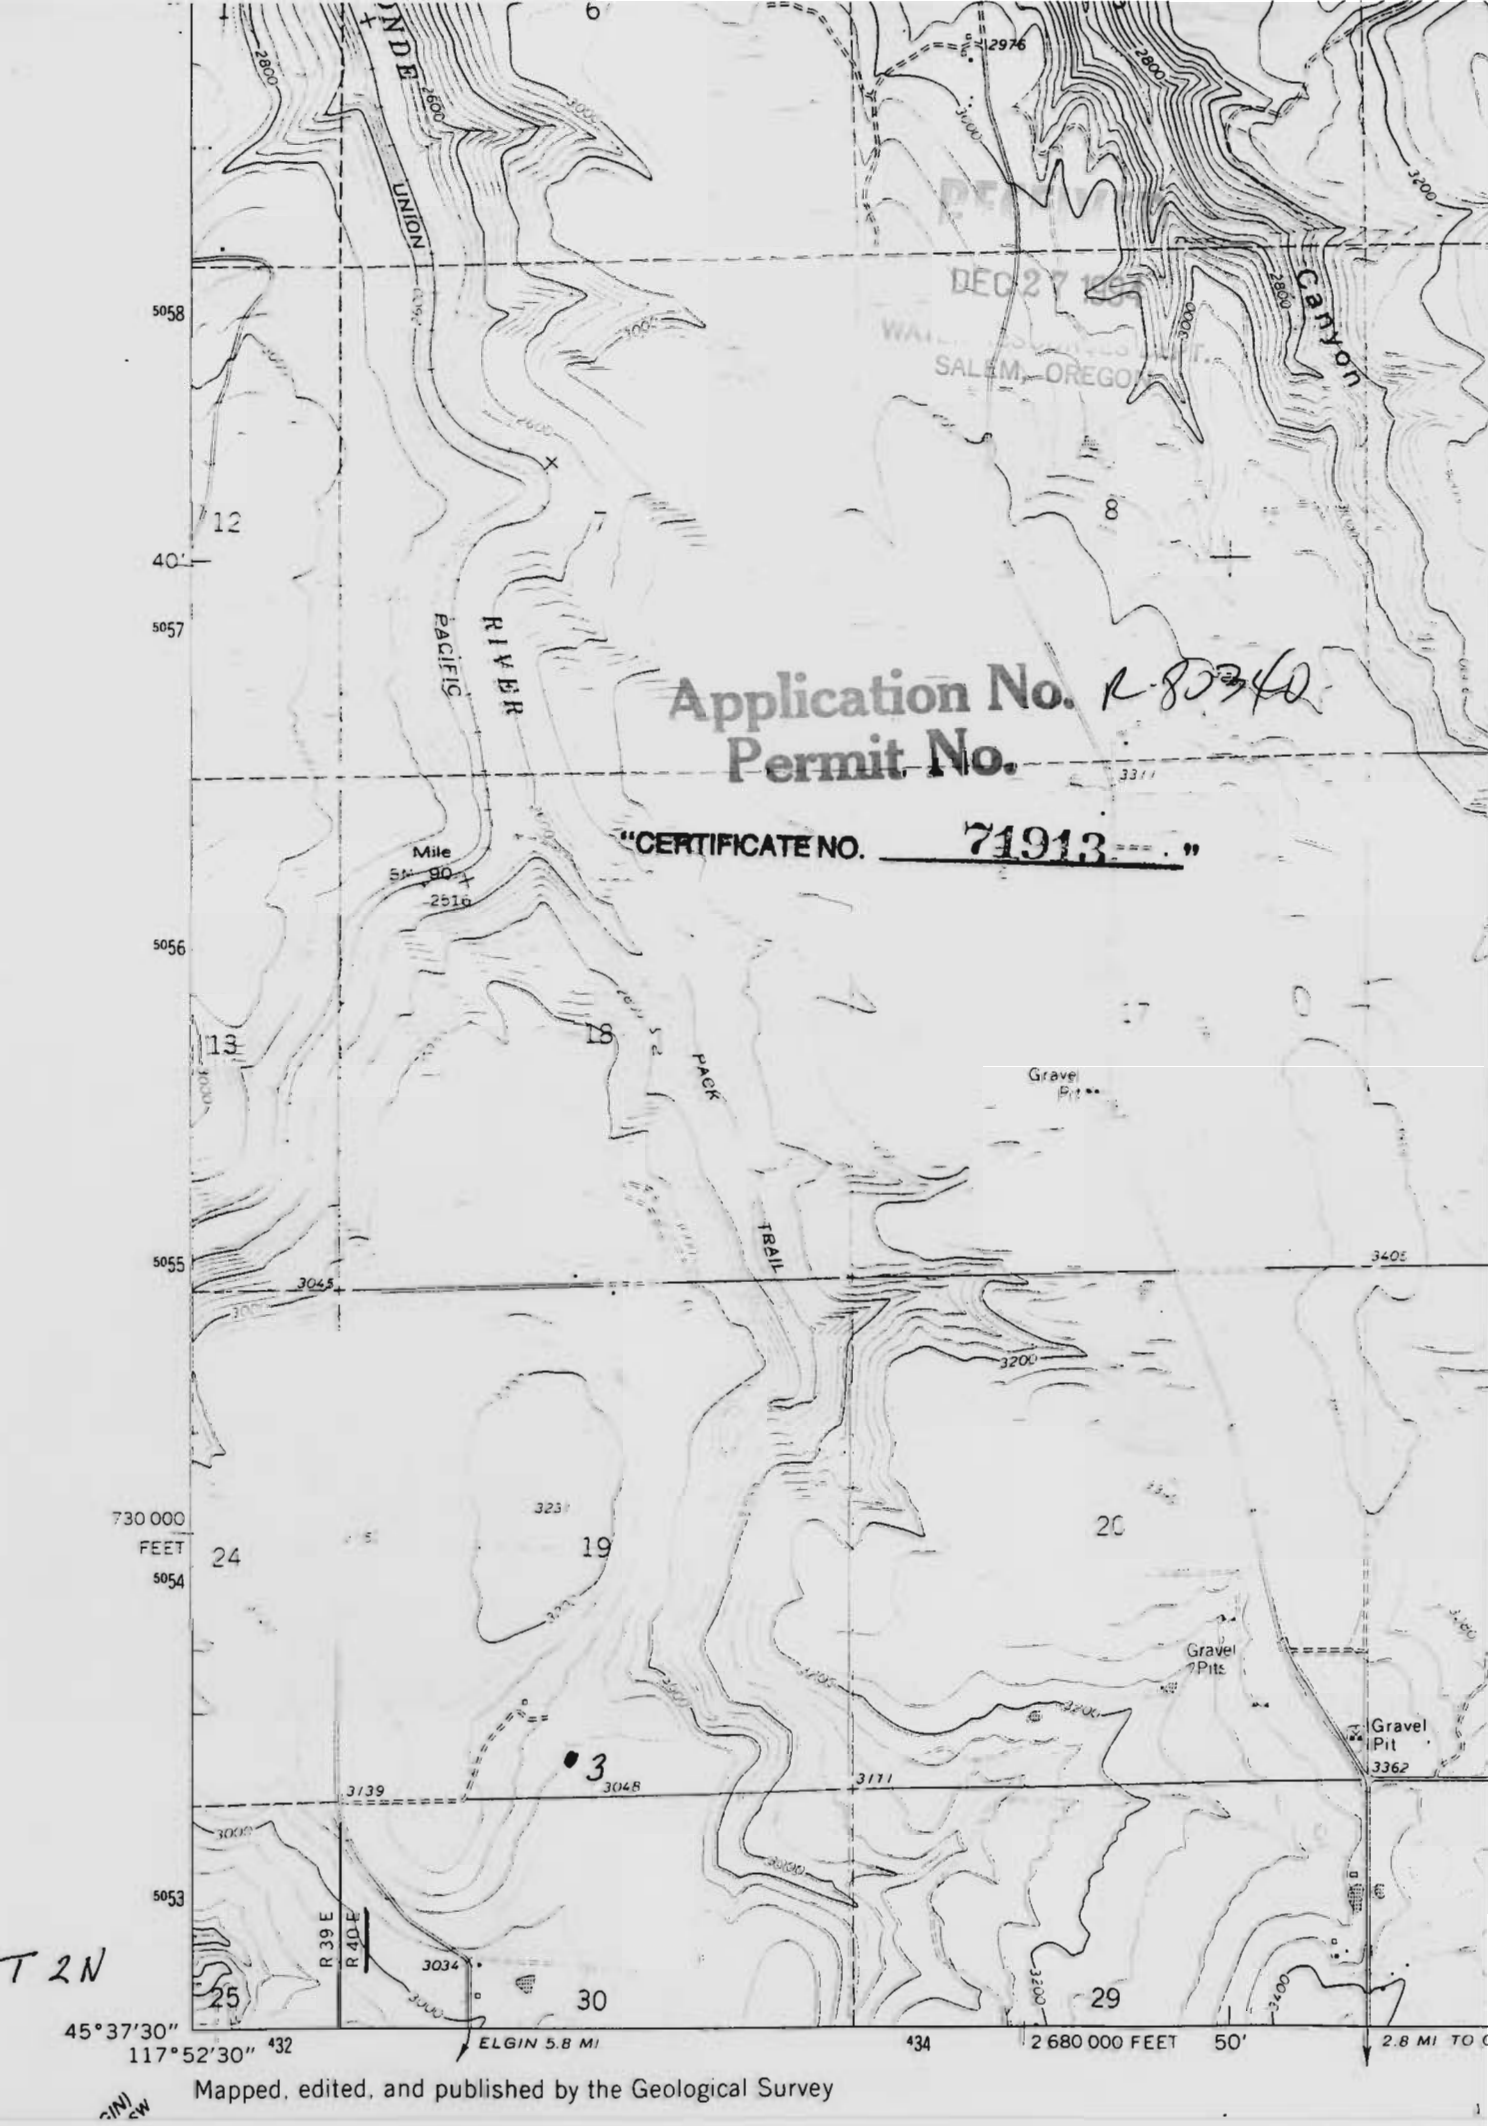

Application No. *R-85340*  
Permit No.

"CERTIFICATE NO. 71913."

T 2 N

45° 37' 30"

117° 52' 30" 432

ELGIN 5.8 MI

434

2 680 000 FEET

50'

2.8 MI TO C