

RECEIVED

MAY 15 1995

WATER RESOURCES DEPT.
SALEM, OREGON

Application No. *2-80345*
Permit No.

"CERTIFICATE NO. 71915"


T.4N. R.41E. W.M.
WALLOWA COUNTY

1" = 2000'

WE DO NOT GUARANTEE THE
ACCURACY OF THIS MAP, NOR
IS IT A PART OF OUR REPORT
WALLOWA TITLE CO.

4N 41

SEE MAP 5N 41

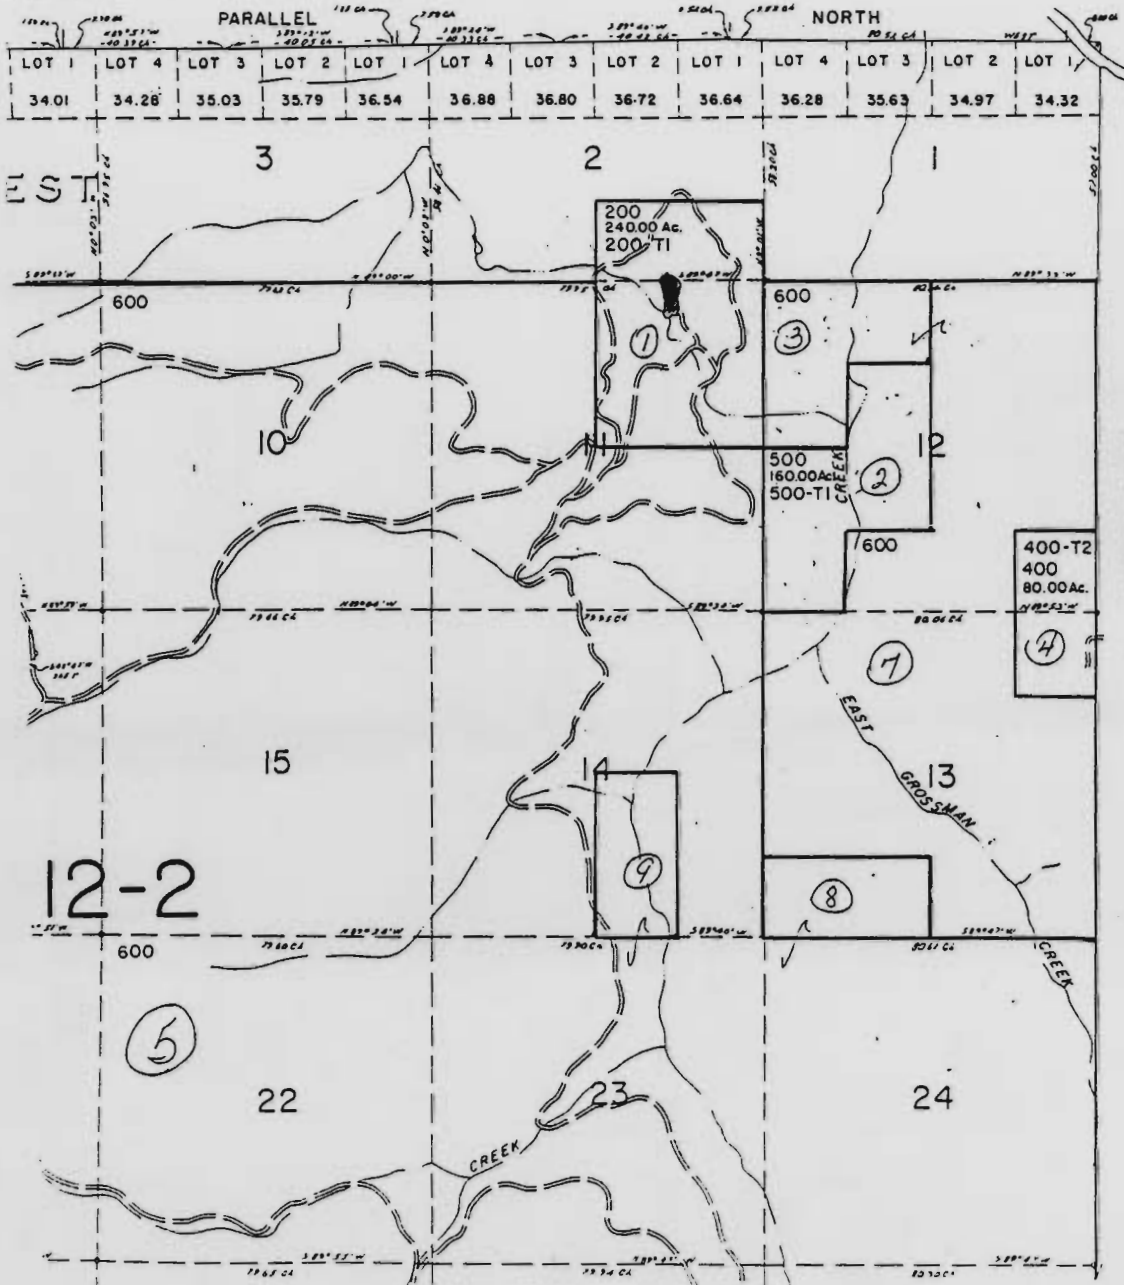

CANCELLED NOS.

- TL 700
- 800
- 900
- 1000
- 1100
- 1200
- 1300
- 1500
- 1600
- 1900
- 1900 TI
- 300
- 400 TI
- 101
- 601
- 602
- 1401
- 1400
- 1700
- 1800
- 102

NOTE: ALL OF PARCEL
100 IS NATIONAL FOREST
WITH EVERYTHING WEST
OF THE GRANDE RONDE
RIVER BEING IN THE
UMATILLA NATIONAL
FOREST, AND EVERYTHING
EAST OF THE GRANDE
RONDE RIVER BEING IN
THE WALLOWA WHITMAN
NATIONAL FOREST

SEE MAP 4N 42