


"CERTIFICATE NO. 71922"

SCALE 1:24 000

INTERIOR—GEOLOGICAL SURVEY, RESTON, VIRGINIA—1990

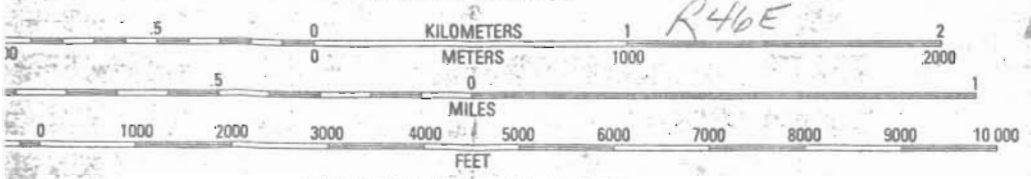

CONTOUR INTERVAL 40 FEET

Application No. R-80353

Permit No.

QUADRANGLE LOCATION

1	2	3	1 Table Mountain 2 Billy Meadows
---	---	---	-------------------------------------

ROAD LEGEND

Improved Road

Unimproved Road

Trail

Interstate Route (circle with I) U. S. Route (circle with U) S (circle with S)