

RECEIVED

DEC 30 1994

WATER RESOURCES DEPT.
SALEM, OREGON

~~Project # U-911 (96)~~


~~Property in question~~

Mosher Deep
Blue

Stream - Red

"CERTIFICATE NO. 71923

Application No. R-80354
Permit No.

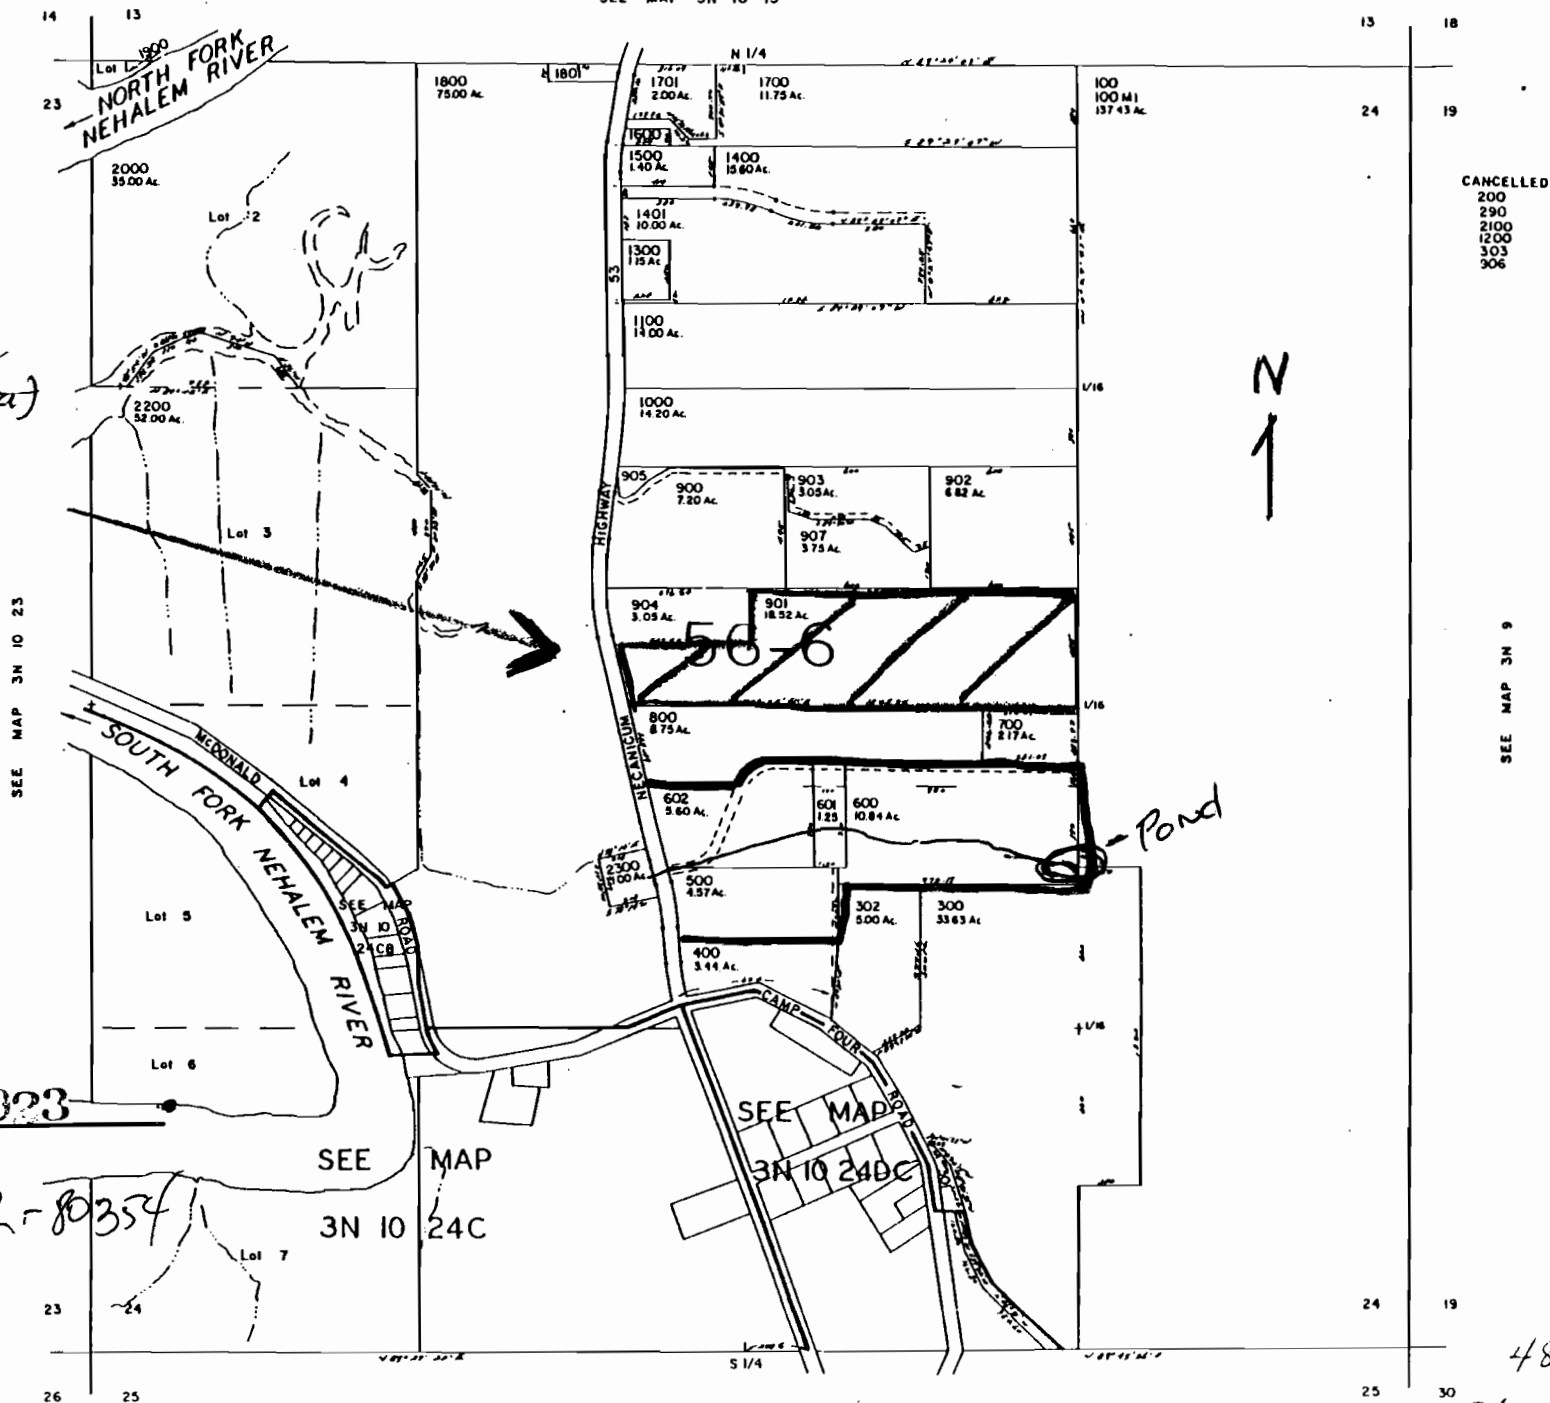

CANCELLED
200
290
2100
1200
303
306

SEE MAP 3N 9