


LANE COUNTY

1" = 800'

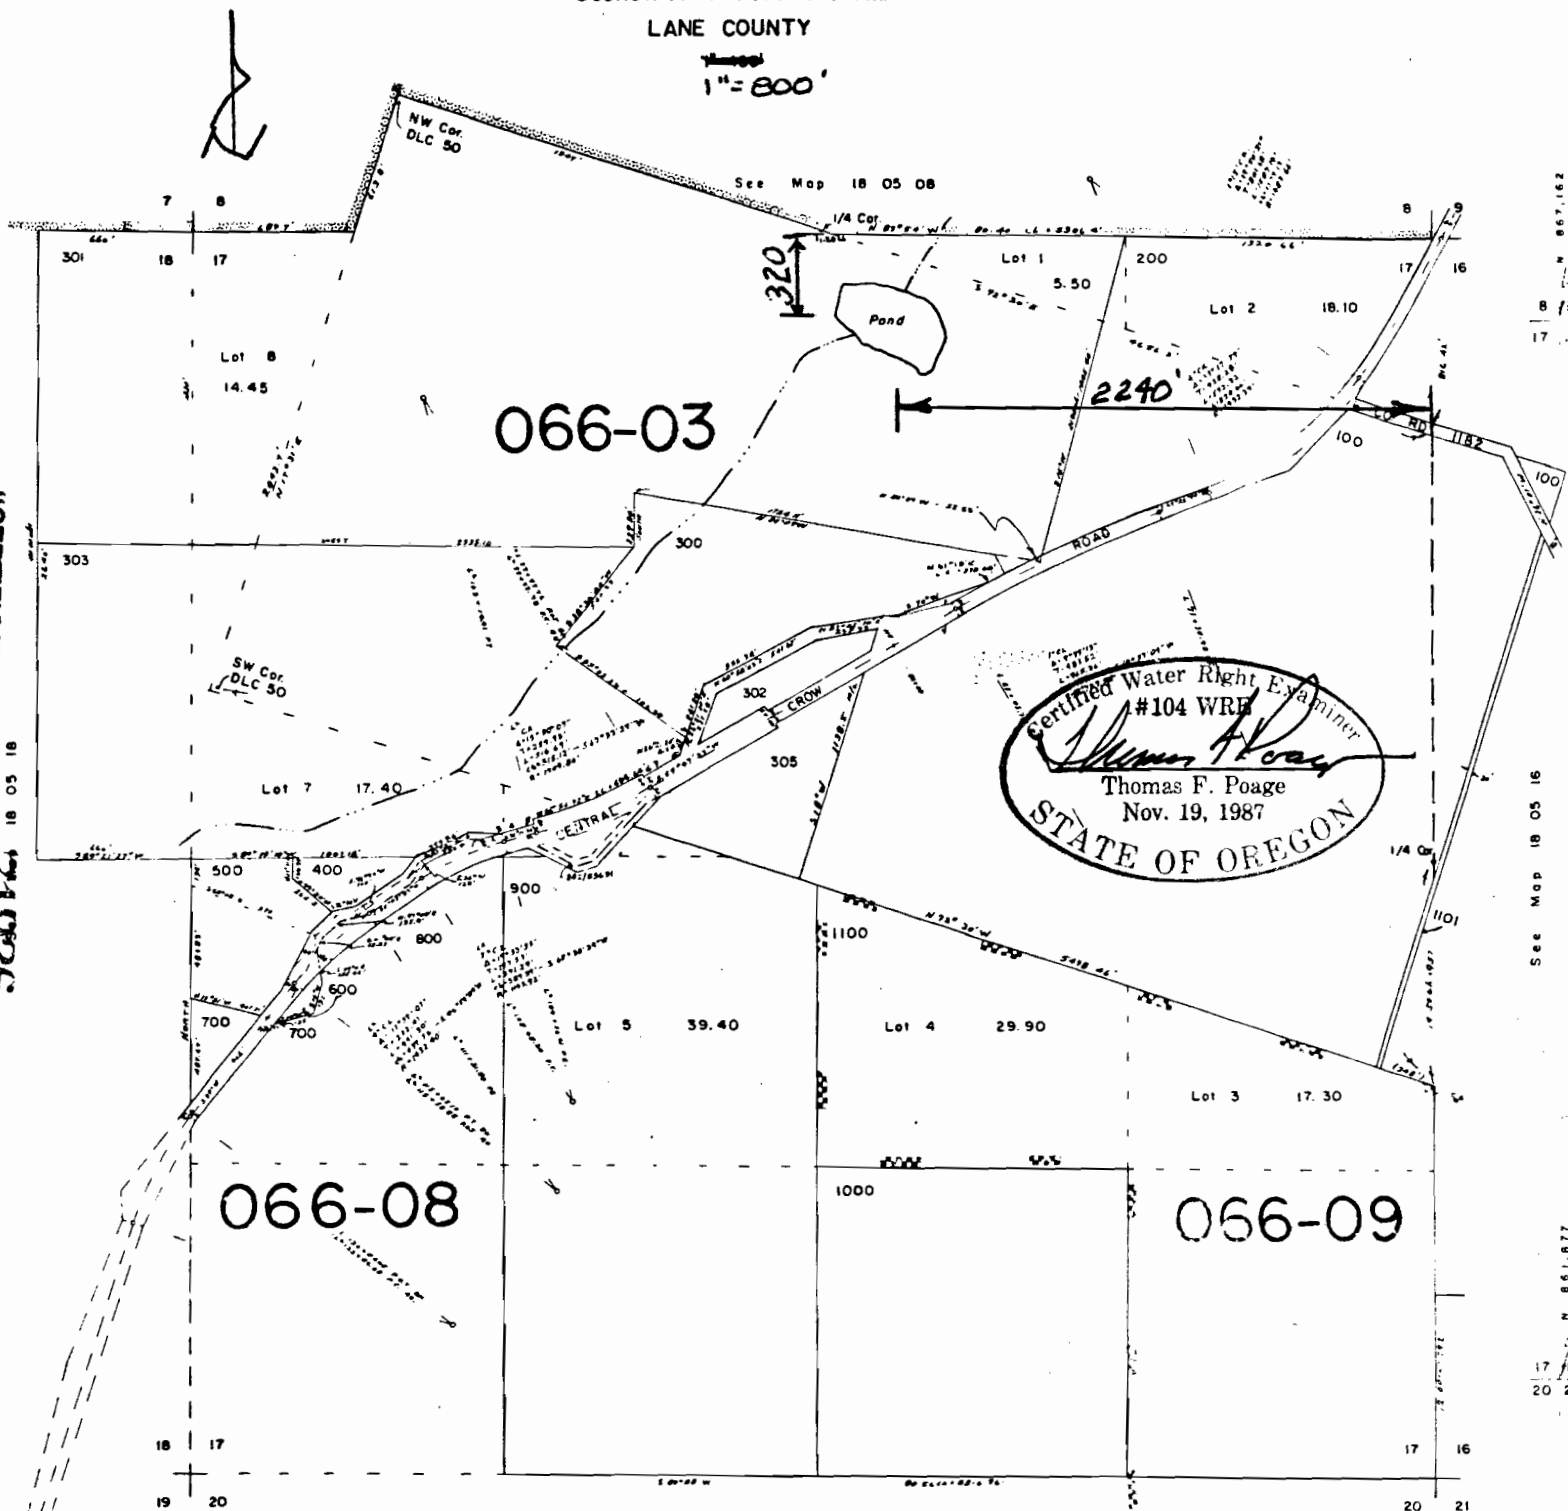

Certified Water Right Examiner
 #104 WRE
 Thomas F. Poage
 Nov. 19, 1987
 STATE OF OREGON

"CERTIFICATE NO.

71926

"

Application No. 1-80357
 Permit No.

18 17
 19 20