Sherman & Leslie Weld

SE¼, Sec 21, T14S, R1W

Scale 1" = 2000' Dec 19. 1994

N

DEC 22 1994

WATER RESOURCES DEPT.
SALEM, OREGON

Application No. R-80358

Permit No.
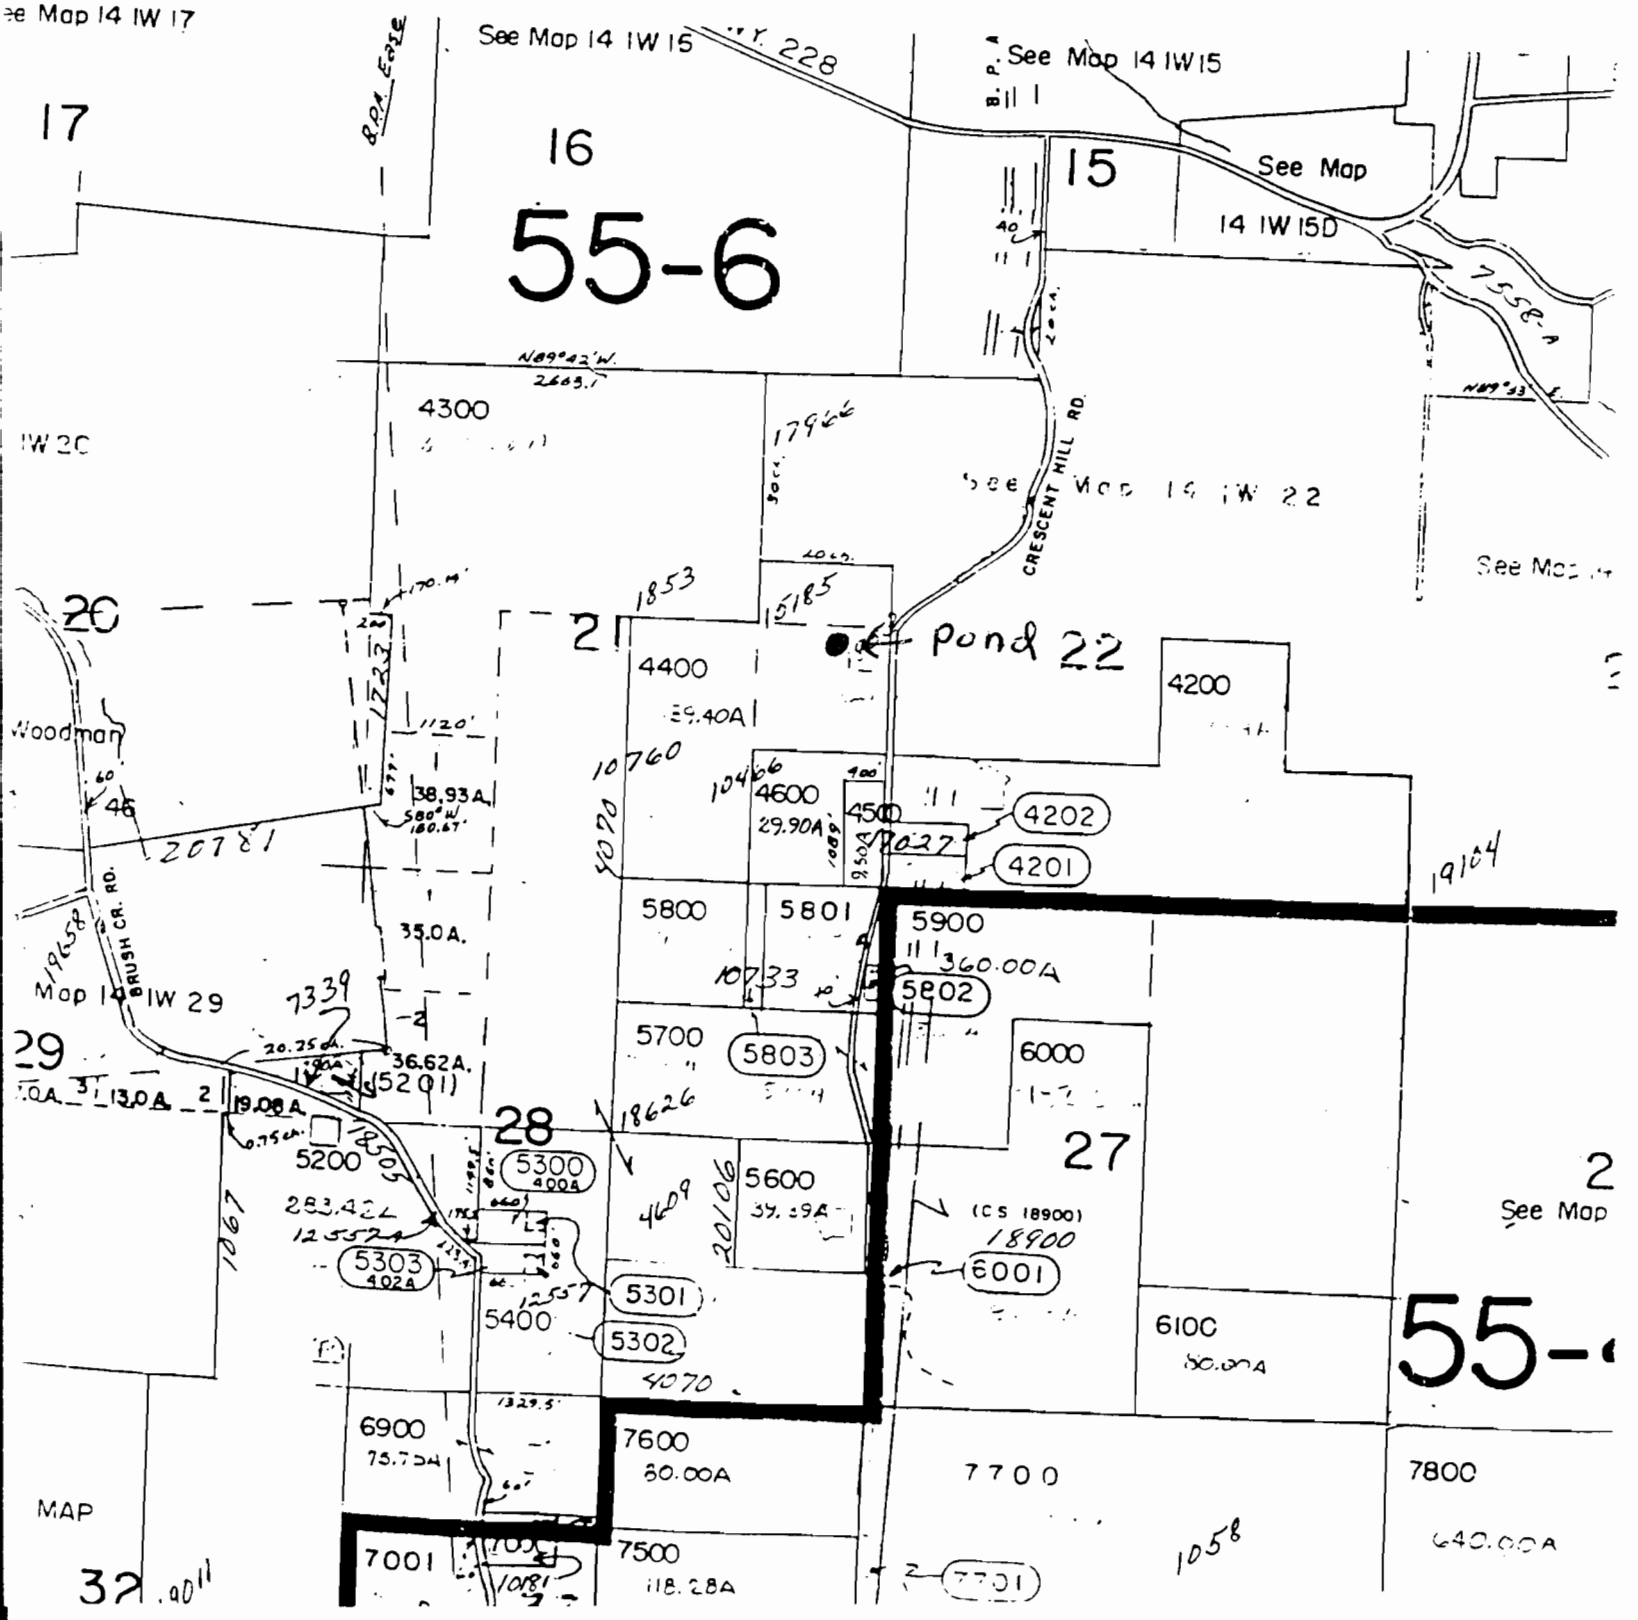
"CERTIFICATE NO. 71927"