

Donald E. Hopkins
40560 McQueen Drive
Sweet Home, Oregon 97386
Tel: 1-503-367-2986

71929

71929




SE 1/4, SE 1/4, S. 2, T 135 R 1 E W.M.
Lin County Oregon

RECEIVED

JAN - 8 1995

WATER RESOURCES
SALEM, OREGON

App. No. R-80360
Permit No.

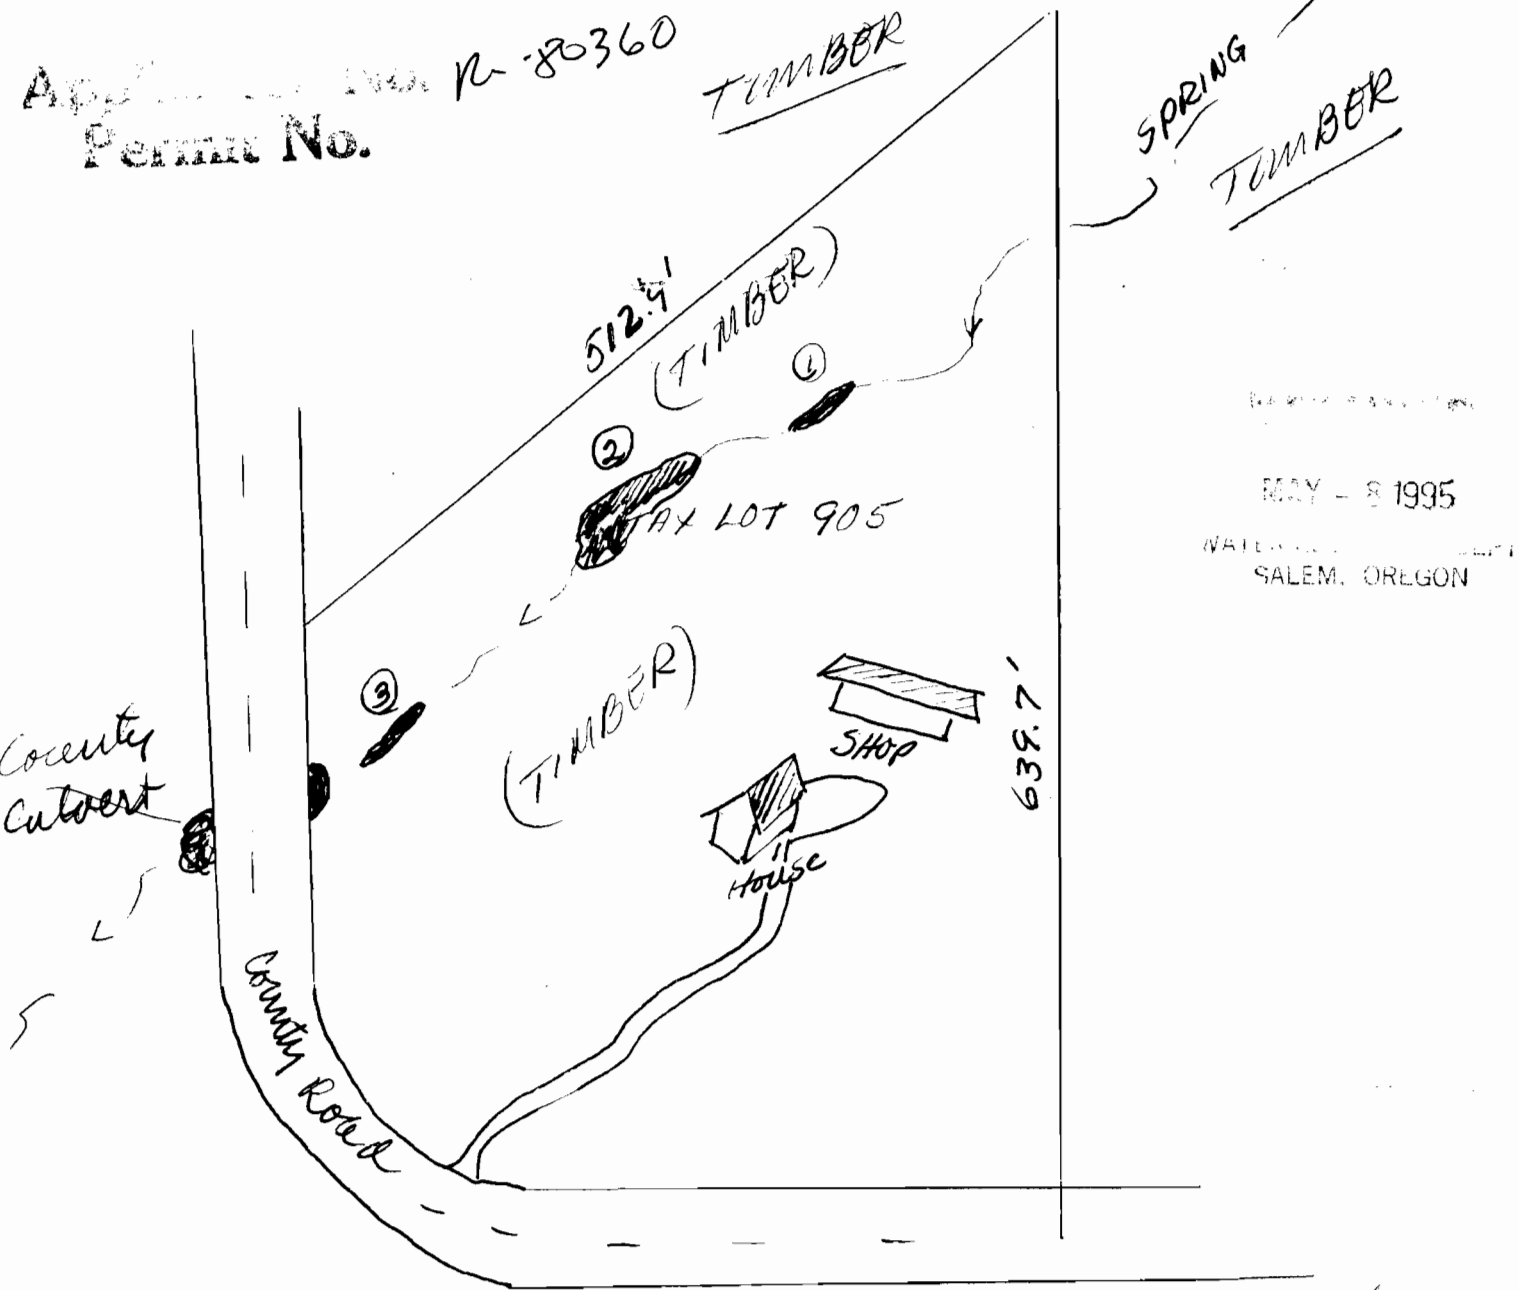

MAY - 8 1995

WATER RESOURCES
SALEM, OREGON

Pond #1 40' long 12' wide 3' deep
Pond #2 67' long 18' wide 4 1/2' deep
Pond #3 26' long 14' wide 2 1/2' deep

These are naturally formed ponds which were improved upon for wildlife benefit in 1988.