

71932

SECTION
CLA

PC-80368


Permit No.

MAY - 3 1995

WATER RES. REPT. DEPT.
SALEM, OREGON

SEE

<u>TL</u>	<u>ADD</u>
801	28266

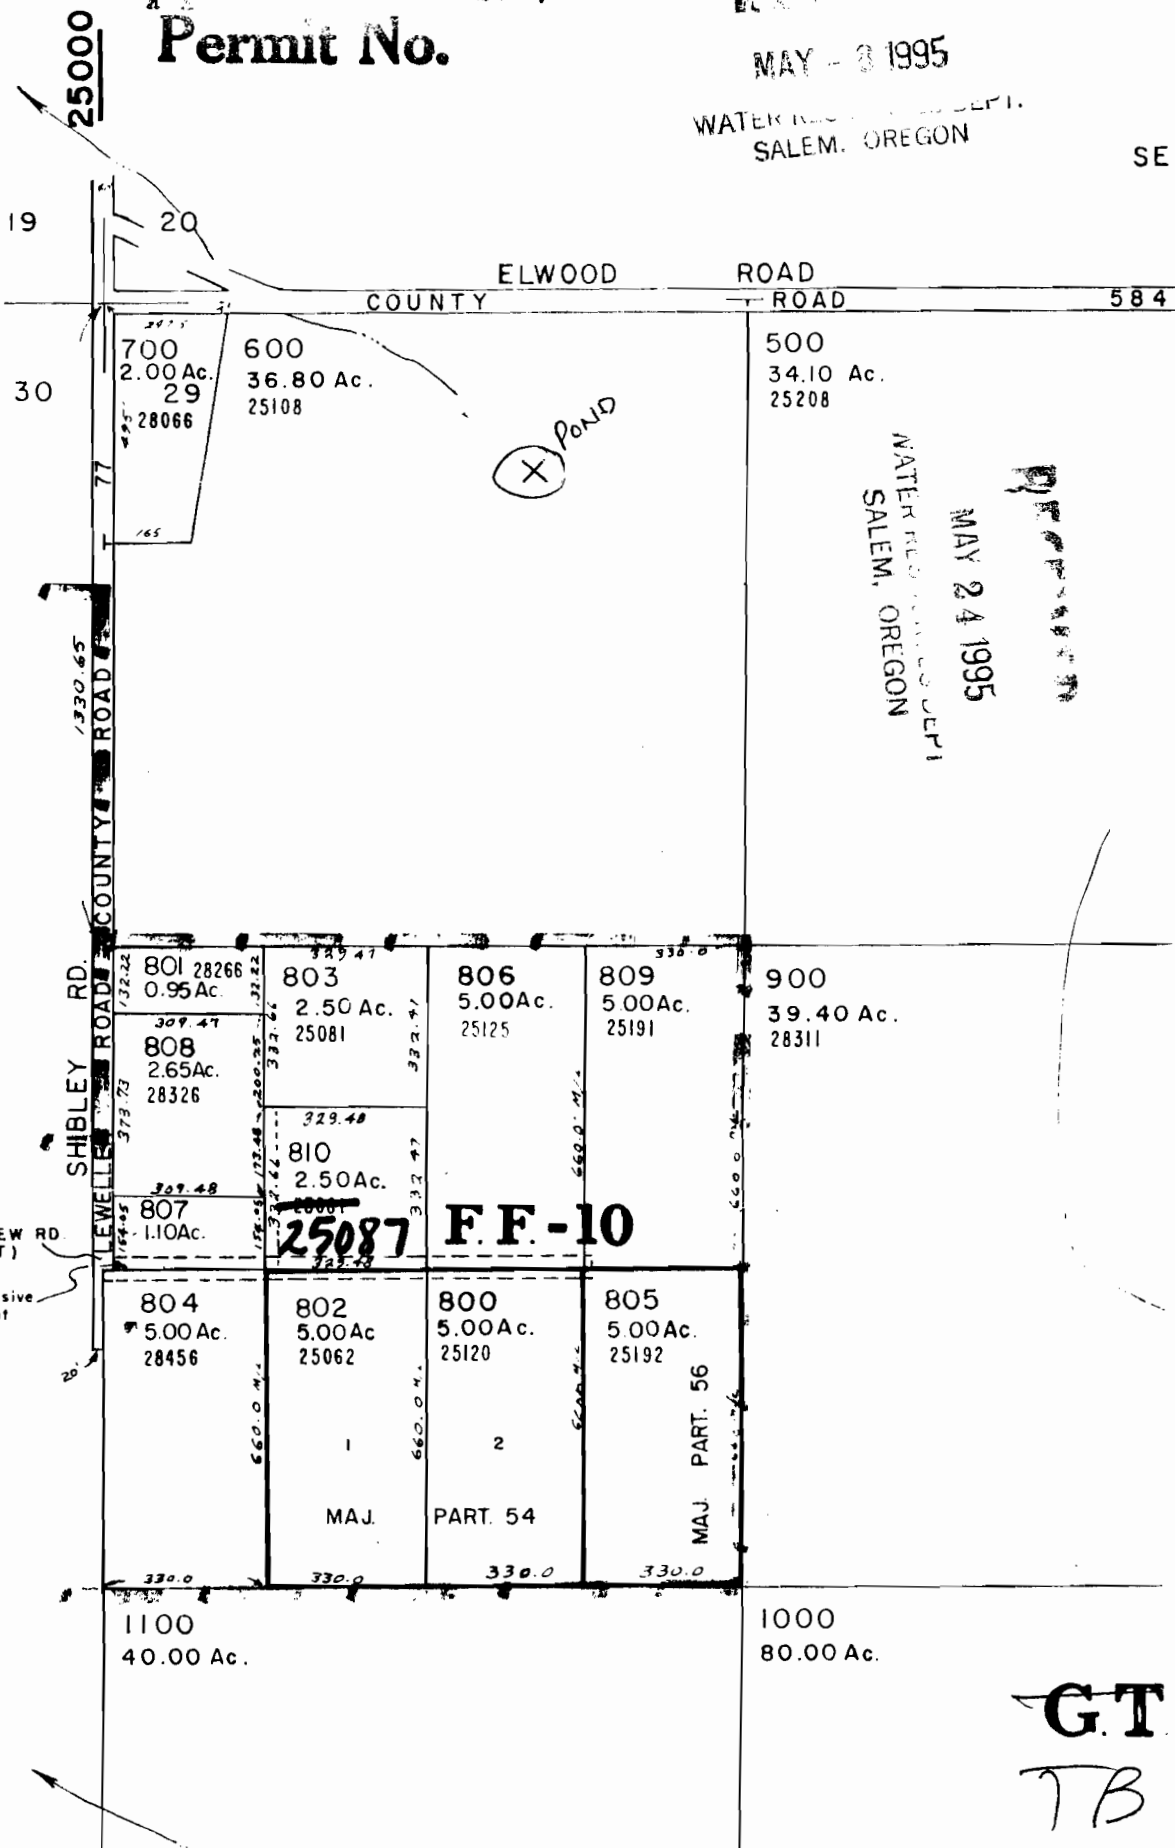

MAY 24 1995
WATER RESOURCES DEPT
SALEM, OREGON

10

MT'N VIEW RD
(PVT) —
50' nonexclusive
easement

SEE MAP 4 4E 30

G.T.
TB