


71935

T. 17 S. R. 24. E. Sec. 5

DEC 23 1984

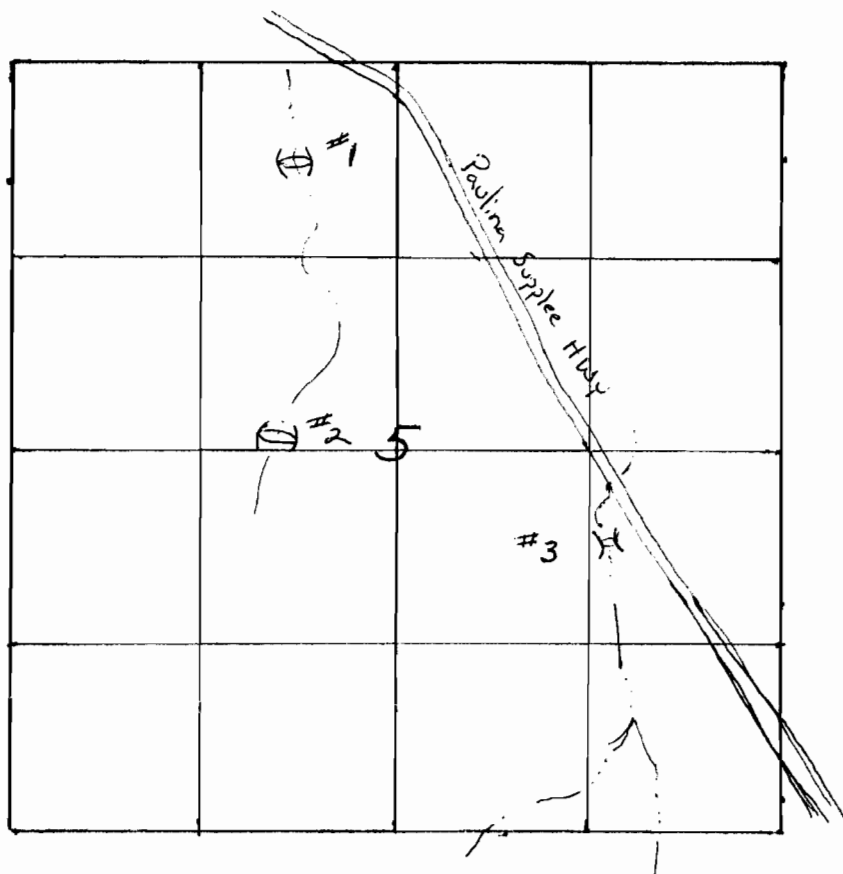


71935

DEC 2 1994


T. 15S R. 24E Sec. 36

DEC 2 1994

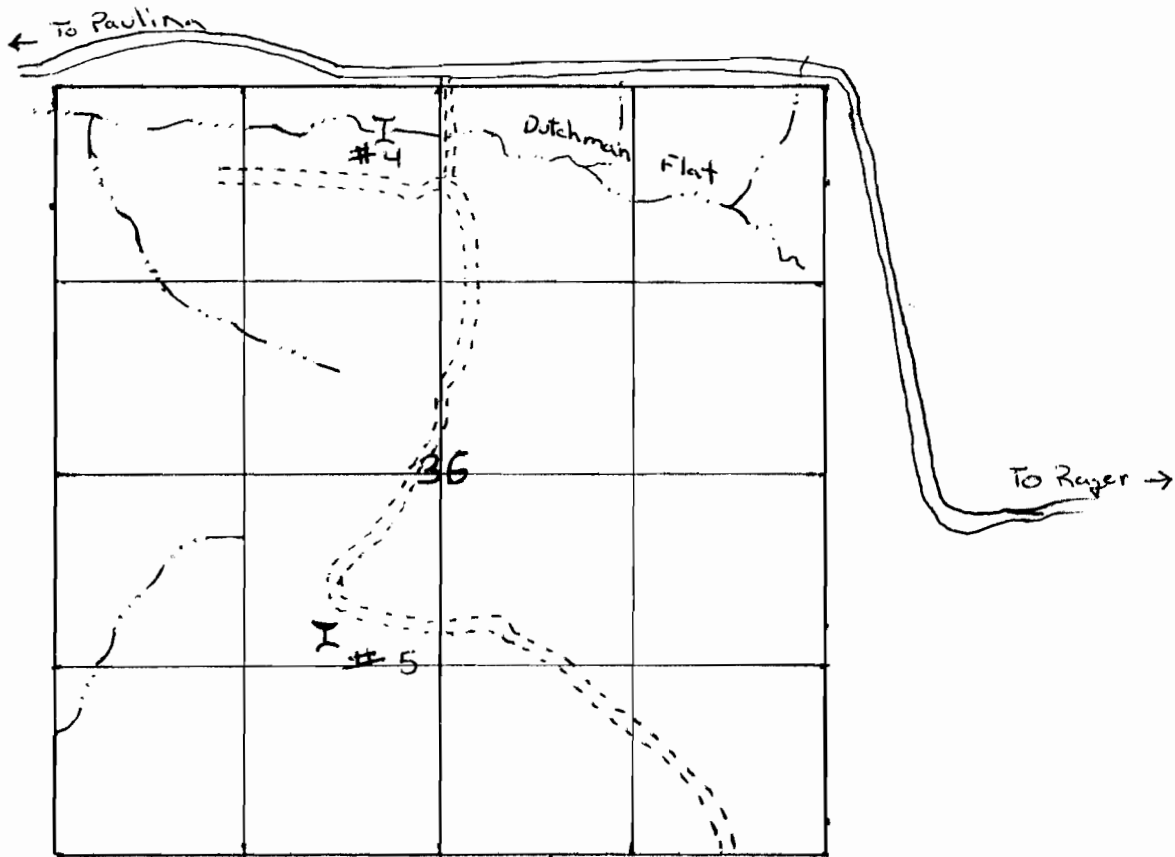

71935

T. 16 S R. 24 E. sec. 36

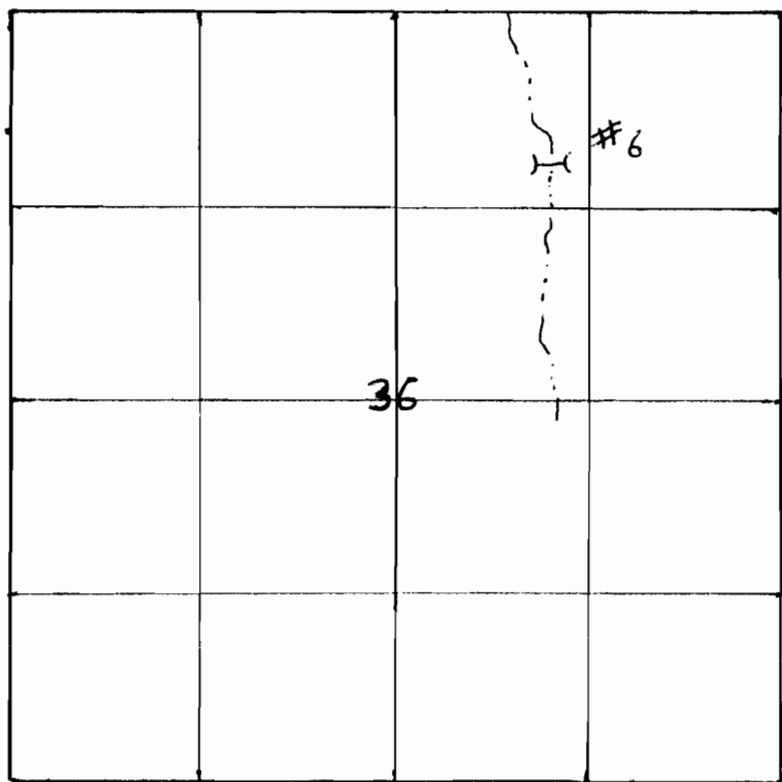


71935

DEC 2 1994

DEC 2 1994

T16S R24E Sec. 24

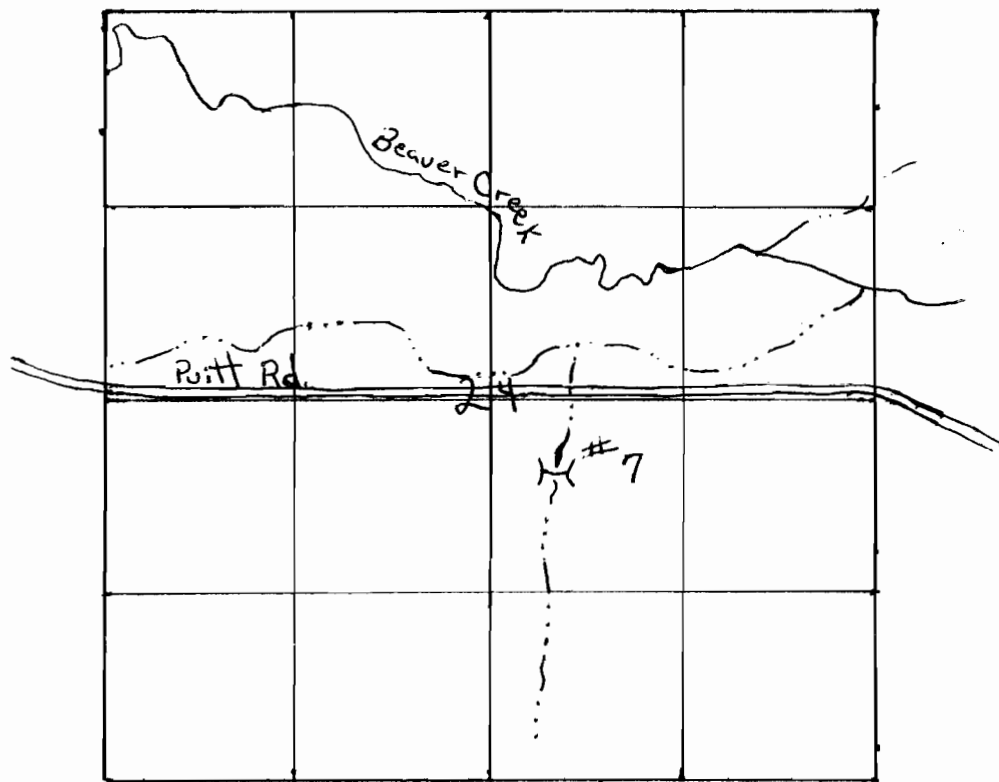

71935

DEC 2 1984

T 16 S R 24 E Sec. 13

DEC 2 1984

0 1000'

