


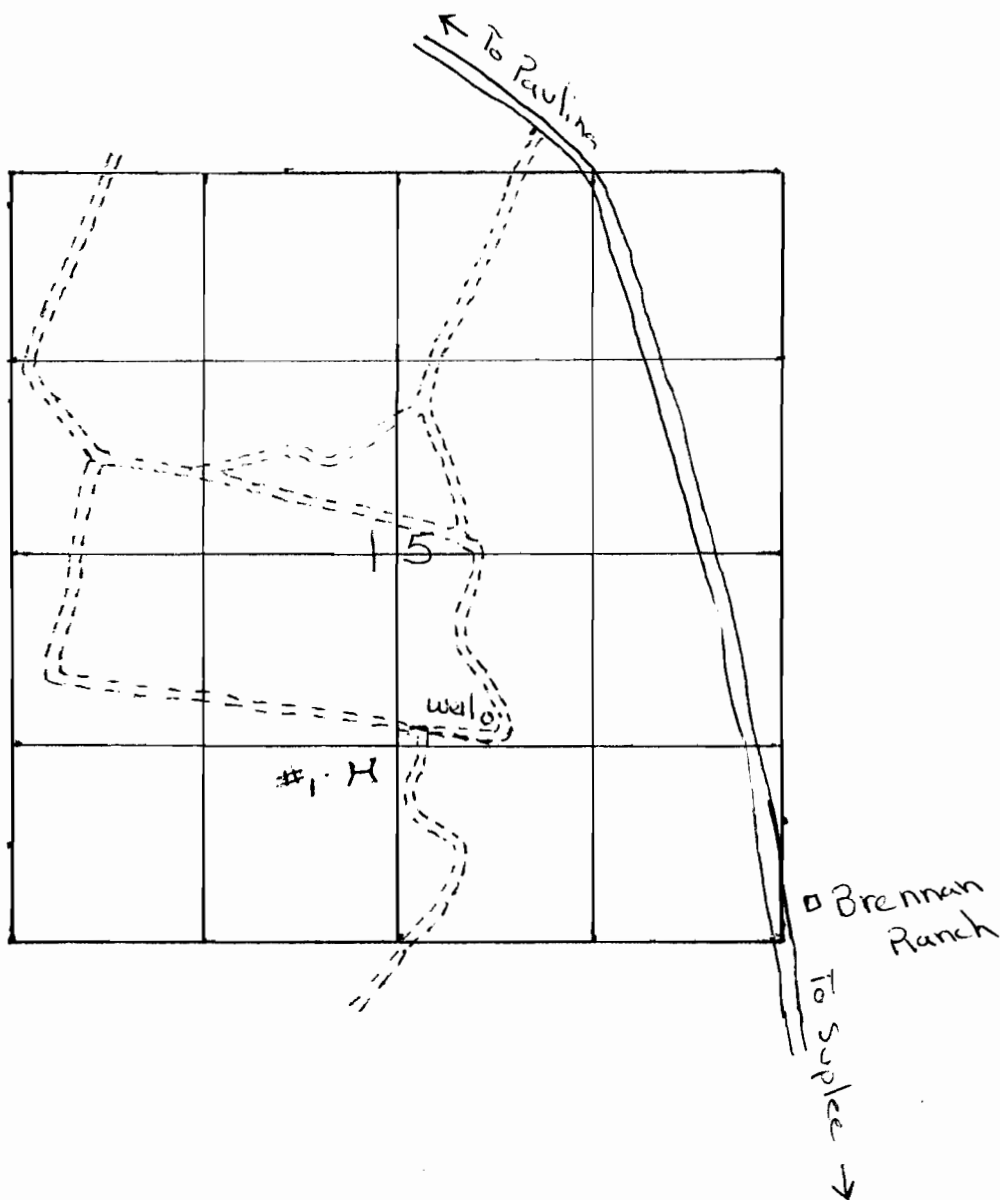

DEC 23 1994

1994


T. 17S. R. 24E. Sec. 15



71936

1994

T. 17. S. R. 24. E. sec. 10 DEC 2 1994

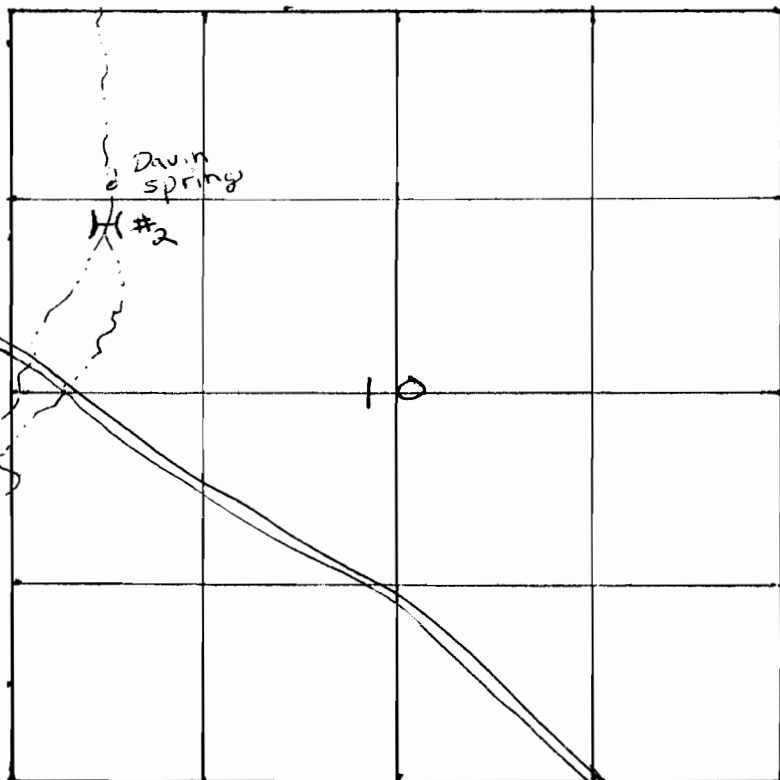

Application No. R-80372
Permit No.