


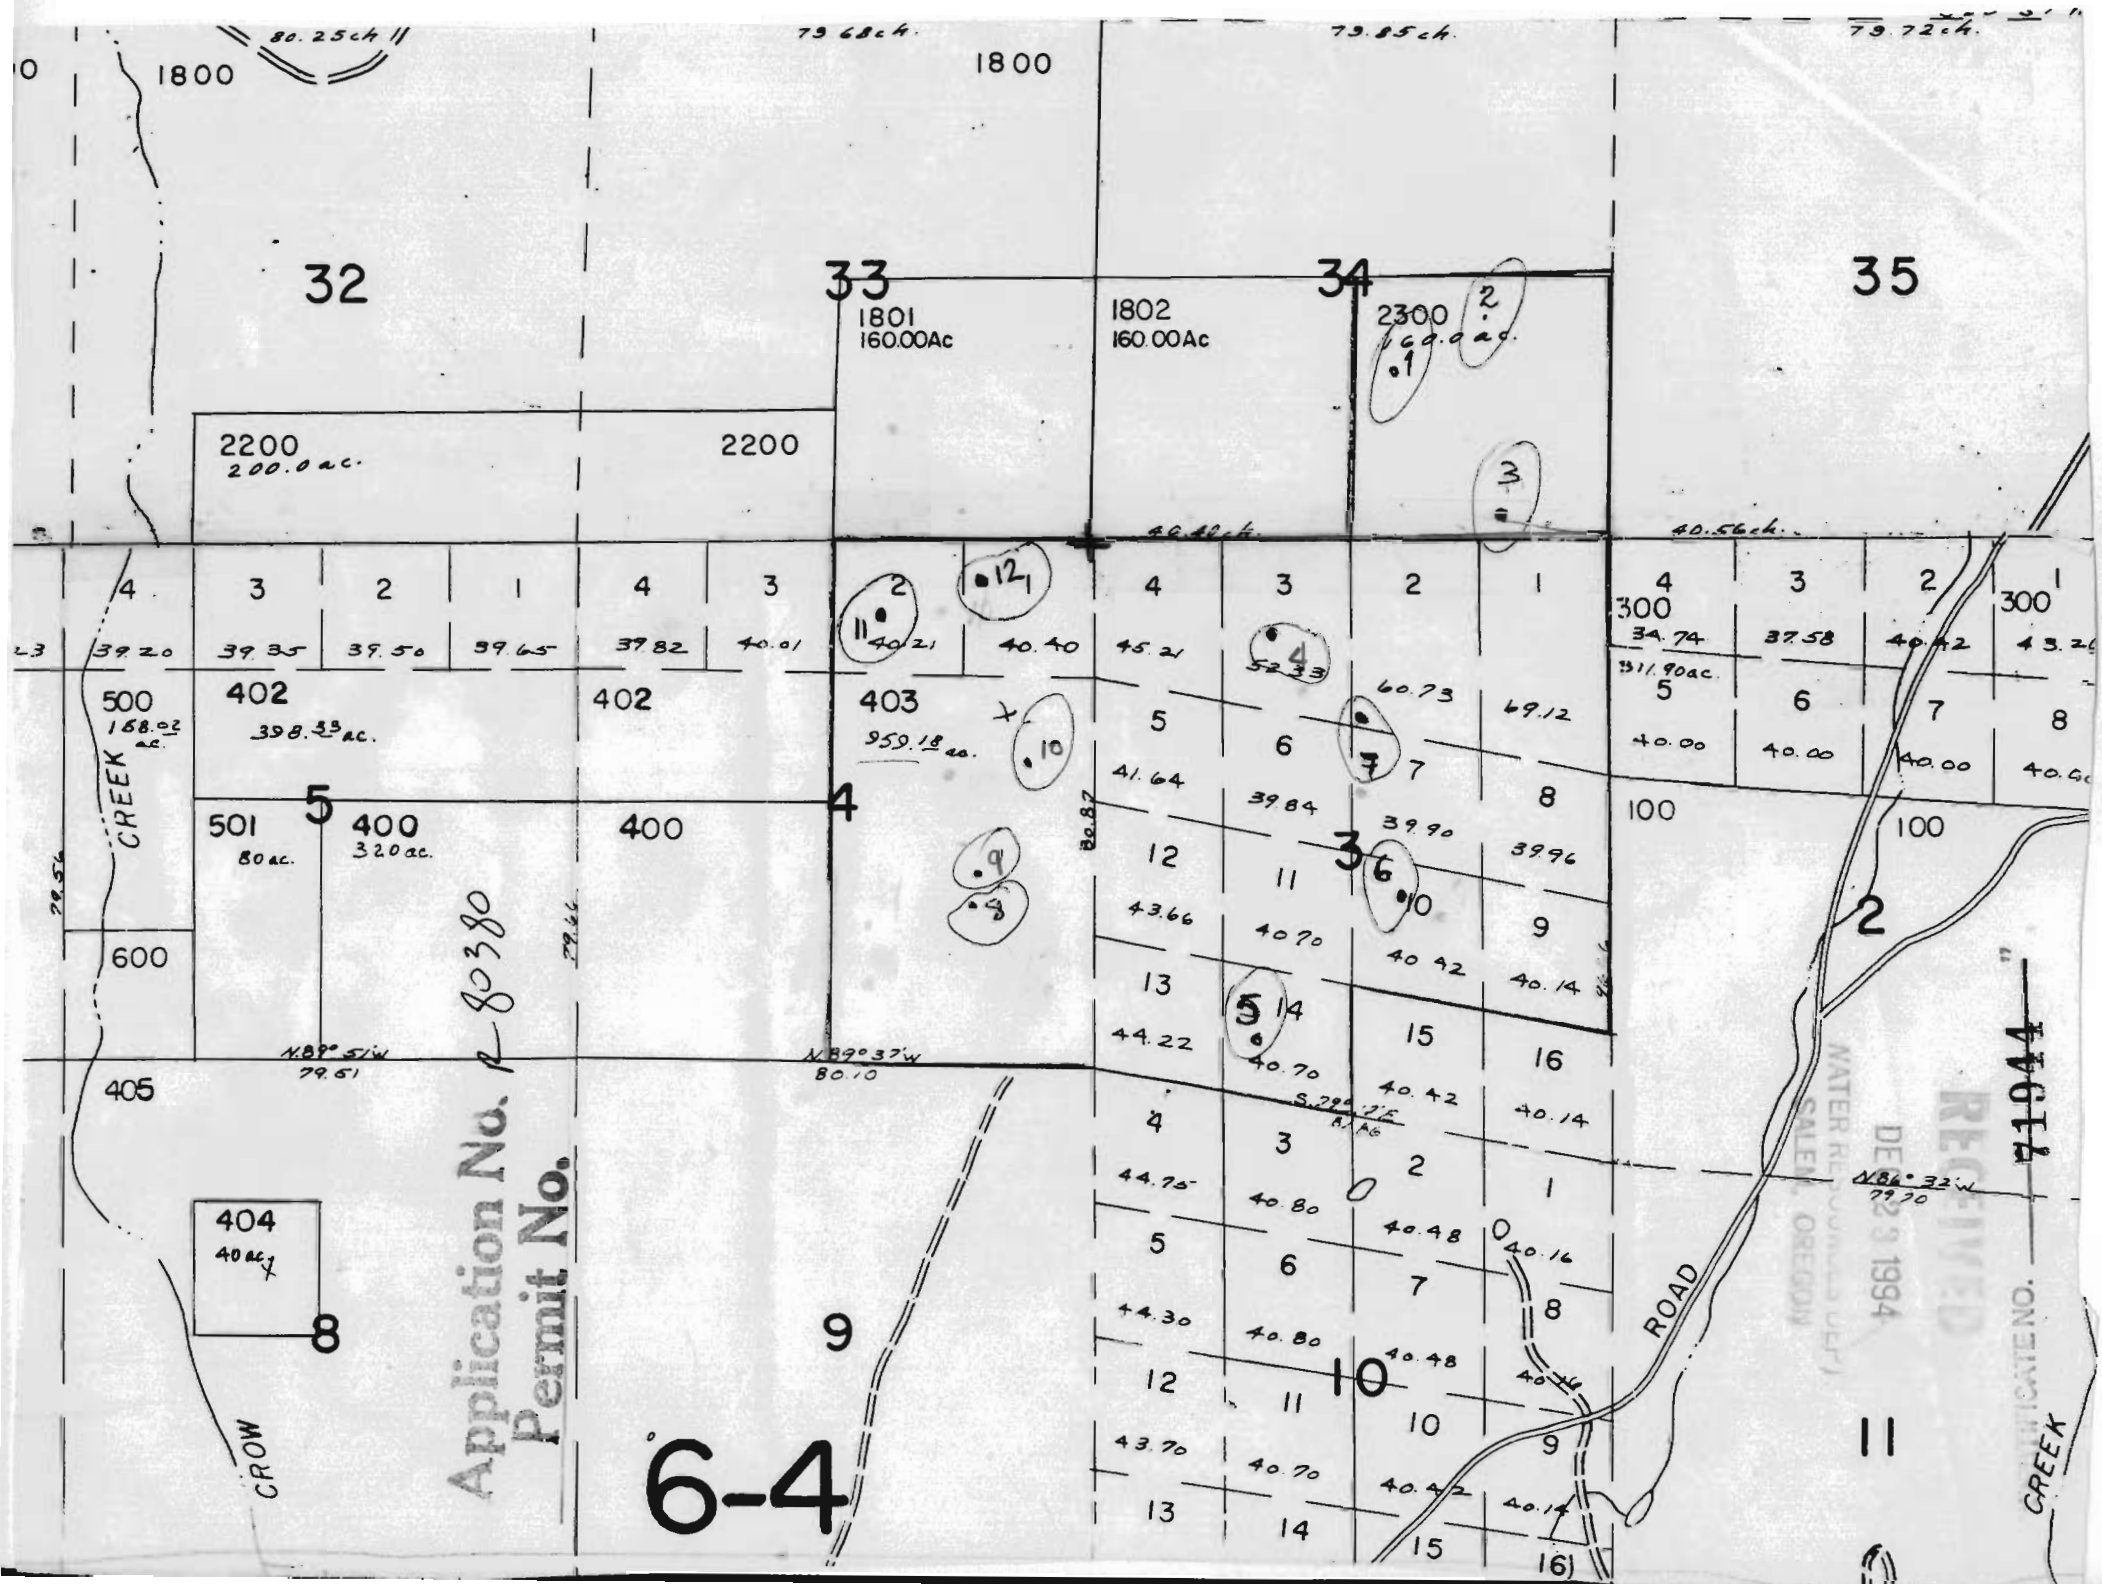

32

33

34

35

1801
160.00Ac

1802
160.00Ac

2300
160.0Ac

2200
200.0Ac

2200

4
39.20

3
39.35

2
39.50

1
39.65

4
37.82

3
40.01

2
40.21

12
40.40

4
45.21

3
52.33

2
60.73

1
69.12

4
34.74

3
37.58

2
40.42

300
43.26

500
168.02Ac

402
398.53Ac

402

403
959.18Ac

5
41.64

6
39.84

7
39.90

8
39.96

5
311.90Ac

6
40.00

7
40.00

8
40.00

501
80Ac

5
400

320Ac

400

4

12
43.66

11
40.70

10
40.42

9
40.14

100

100

600

405

N 89° 51' W
79.51

N 89° 37' W
80.10

404
40Ac

8

Application No. R-80380
Permit No.

6-4

9

4
44.75

3
40.80

2
40.48

1
40.16

5
44.30

6
40.80

7
40.48

8
40.16

12
43.70

11
40.70

10
40.42

9
40.14

13

14

15

16

RECEIVED
WATER RESOURCES DEPT.
SALEM, OREGON
DEC 23 1994

N 86° 32' W
79.70

71944

CREEK