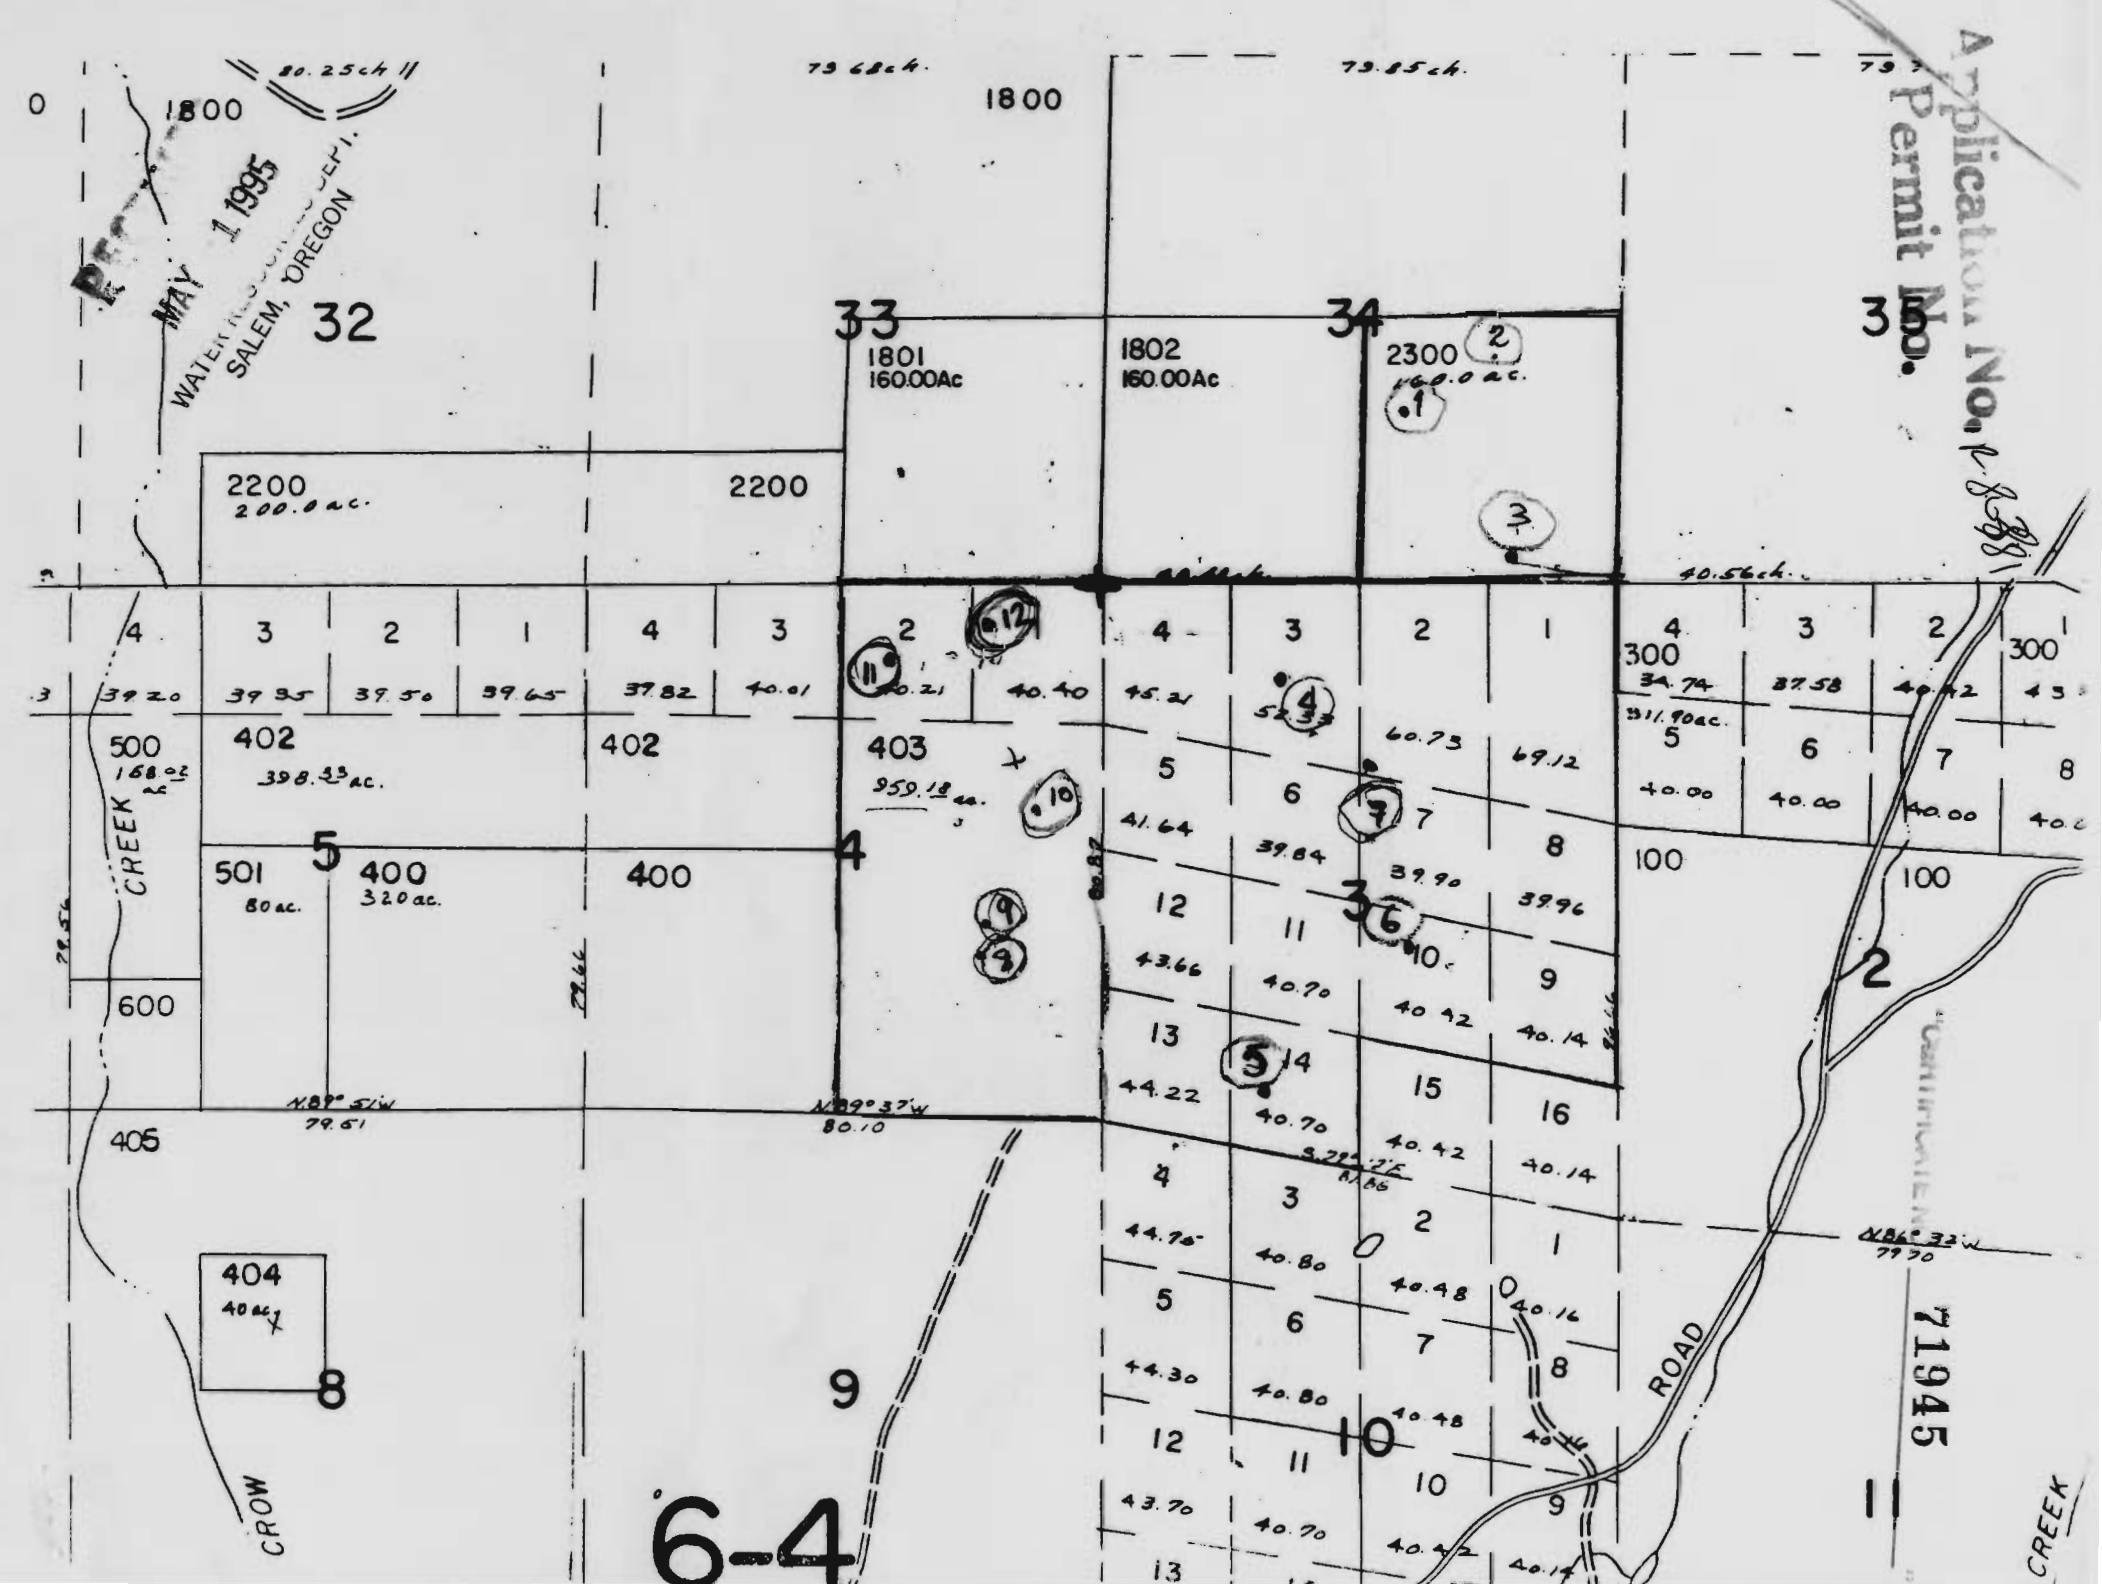
MAY 1 1995
WATER RESOURCES DEPT.
SALEM, OREGON
Application No. R-88881
Permit No.
71945
32
33
34
1800
1801
160.00Ac
1802
160.00Ac
2300
160.0 ac.
2200
200.0 ac.
2200
402
398.33 ac.
402
403
959.18 ac.
500
168.03 ac.
501
80 ac.
400
320 ac.
400
600
405
404
40 ac.
300
311.90 ac.
100
100
CREEK
CROW
CREEK
ROAD
6-4