


71947 Application No. R 80387
" Permit No.

(559)

PLAT/CATENO.

Macneal Matheny D.L.C.
2500
47.4 Ac.

NLY N.E. CORNER
R. MATHENY D.L.C.

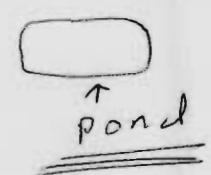

1092.97' 735.67' 11.145'

13.204' S P 8.6'

2300
14.4 Ac.

9.39 ch

N 85° 30' E

536.98' E

LAFAYETTE

5.21 ch

9.18 ch

1430.22' 21.67 ch

Angle Corner
R. Matheny D.L.C.
2200 REF
PTO 5331-100

Ely. N.E. CORNER
R. MATHENY D.L.C.

650 ch

258.78'

881.99'

6.00a

2100
4.5 Ac.

800' x 340'

2000
3.86 Ac.

1900
3.29 Ac.

3348

440' CHURCH RD. (458)

9.10 ch

(O.S.H. 153)

S 35° 30' E 20'

2172.85'

324.2'

1192.65'

C S P 7 6 6 6

SEE SEC. 5 3 31

of bearing or showing...
the company assumes no lia-
bilities, if any, in dimensio-
nations ascertained by actual

4.1

TICOR TITLE INSURANCE (

RECEIVED
JAN - 3 1995
WATER RESOURCES DEP
SALEM, OREGON

YAMHILL COUNTY

SEE MAP 5 3 19


1"=400'

19 | 20
30 | 29

SEE MAP 5 3 29

SEE MAP 5 3 31

SCALE 1:9500

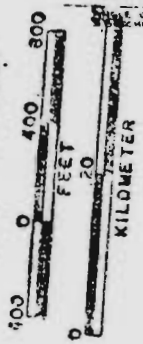

Application No. 1-80387
Permit No.

71947

30 | 31
34 | 32

