


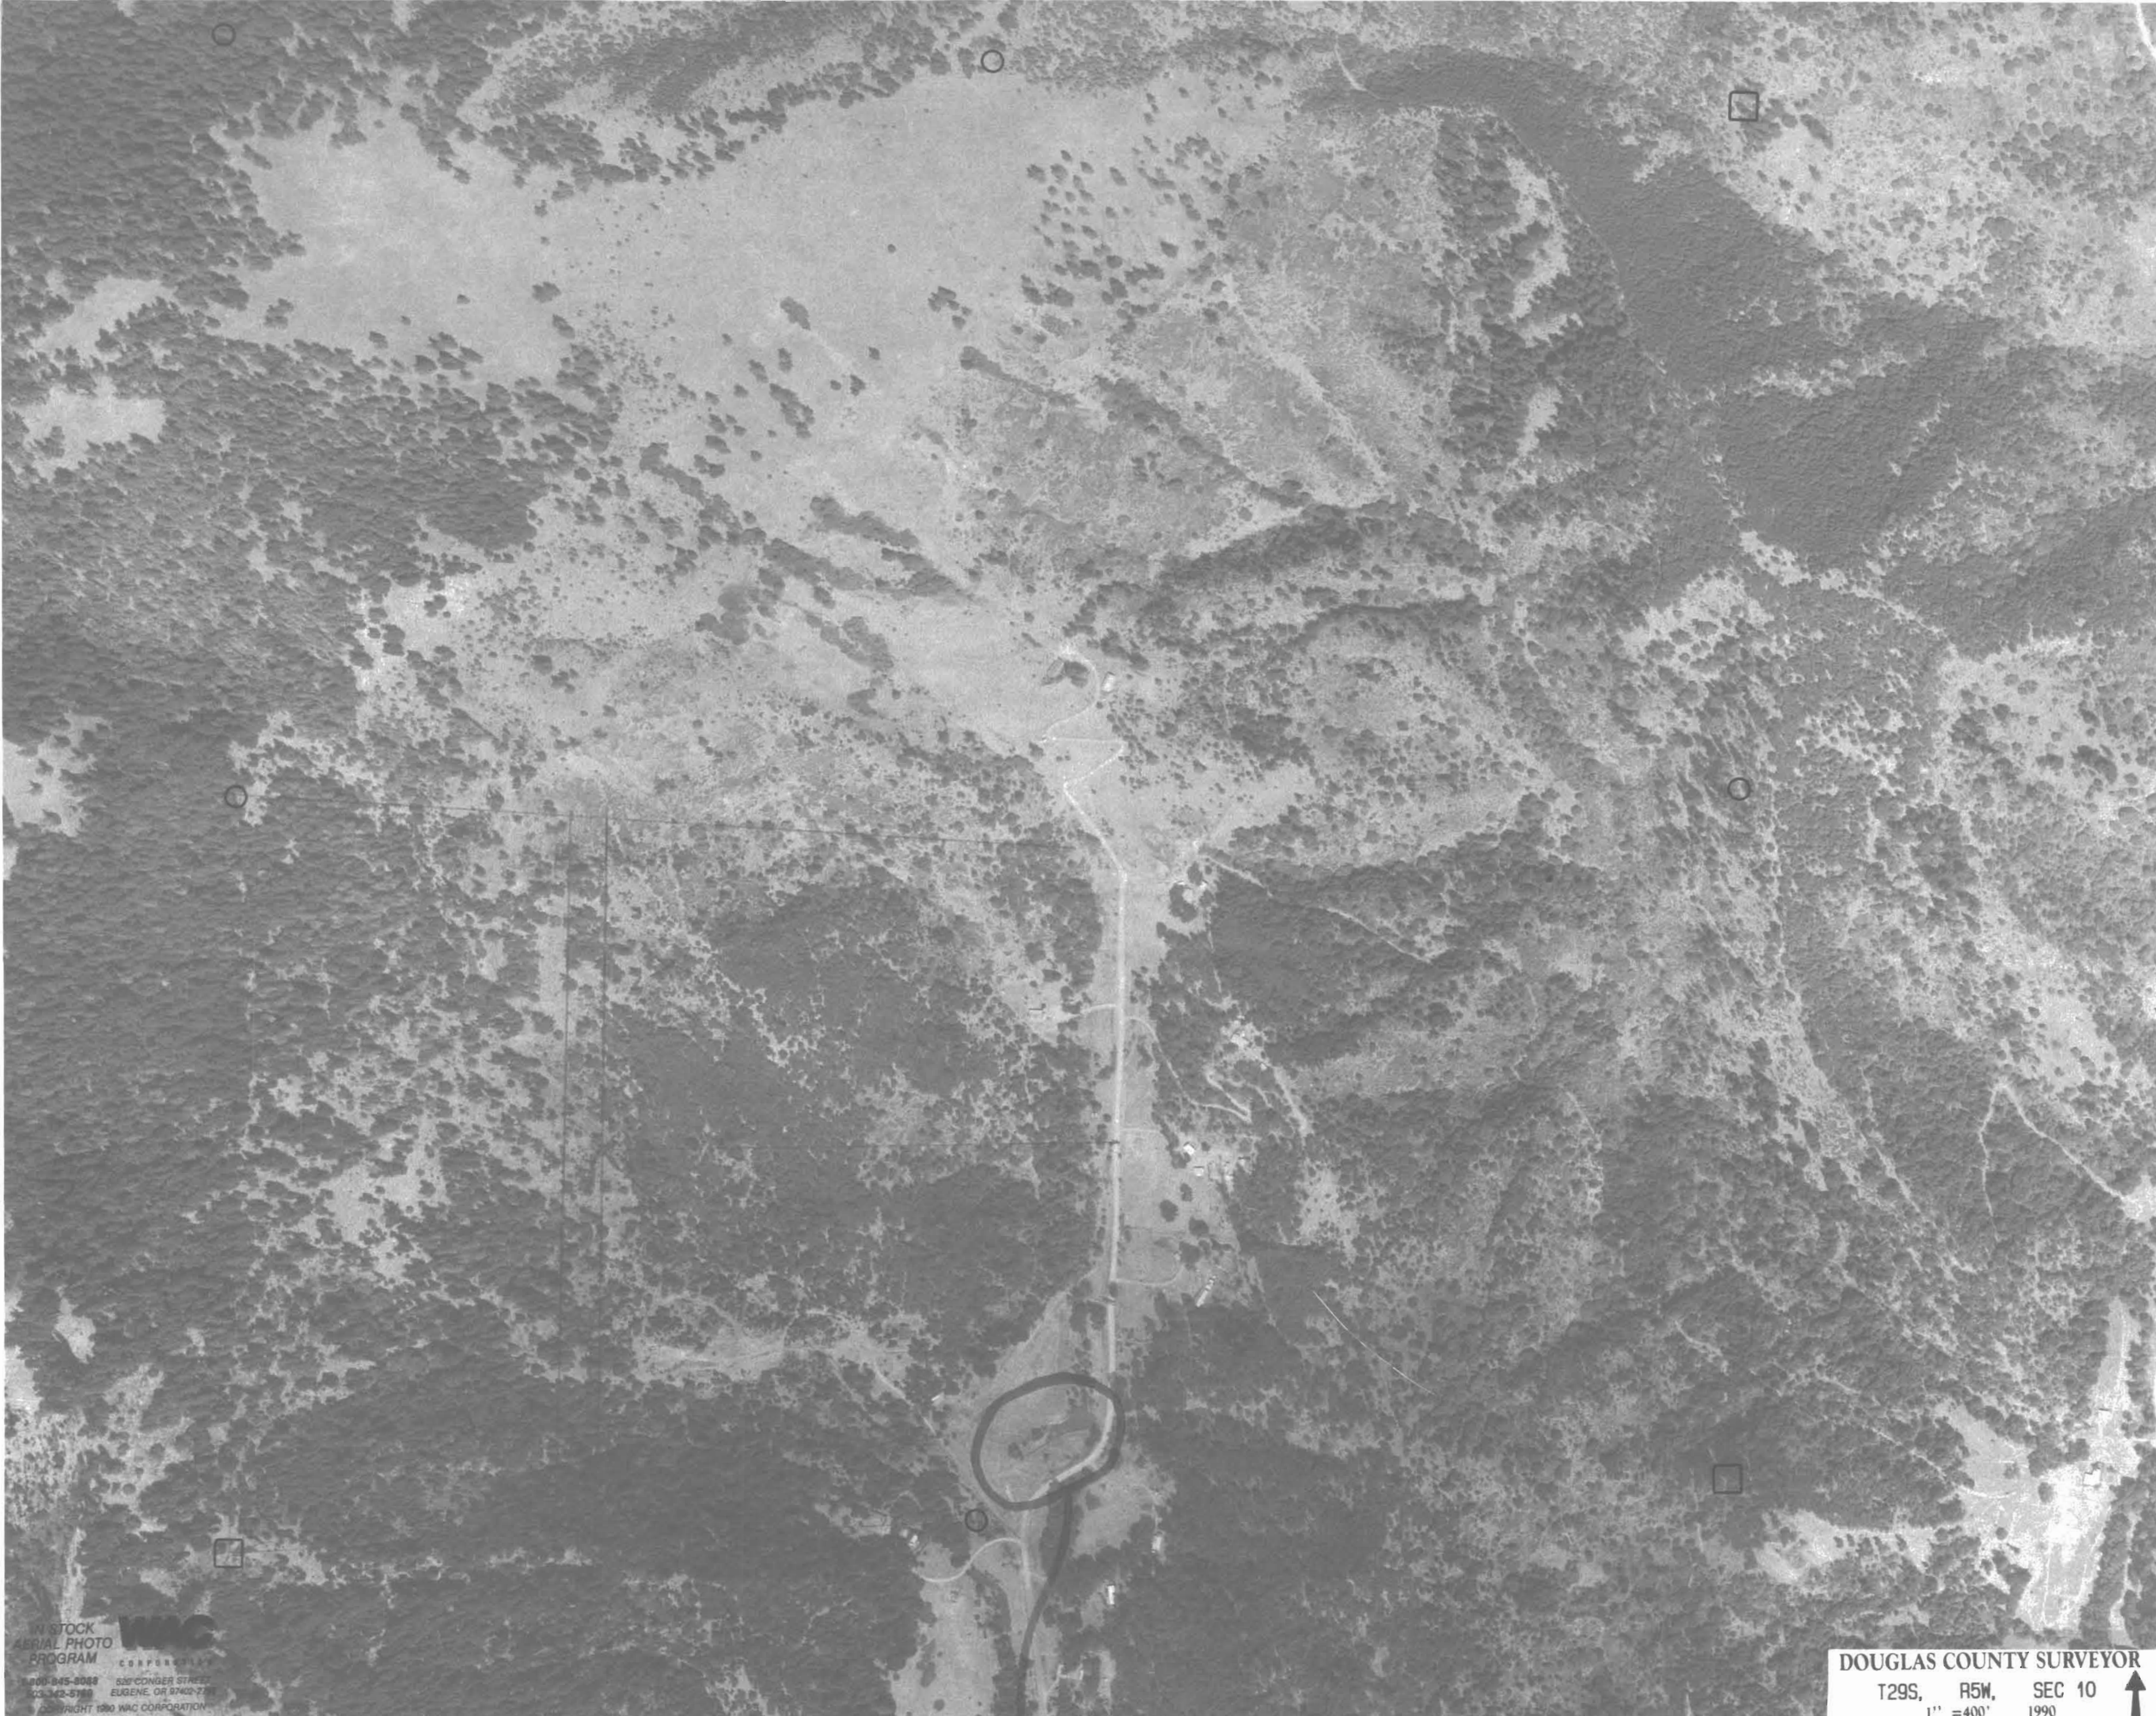

IN STOCK
AERIAL PHOTO
PROGRAM
WAC
CORPORATION
1-800-845-8088
503-742-5788
525 CONGER STREET
EUGENE, OR 97402-2781
COPYRIGHT 1990 WAC CORPORATION

DOUGLAS COUNTY SURVEYOR
T29S, R5W, SEC 10
1" = 400' 1990
Scale & corners are approximate



Application No. R-80388
Permit No.
*CERTIFICATE NO. 71948

Pond JAMES D. THOMAS
1604 SPRING BROOK RD
MYRTLE CREEK, OR
Douglas County
T29S
Range 5
Section 10
JAN - 3 1995
WATER RIGHT
SALEM, OR
James D. Thomas