


RECEIVED

APR 10 1995

12/17/75

WATER RESOURCES DEPT

SALEM, OREGON

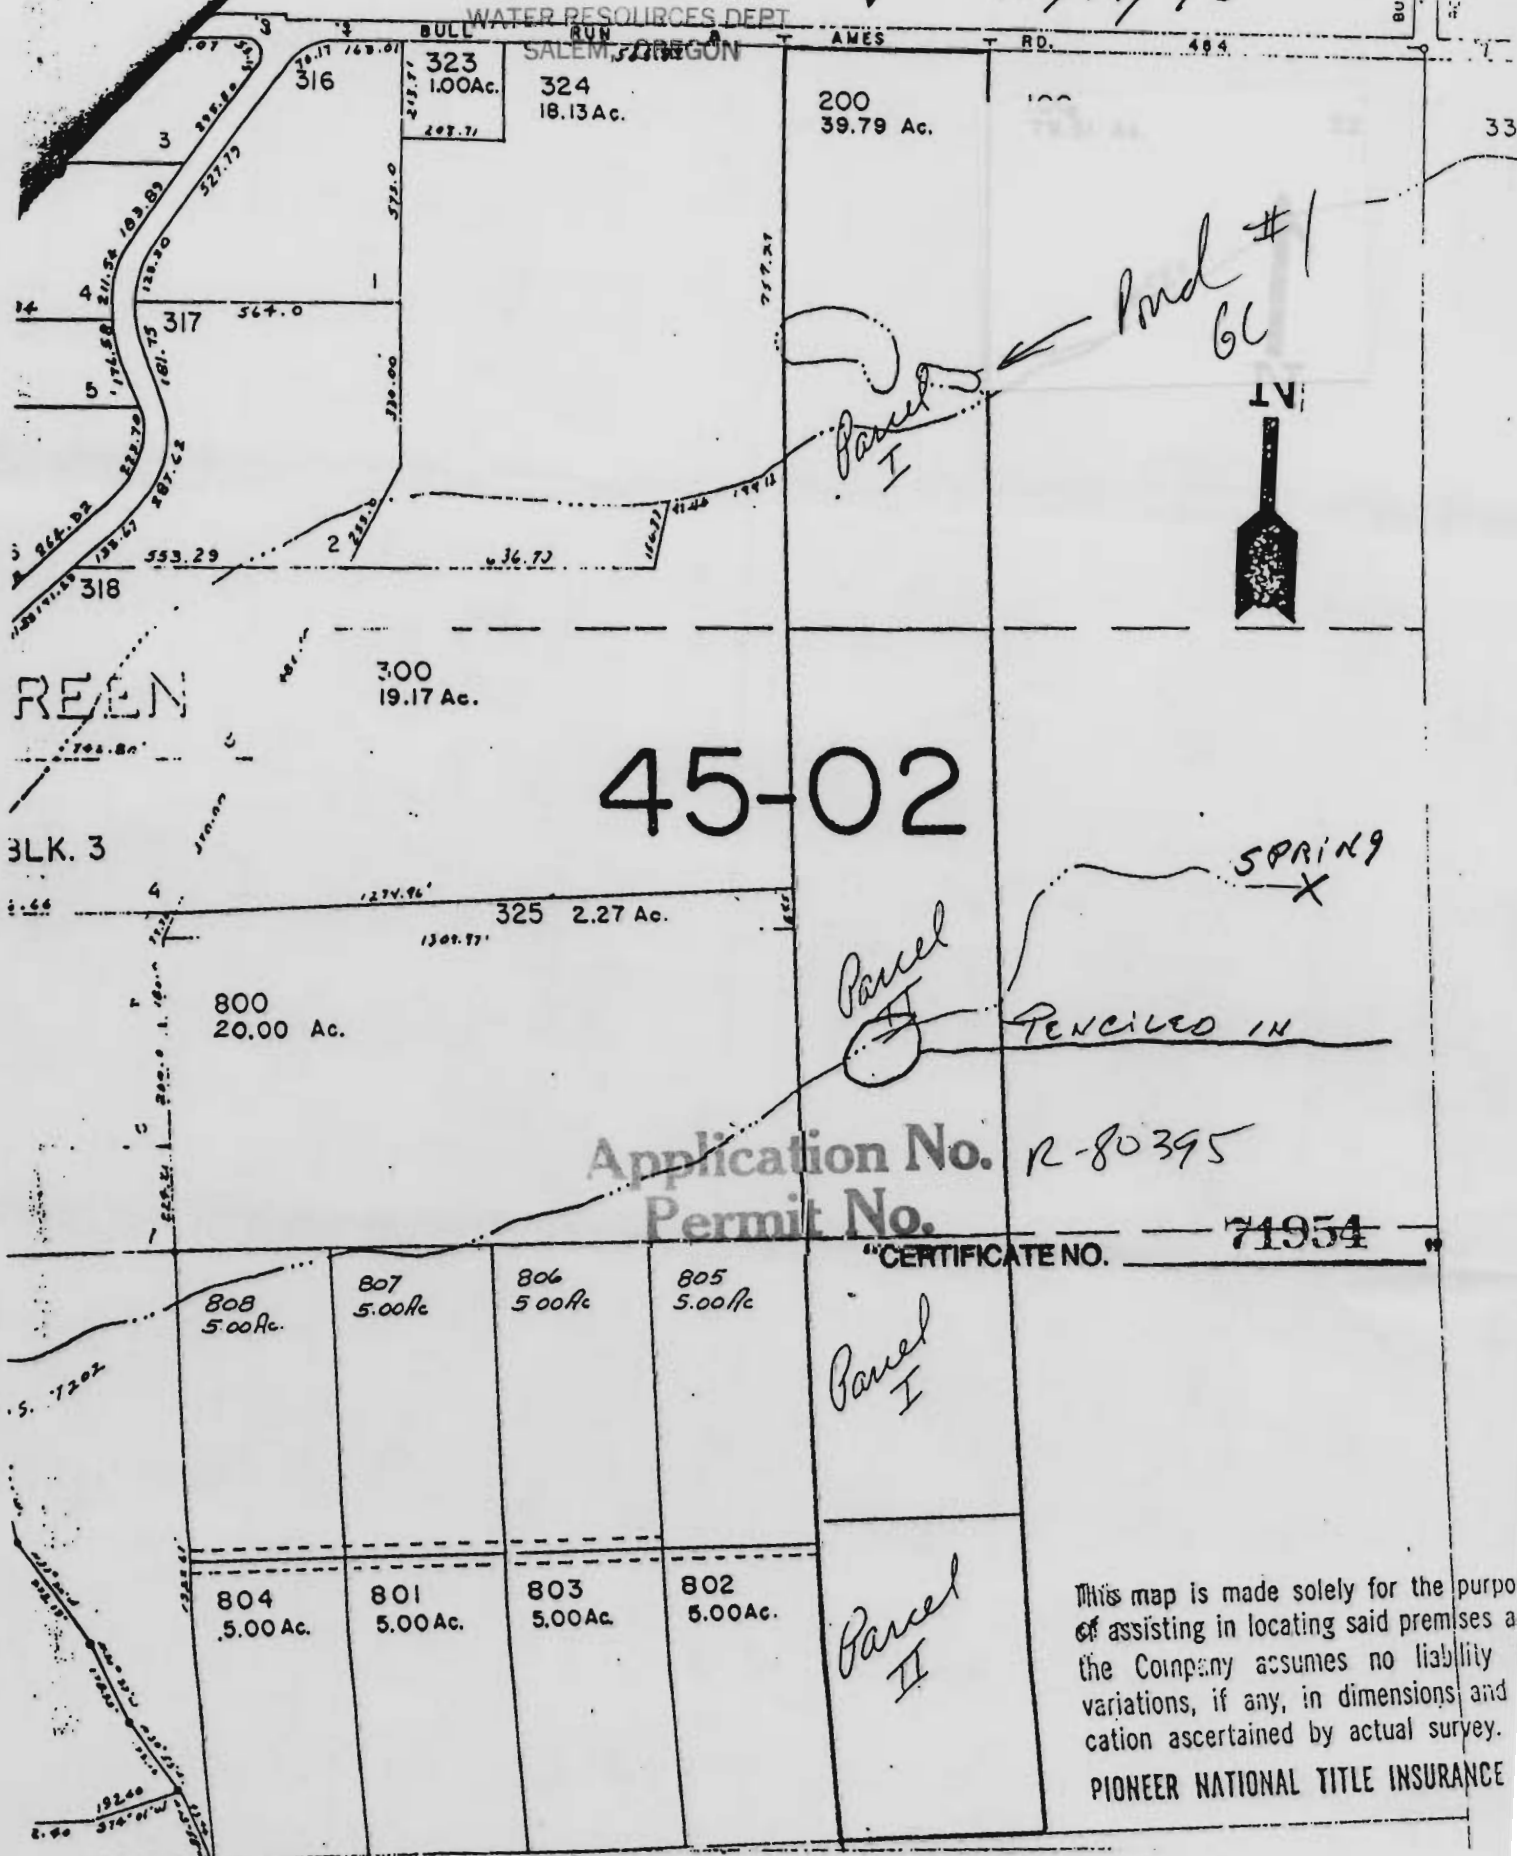

This map is made solely for the purpose of assisting in locating said premises and the Company assumes no liability for variations, if any, in dimensions and location ascertained by actual survey.
PIONEER NATIONAL TITLE INSURANCE