


RECEIVED

JAN - 3 1995

WATER RESOURCES DEPT
SALEM, OREGON

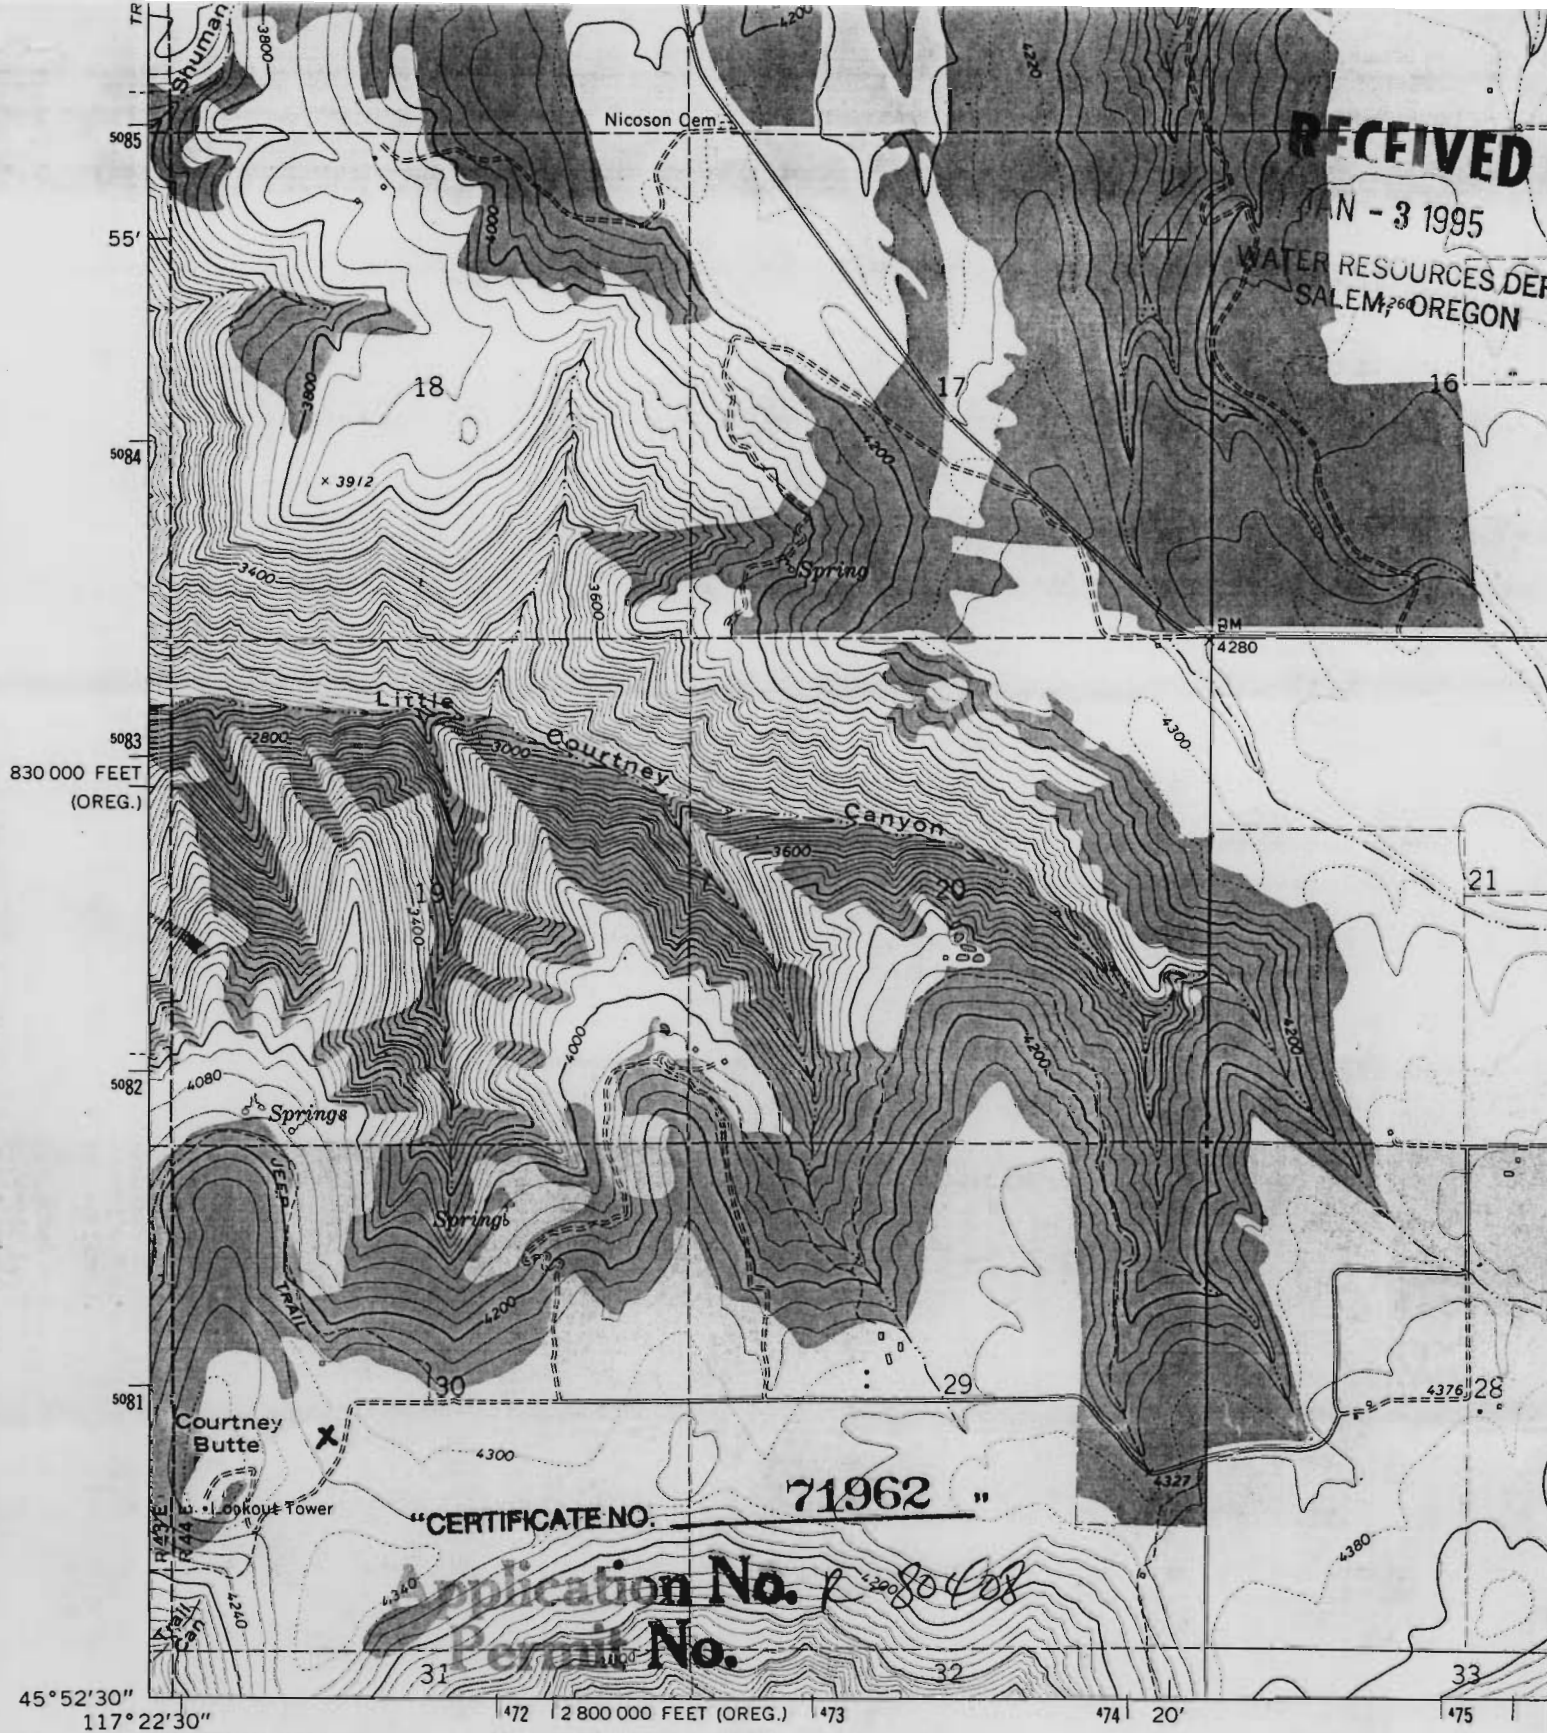



Mapped, edited, and published by the Geological Survey

Control by USGS, USC&GS, and State of Oregon

Topography by photogrammetric methods from aerial photographs taken 1966. Field checked 1967

Polyconic projection. 1927 North American datum
10,000-foot grids based on Oregon coordinate system,
north zone and Washington coordinate system, south zone
1000-meter Universal Transverse Mercator grid ticks,
zone 11, shown in blue

Fine red dashed lines indicate selected fence lines

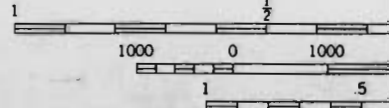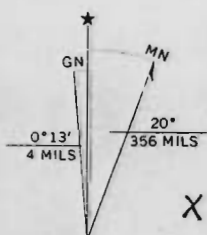

UTM GRID AND 1967 MAGNETIC NORTH DECLINATION AT CENTER OF SHEET

X = Location of pond
TSN-R44-S30
Wallowa County

THIS MAP COMPLIES FOR SALE BY U.S. GEOLOGICAL SURV