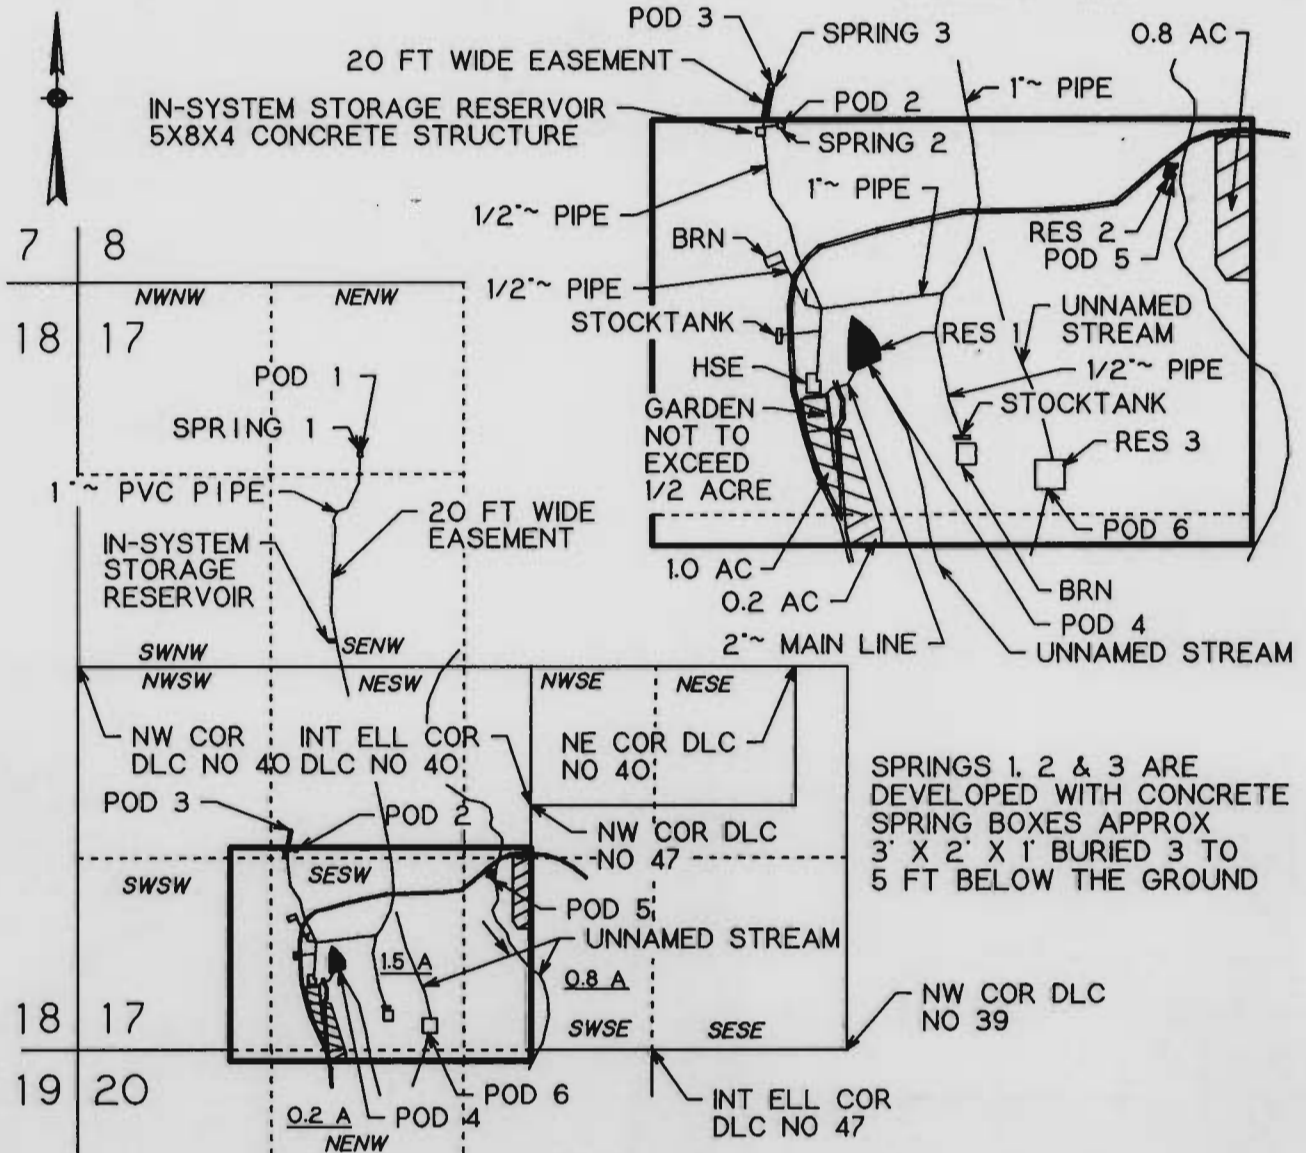



T24S. R4W.WM

DOUGLAS COUNTY
SCALE 1" = 400'DETAIL
SCALE 1" = 660'

SPRINGS 1, 2 & 3 ARE DEVELOPED WITH CONCRETE SPRING BOXES APPROX 3' X 2' X 1' BURIED 3 TO 5 FT BELOW THE GROUND

POD 1 IS 1180 FT S AND 1920 FT E FROM NW COR SEC 17
 POD 2 IS 1360 FT N AND 1480 FT E FROM SW COR SEC 17
 POD 3 IS 1490 FT N AND 1450 FT E FROM SW COR SEC 17
 POD 4 IS 550 FT N AND 1780 FT E FROM SW COR SEC 17
 POD 5 IS 1180 FT N AND 2830 FT E FROM SW COR SEC 17
 POD 6 IS 120 FT N AND 2400 FT E FROM SW COR SEC 17

THIS IS A WATER RIGHT APPLICATION BY LEON C. OR CAROLYN S. YOUNG. THIS MAP IS FOR THE PURPOSE OF IDENTIFYING THE LOCATION OF THE WATER RIGHT ONLY AND IS NOT INTENDED TO PROVIDE LEGAL DIMENSIONS OR LOCATIONS OF PROPERTY OWNERSHIP LINES.

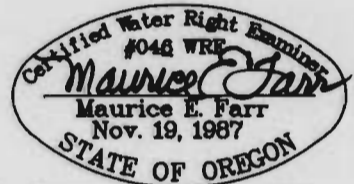

EXPIRES 12-31-95

Application No. R-80415

Permit No.

"CERTIFICATE NO. 71963"