



TOWNSHIP 15 SOUTH, RANGE 6 WEST, W.M.

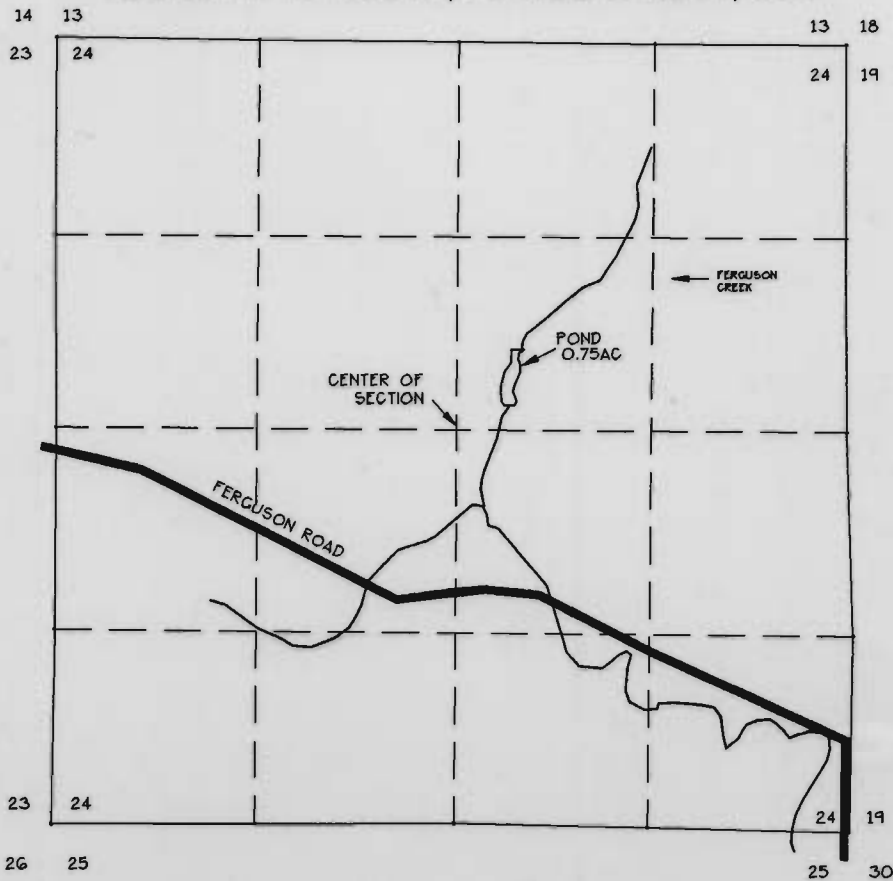

POND LOCATION:
160.5 FEET NORTH +
390.54 FEET EAST OF
THE CENTER OF SECTION 24.

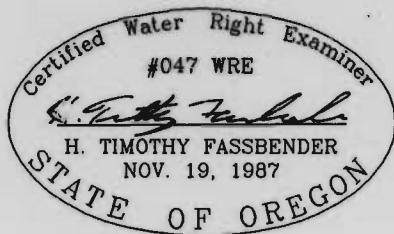

POND FINAL PROOF MAP
FOR
CHRIS SHOWN
25166 FERGUSON ROAD
JUNCTION CITY, OR 97448
PH (503) 998-8708
BY
FORD-NESS-FASSBENDER
1120 BAILEY HILL ROAD #1
EUGENE, OR 97402
PH (503) 344-1852
DECEMBER 18, 1994

NOTE:
THIS MAP WAS PREPARED FOR THE
PURPOSE OF IDENTIFYING THE LOCATION
OF THE WATER RIGHT ONLY. IT IS NOT
INTENDED TO PROVIDE DIMENSIONS OR
LOCATION OF PROPERTY OWNERSHIP LINES.

Application No.
Permit No.

R-80417

JOB NO. 3021
DWG NO. JC3021.DWG

CERTIFICATE NO.

71969