JUN - 7 1995
WATER RESOURCES DEPARTMENT
SALEM, OREGON

Application No. R 80421
Permit No. 71973
"CERTIFICATE NO. "
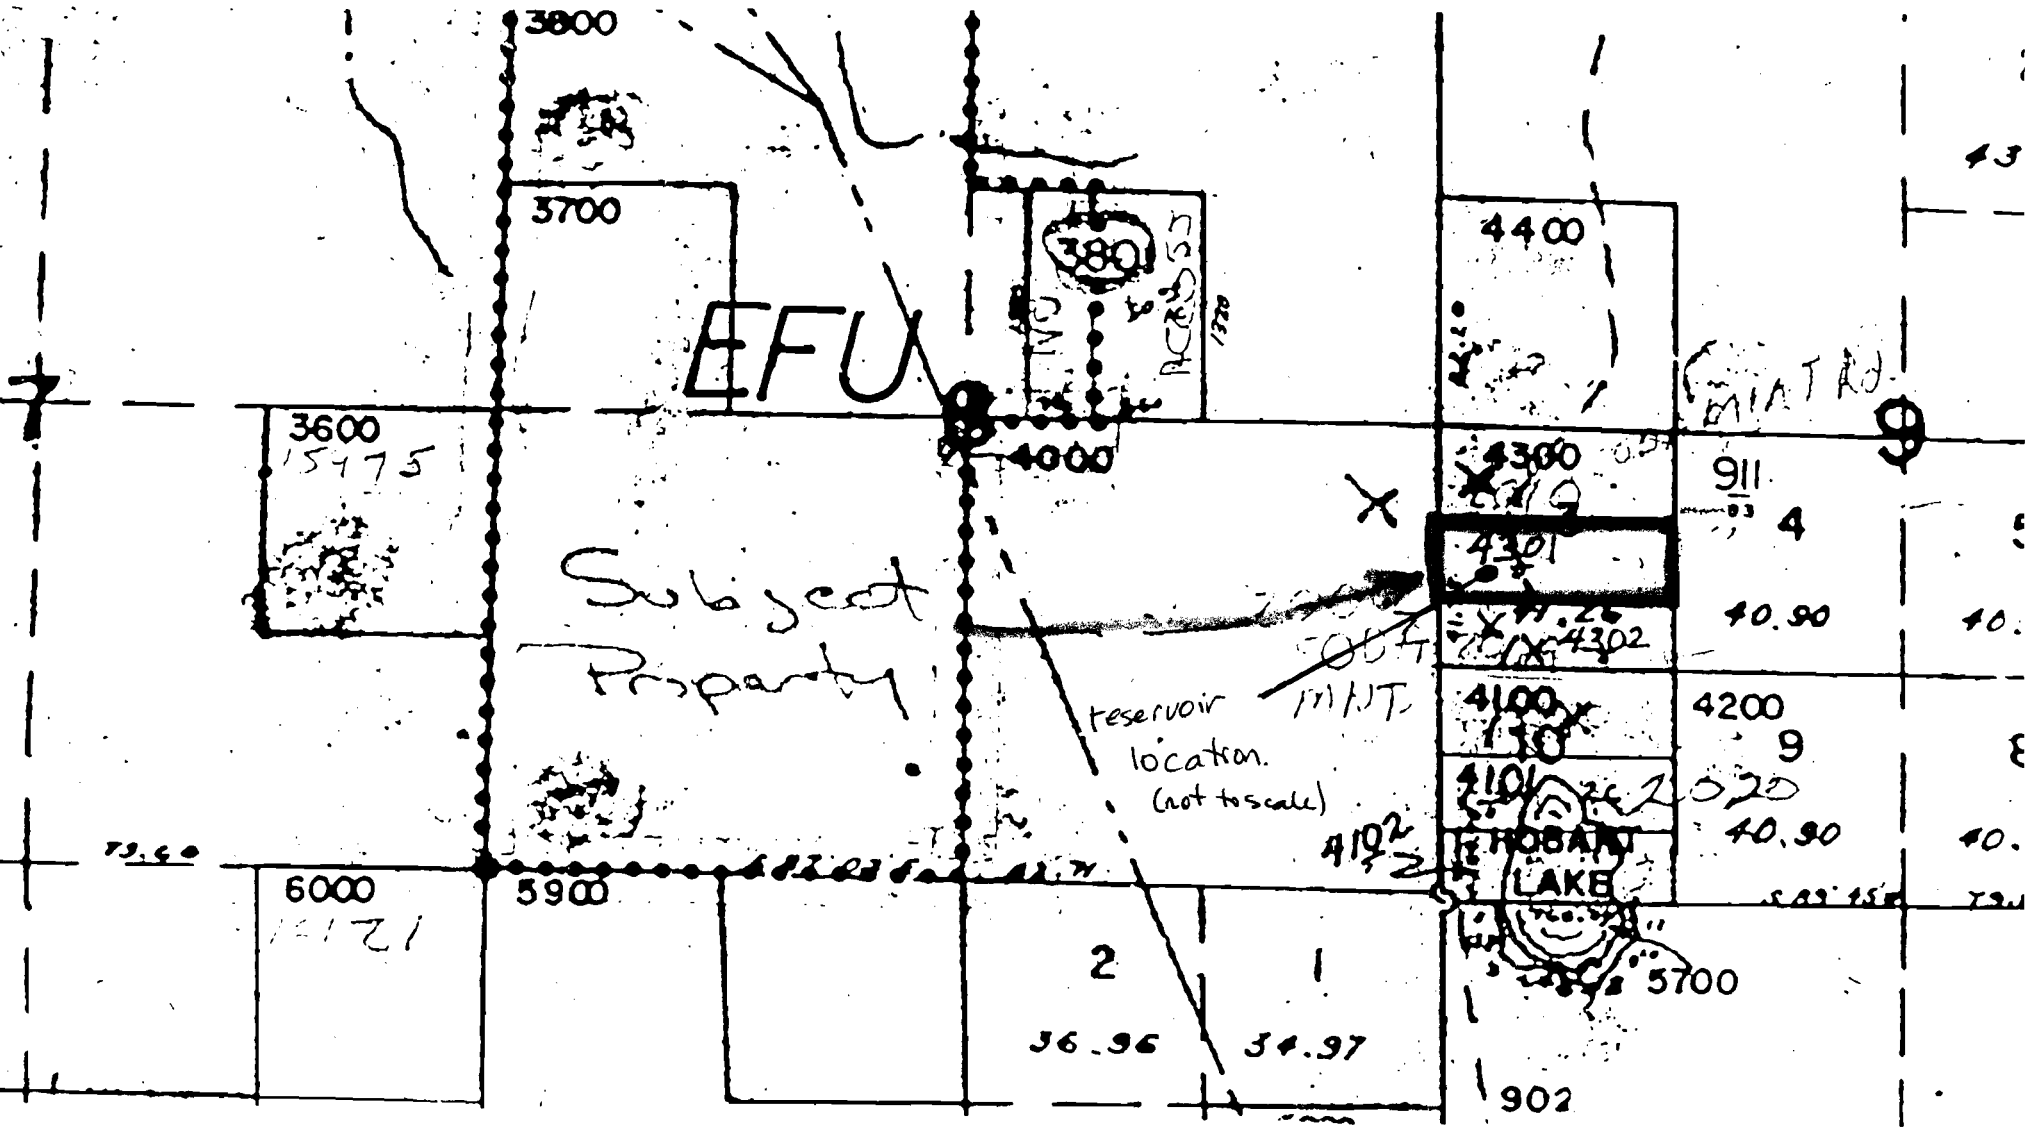
T. 40S R 3E WM
Map 39 3E