


(GALES CREEK)
1375 II SW

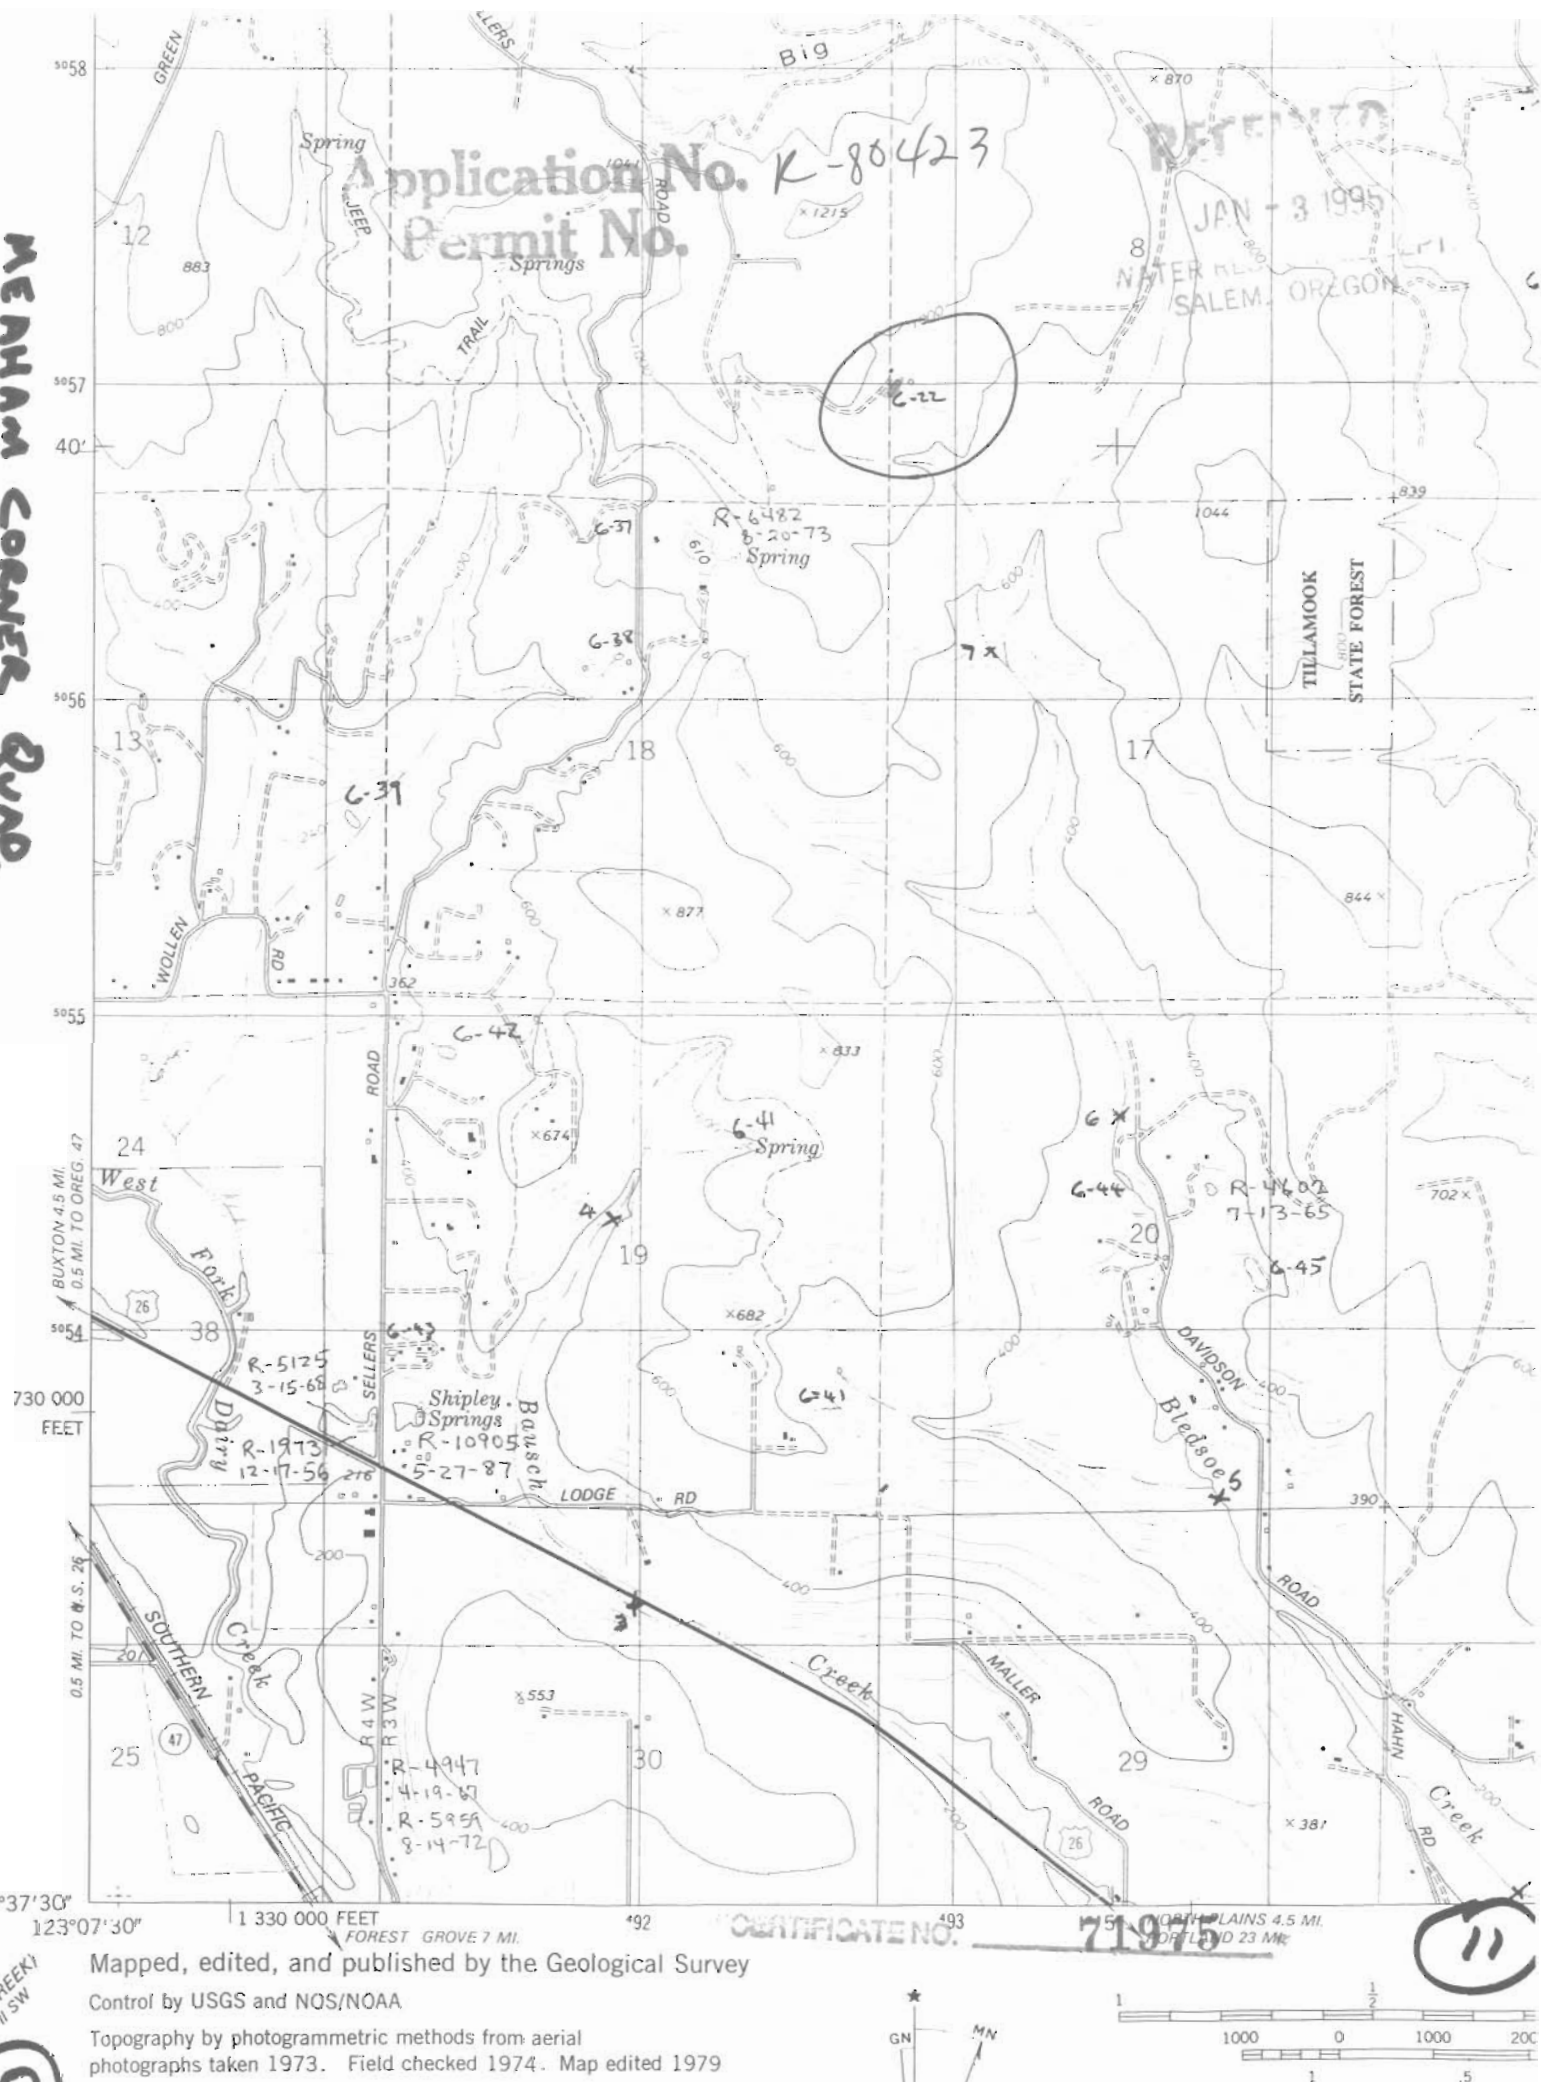

71975

No. R-8423

SEE MAP
2N 3 8

FOR ASSESSMEN
PURPOSES ONLY
DO NOT RELY O
FOR ANY OTHER

LOT 2 39.39

1/4
COR.

1/4
COR.

400
60.73 Ac

900
76.33 Ac.

VISION RIDGE LANE			
1101 2.00 Ac	1100 2.00 Ac	1104 2.67 Ac	1105 22.20 Ac
581.0	581.0		
150			

LOT 3 41.14

500
19.22 Ac

13-11 AND OR 13-14

600
41.14 Ac

700
35.80 Ac

LOT 4 41.14

7

1352.7

1315.1

617

232

18

SEE MAP
2N 3 18

2N 3 7

2N