


SECTION 13 T35S R1E WM
SCALE 1"=400'

THIS MAP IS NOT
& THAT THE

35 1E 13
JACKSON
35 1E 13

SCALE 1"=9600'

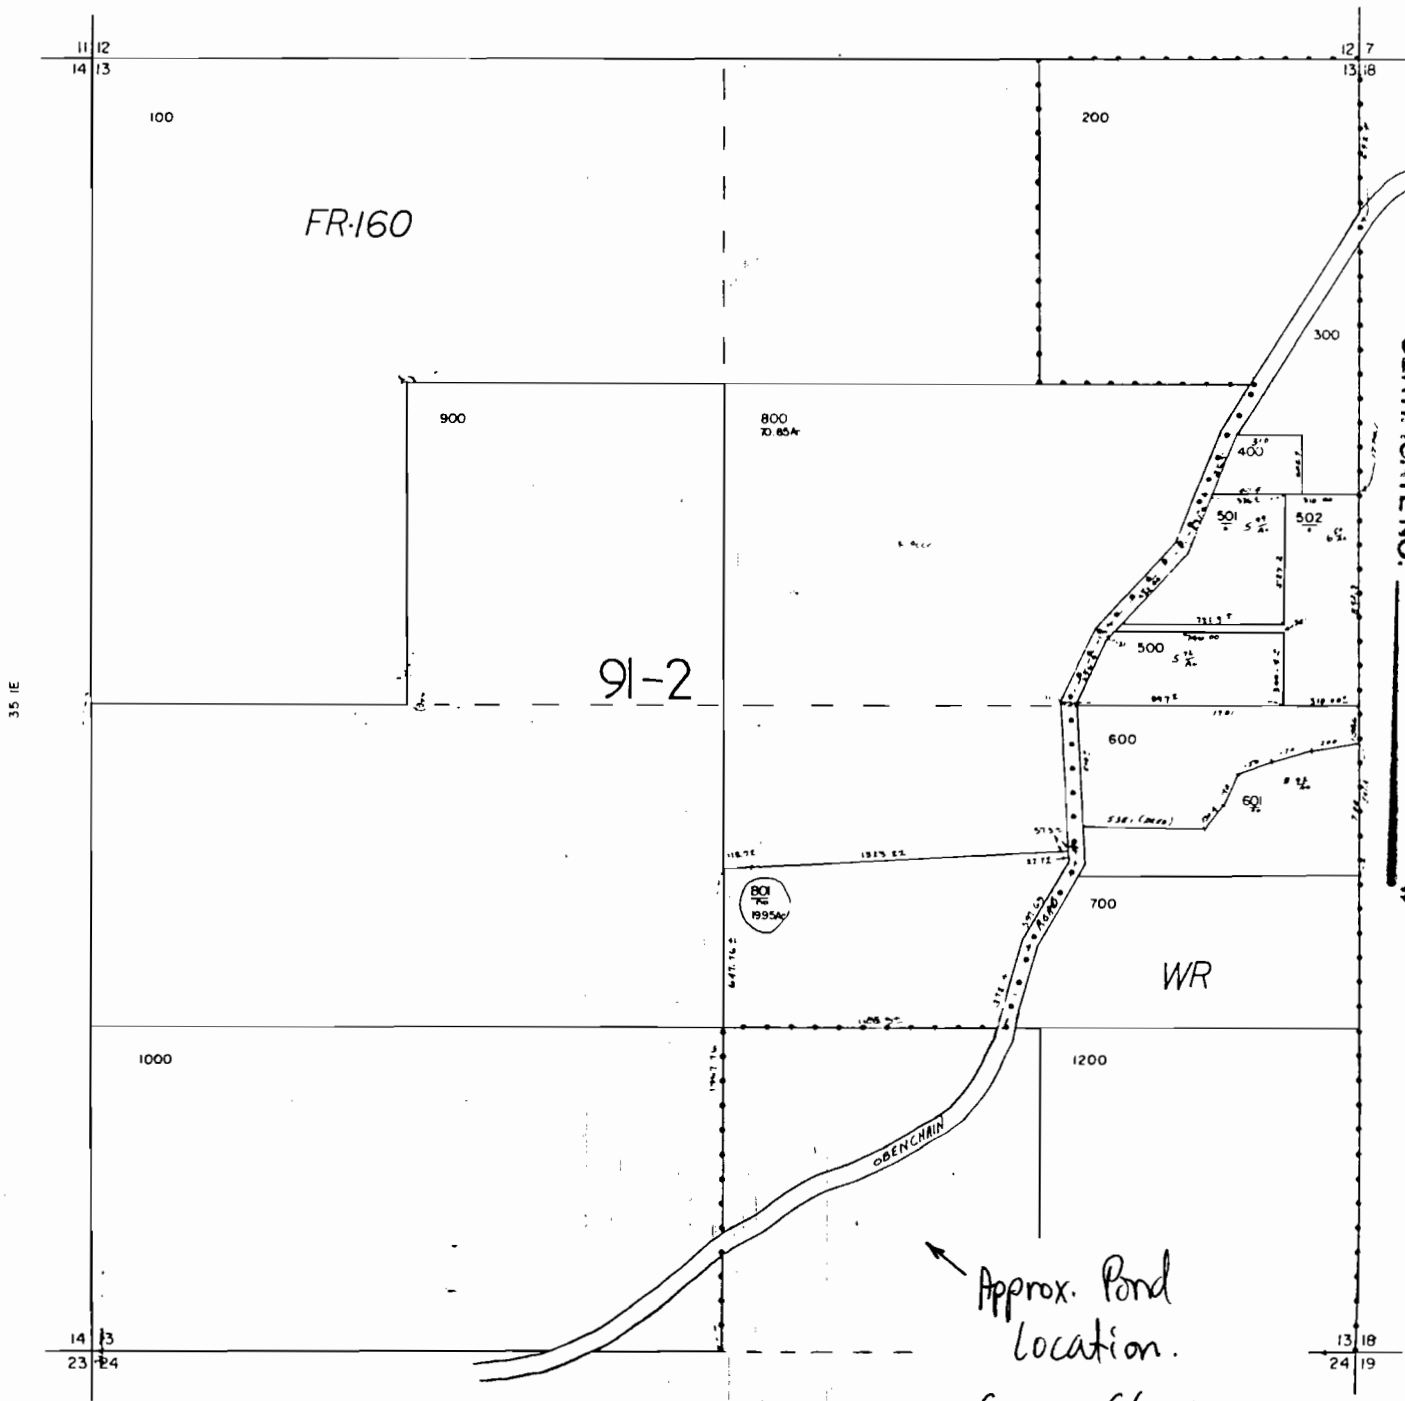

"CERTIFICATE NO. 71976"

10. 128424

Approx. Pond location.
Gerry Clark

RECEIVED
JUN 7 1990
DEPT. OF REVENUE STATE OF OREGON
ASSESSMENT & APPRAISAL DIV.