


UNITED STATES
DEPARTMENT OF THE INTERIOR
GEOLOGICAL SURVEY



CRICKET FLAT QUADRANGLE
OREGON-UNION CO.
7.5 MINUTE SERIES (TOPOGRAPHIC)

Application No. *P-80430*
Permit No.

71982

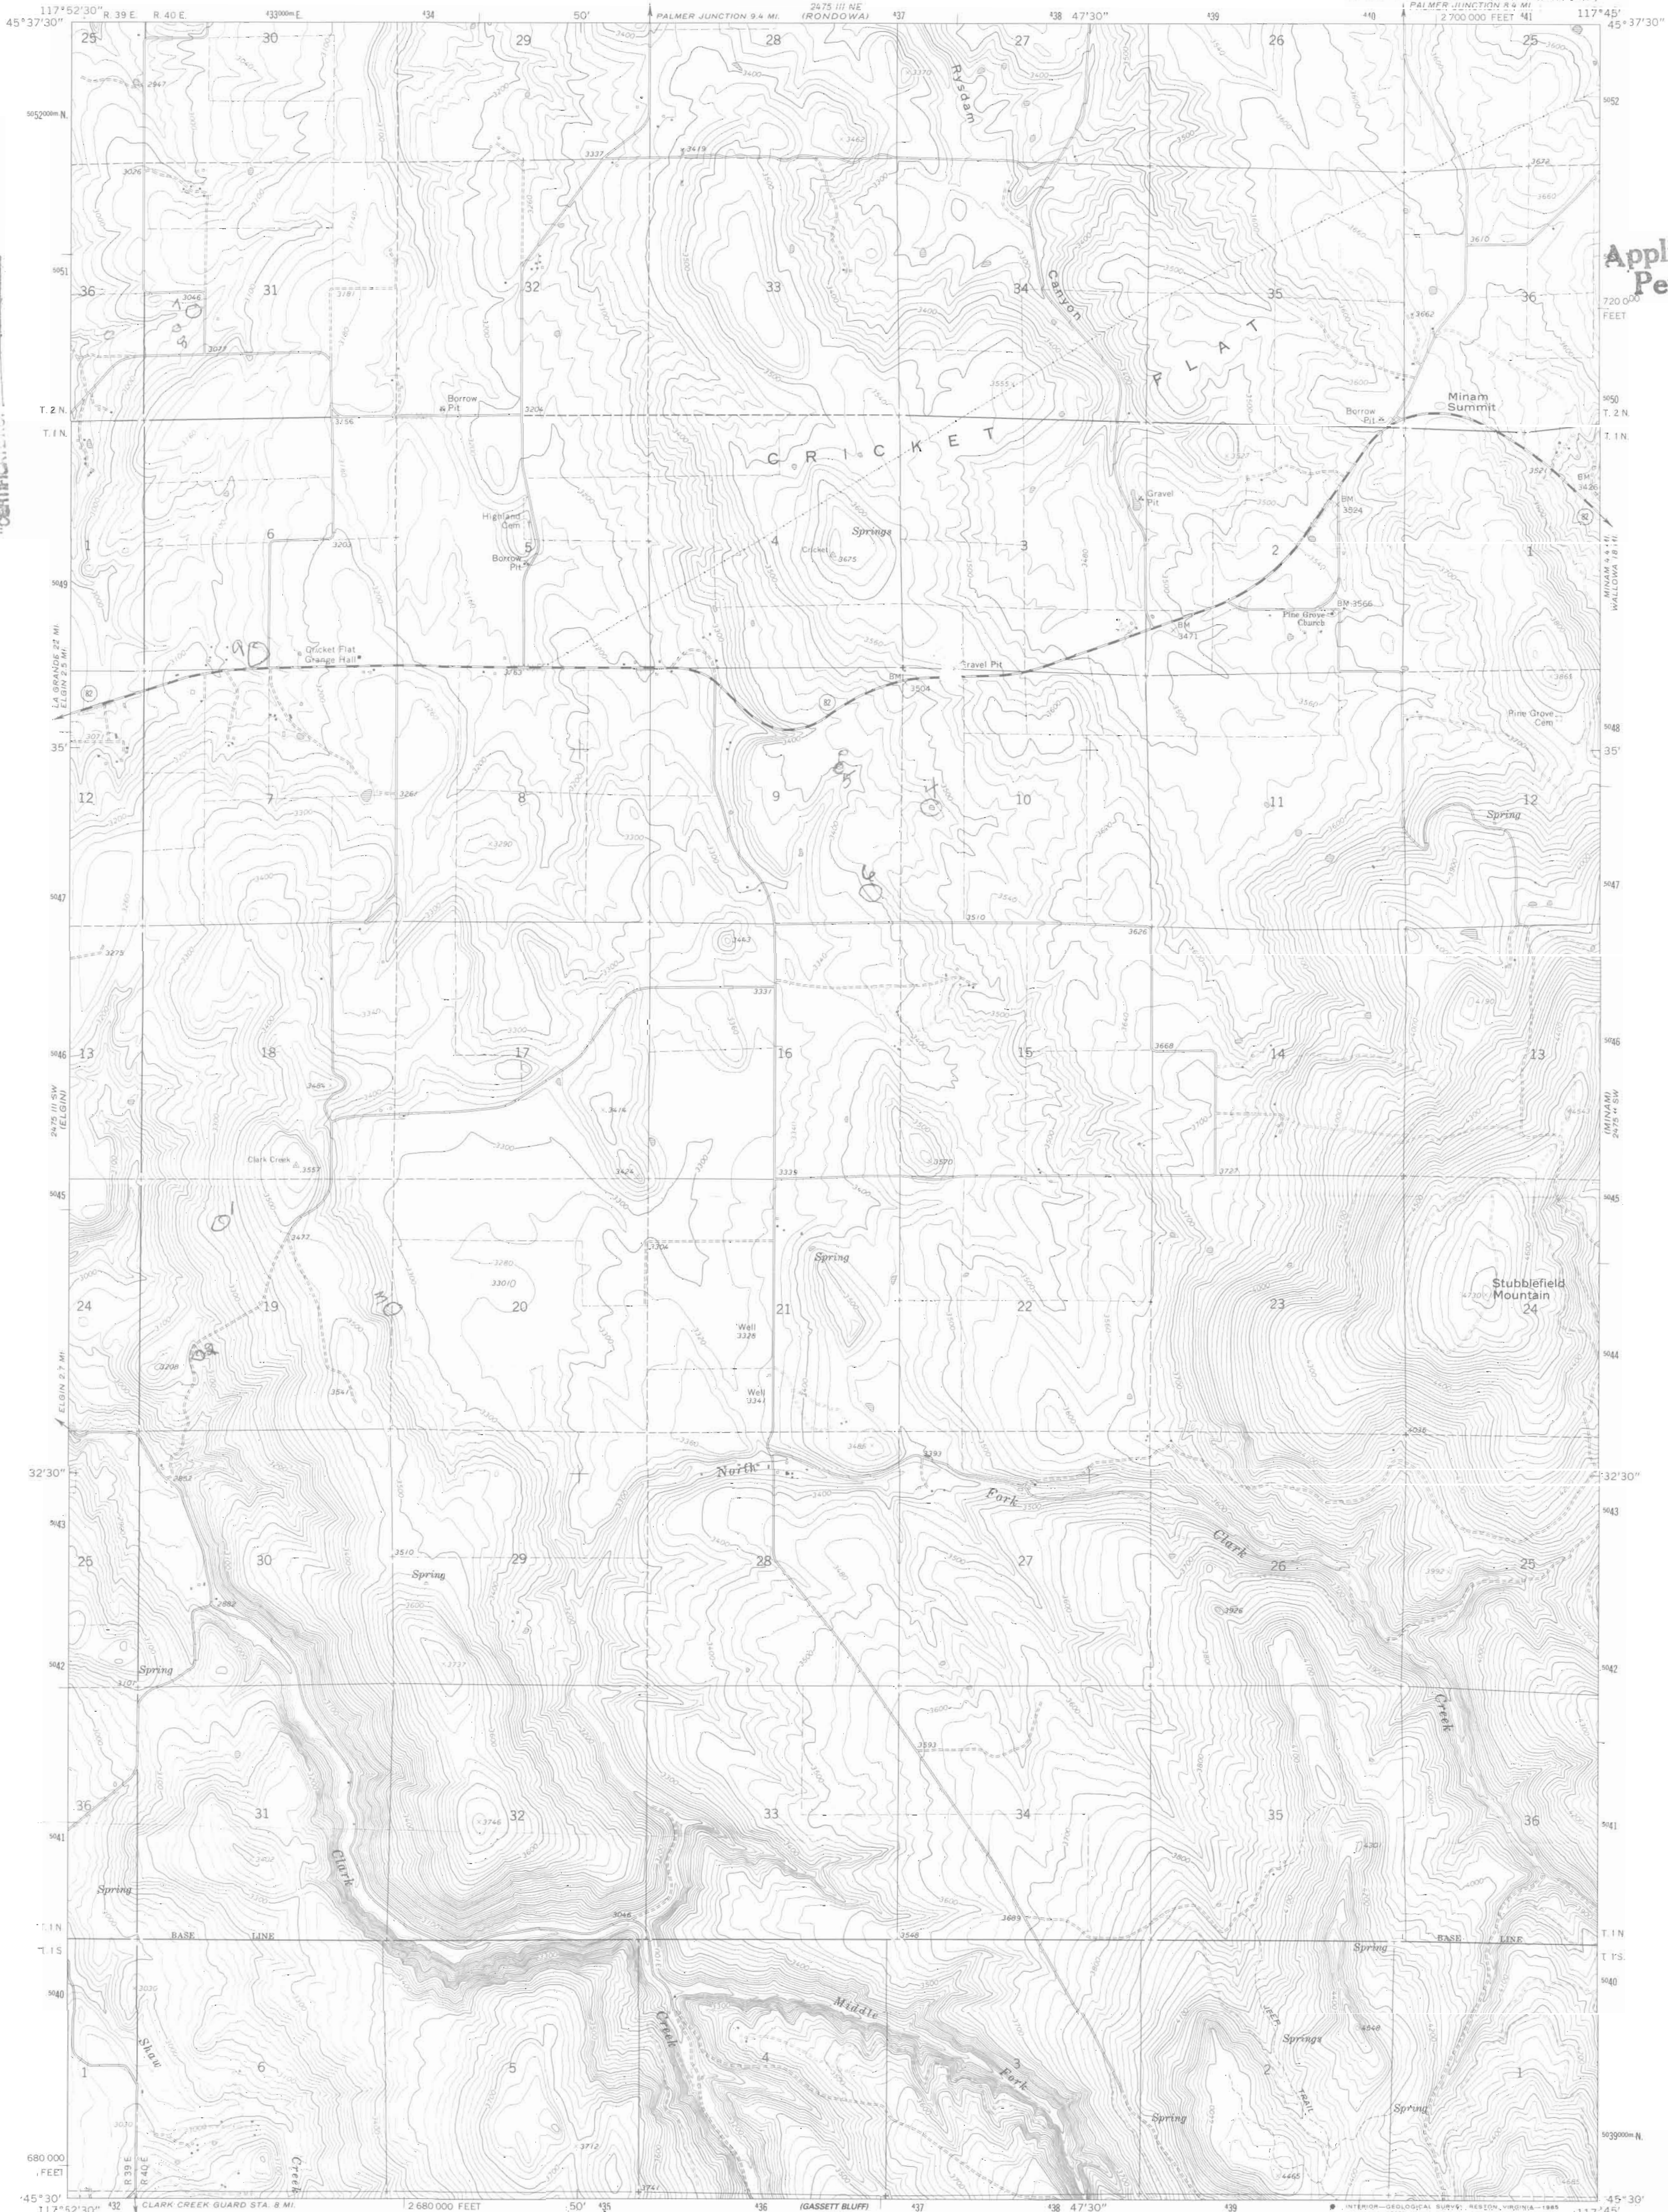

Maped, edited, and published by the Geological Survey
Control by USGS and NOS/NOAA
Topography by photogrammetric methods from aerial
photographs taken 1959. Field checked 1964
Polyconic projection: 1927 North American datum
10,000-foot grid based on Oregon coordinate system,
north zone
1000-meter Universal Transverse Mercator grid ticks,
zone 11, shown in blue
To place on the predicted North American Datum 1983
move the projection lines 17 meters north and
80 meters east as shown by dashed corner ticks
Fine red dashed lines indicate selected fence lines

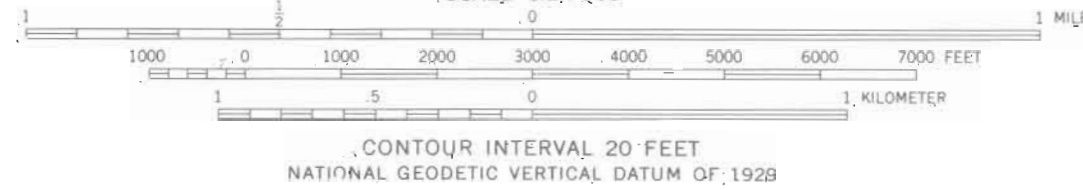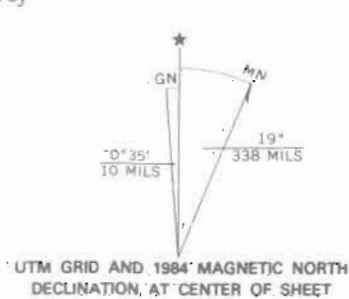

ROAD CLASSIFICATION
Medium-duty ——— Light-duty ———
Unimproved dirt ———
State Route

CRICKET FLAT, OREG.
4517-E7-TF-024

THIS MAP COMPLIES WITH NATIONAL MAP ACCURACY STANDARDS
FOR SALE BY U.S. GEOLOGICAL SURVEY, DENVER, COLORADO 80225, OR RESTON, VIRGINIA
A FOLDER DESCRIBING TOPOGRAPHIC MAPS AND SYMBOLS IS AVAILABLE ON REQUEST

Revision shown in purple and woodland compiled from
aerial photographs taken 1981 and other sources
Partial field check by U.S. Forest Service. Map edited 1984

1964
PHOTOREVISED 1984
DMA 2475 III SE-SERIES V892