



T9S, R26E

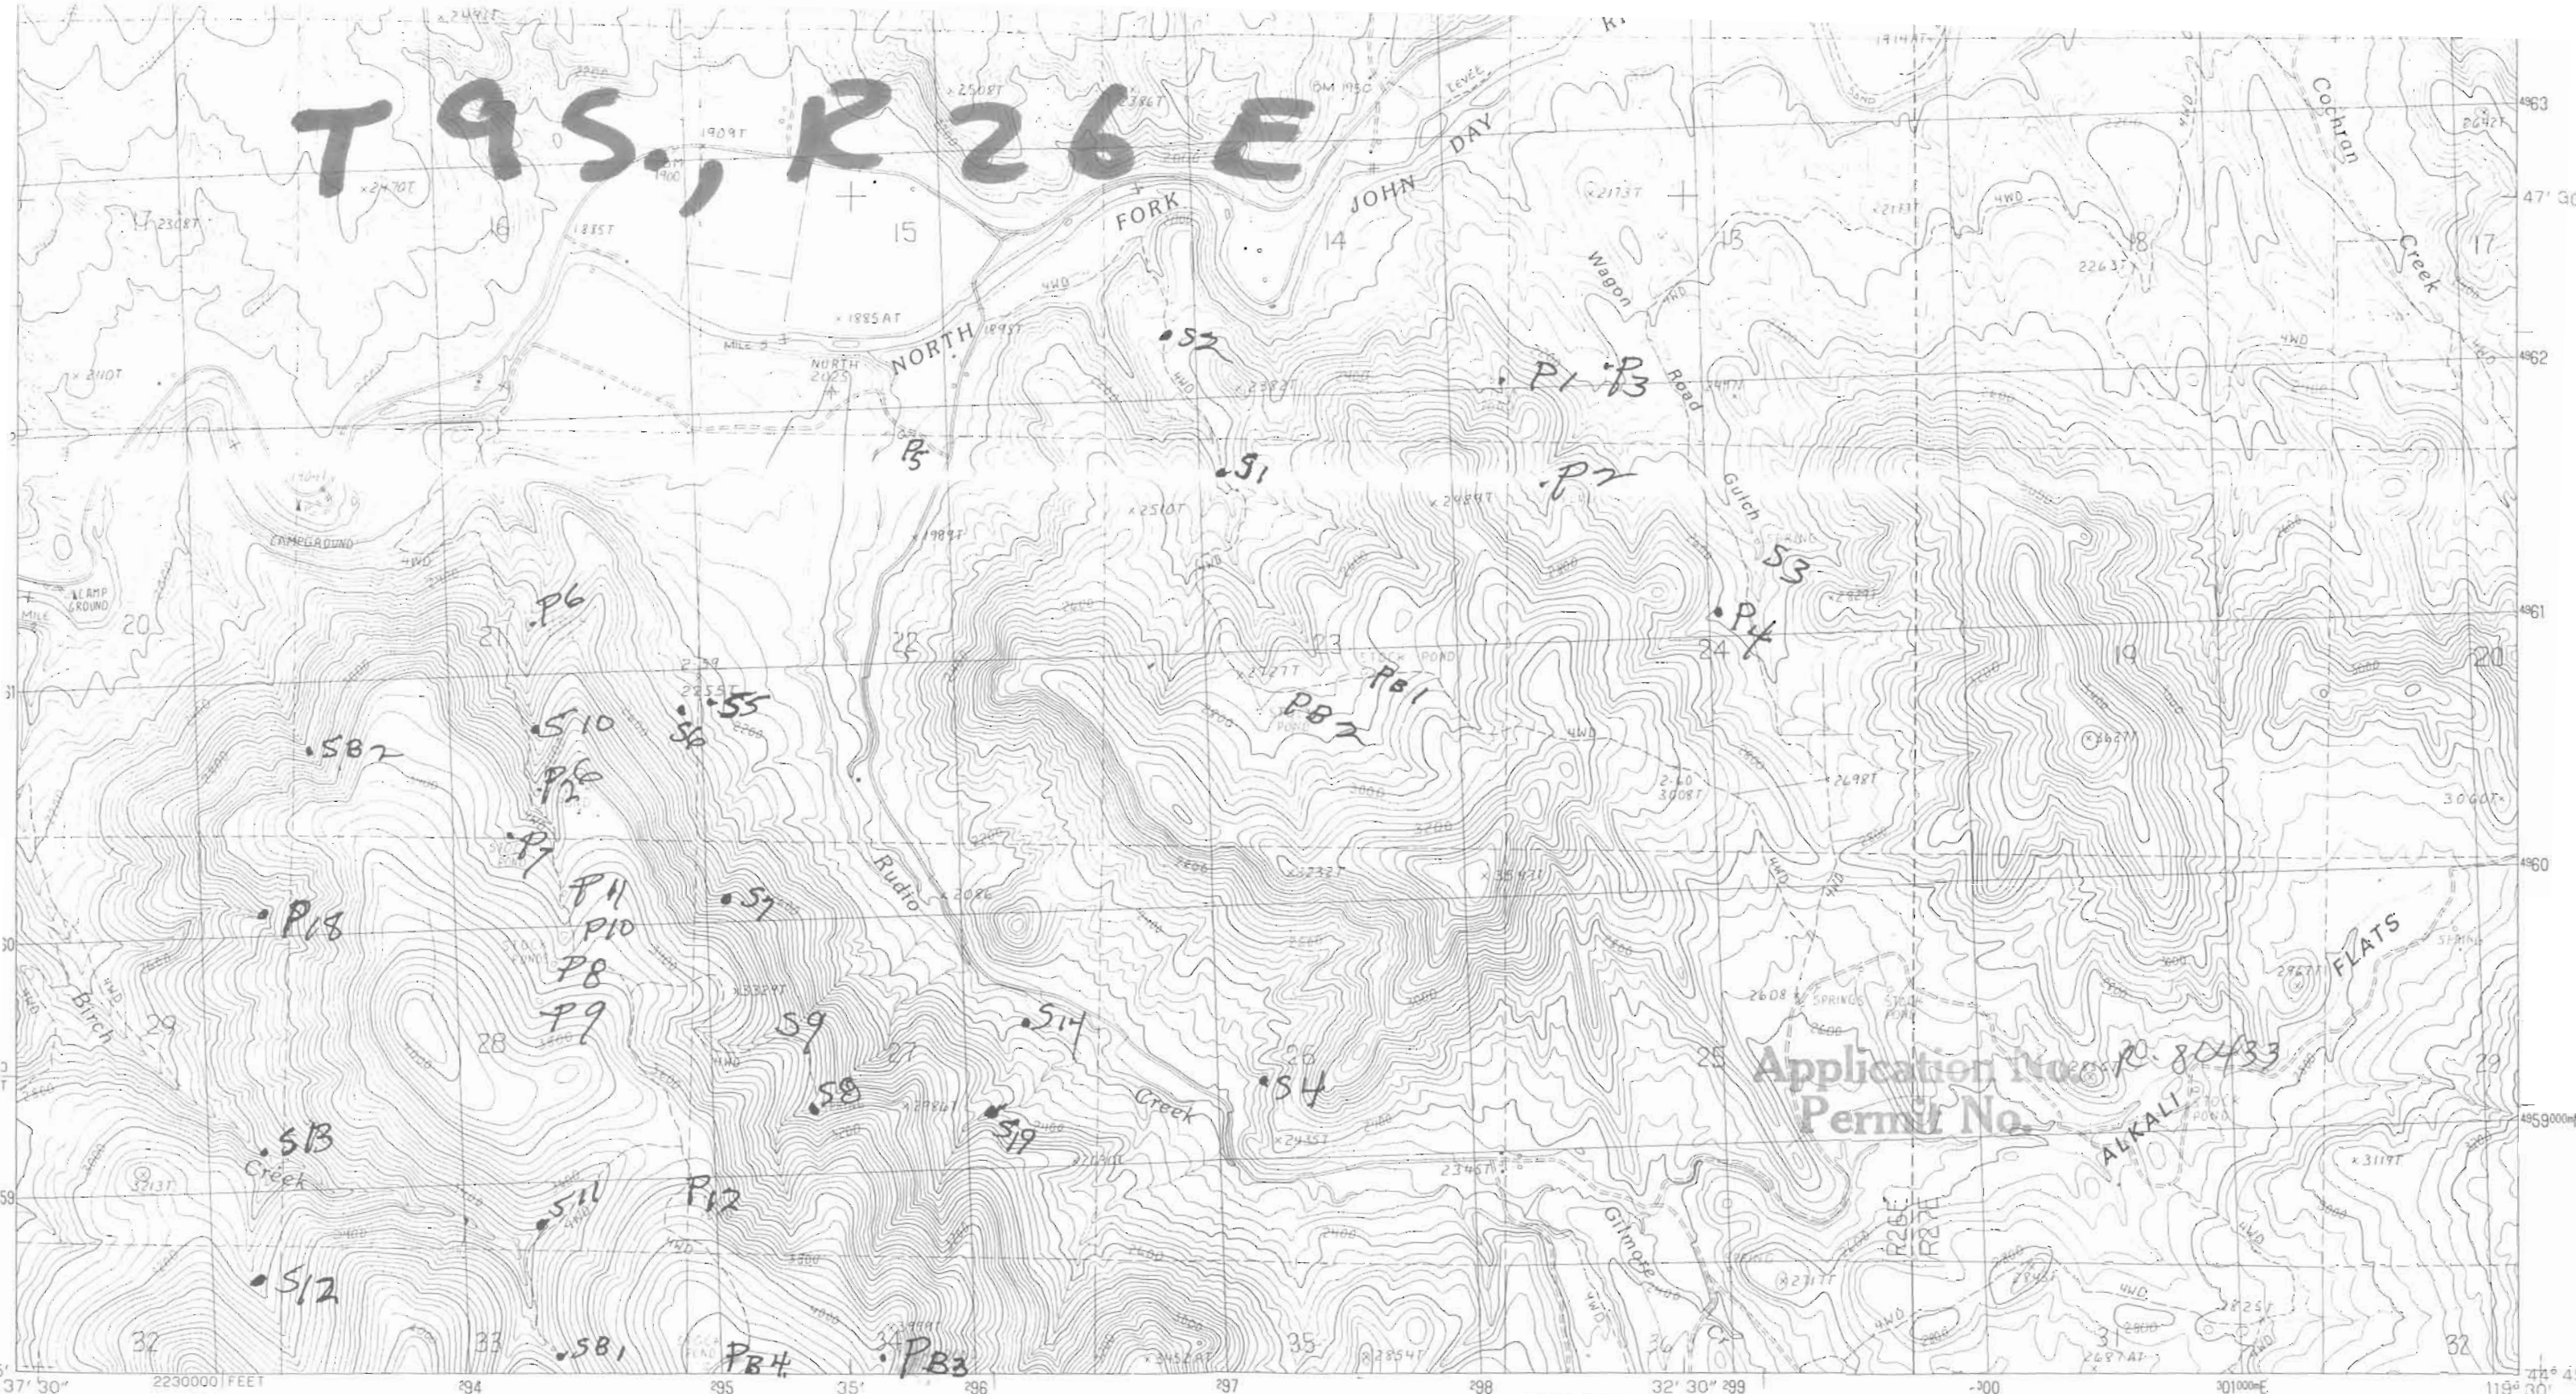

PRODUCED BY THE UNITED STATES GEOLOGICAL SURVEY
 COL BY: USGS AND NOS/NOAA
 ED FROM AERIAL PHOTOGRAPHS TAKEN: 1984
 CHECKED: 1987. MAP EDITED: 1990
 CTION: LAMBERT CONFORMAL CONIC
 000-METER UNIVERSAL TRANSVERSE MERCATOR: ZONE 11
 0,000-FOOT STATE GRID TICKS: OREGON, NORTH ZONE
 RID DECLINATION: 1°48' WEST
 MAGNETIC NORTH DECLINATION: 18°00' EAST
 AL DATUM: NATIONAL GEODETIC VERTICAL DATUM OF 1929
 ONTAL DATUM: 1927 NORTH AMERICAN DATUM
 ce on the predicted North American Datum of 1983,
 the projection lines as shown by dashed corner ticks
 eters north and 86 meters east)
 may be private inholdings within the boundaries of any

PROVISIONAL MAP
 Produced from original
 manuscript drawings. Inform

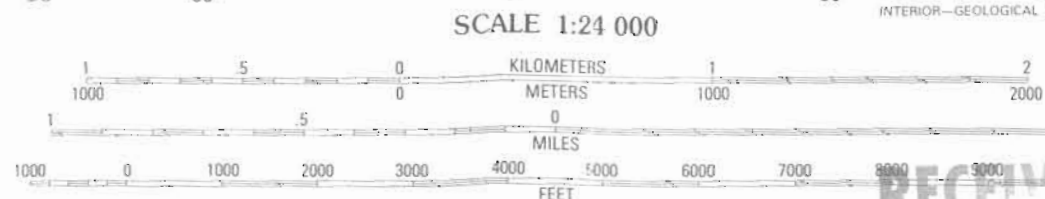

CONTOUR INTERVAL 40 FEET

To convert meters to feet multiply by 3.2808
 To convert feet to meters multiply by .3048

INTERIOR—GEOLOGICAL SURVEY, RESTON, VIRGINIA—1990

RECEIVED

DEC 30 1994

WATER RESOURCES DEPT
 SALEM, OREGON



QUADRANGLE LOCATION

ROAD LEGEND

Improved Road
 Unimproved Road
 Trail

Interstate Route U. S. Route State Route

1	2	3
4	5	

1 Whitetail Butte
 2 Turner Mtn
 3 Johnnie Cake Mtn
 4 Kimberly
 5 Monument

BOLOGNA BASIN, OREGON