



Application No. *280434*
Permit No. _____

CERTIFICATE NO. _____

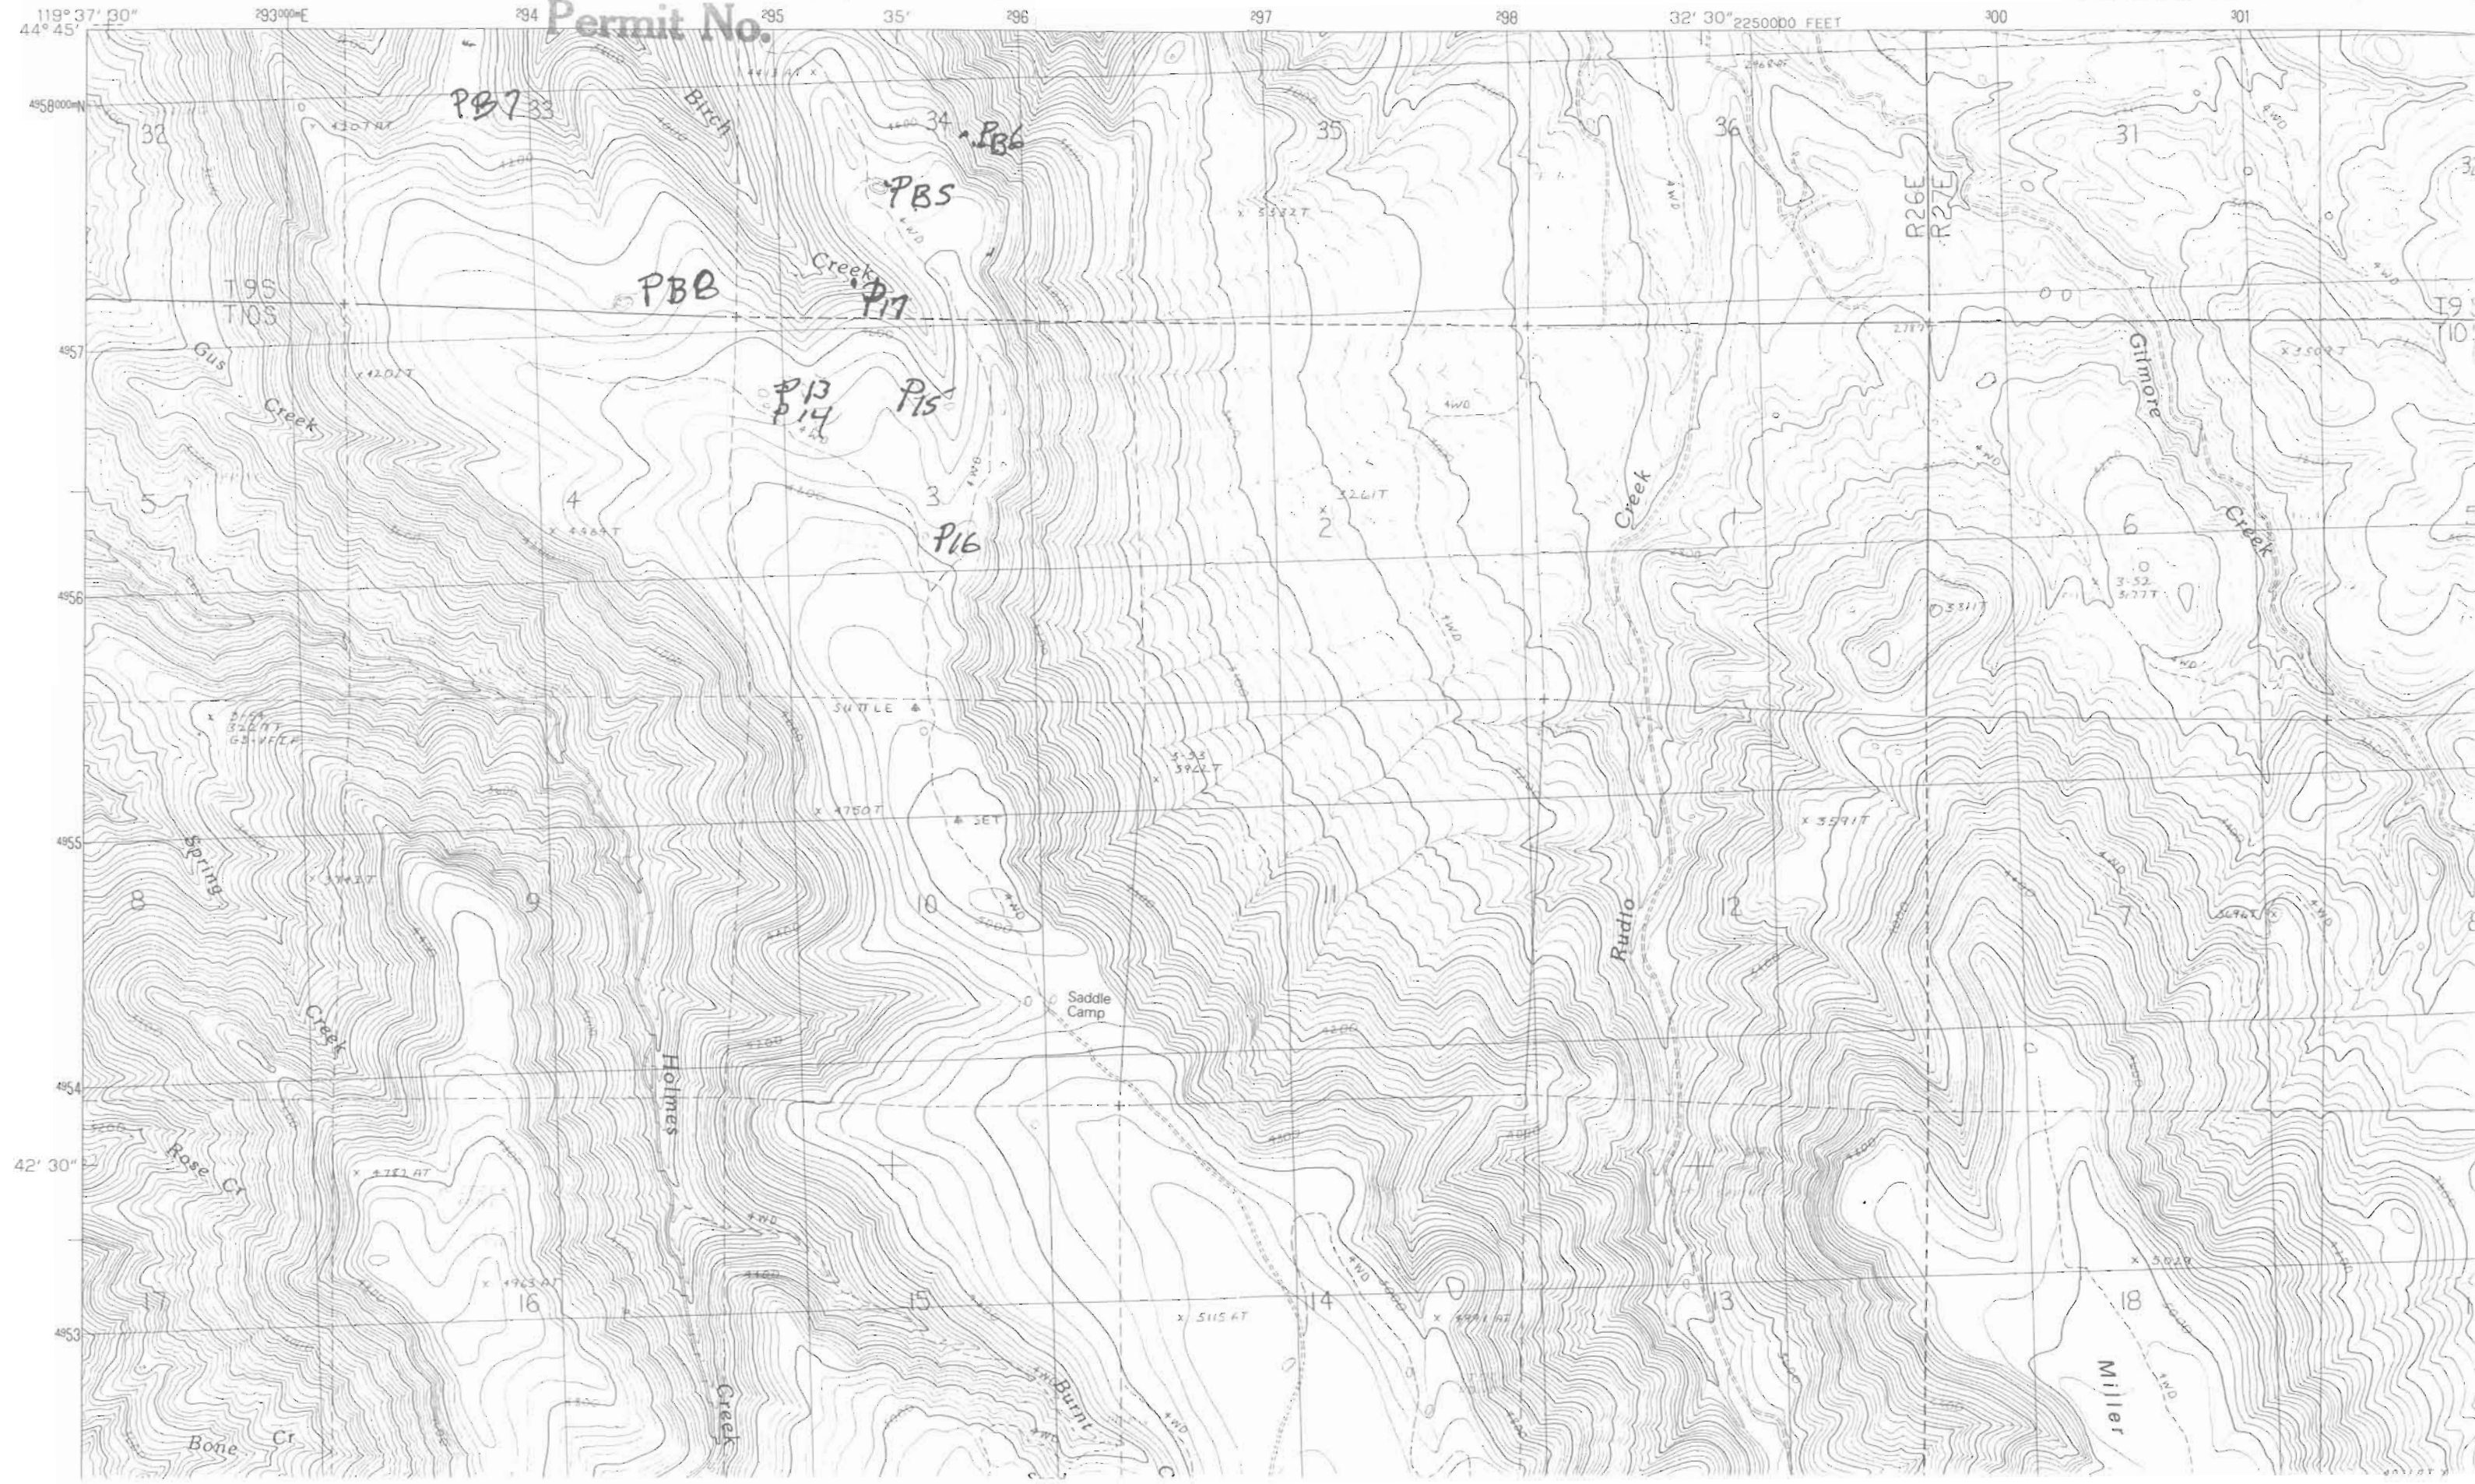


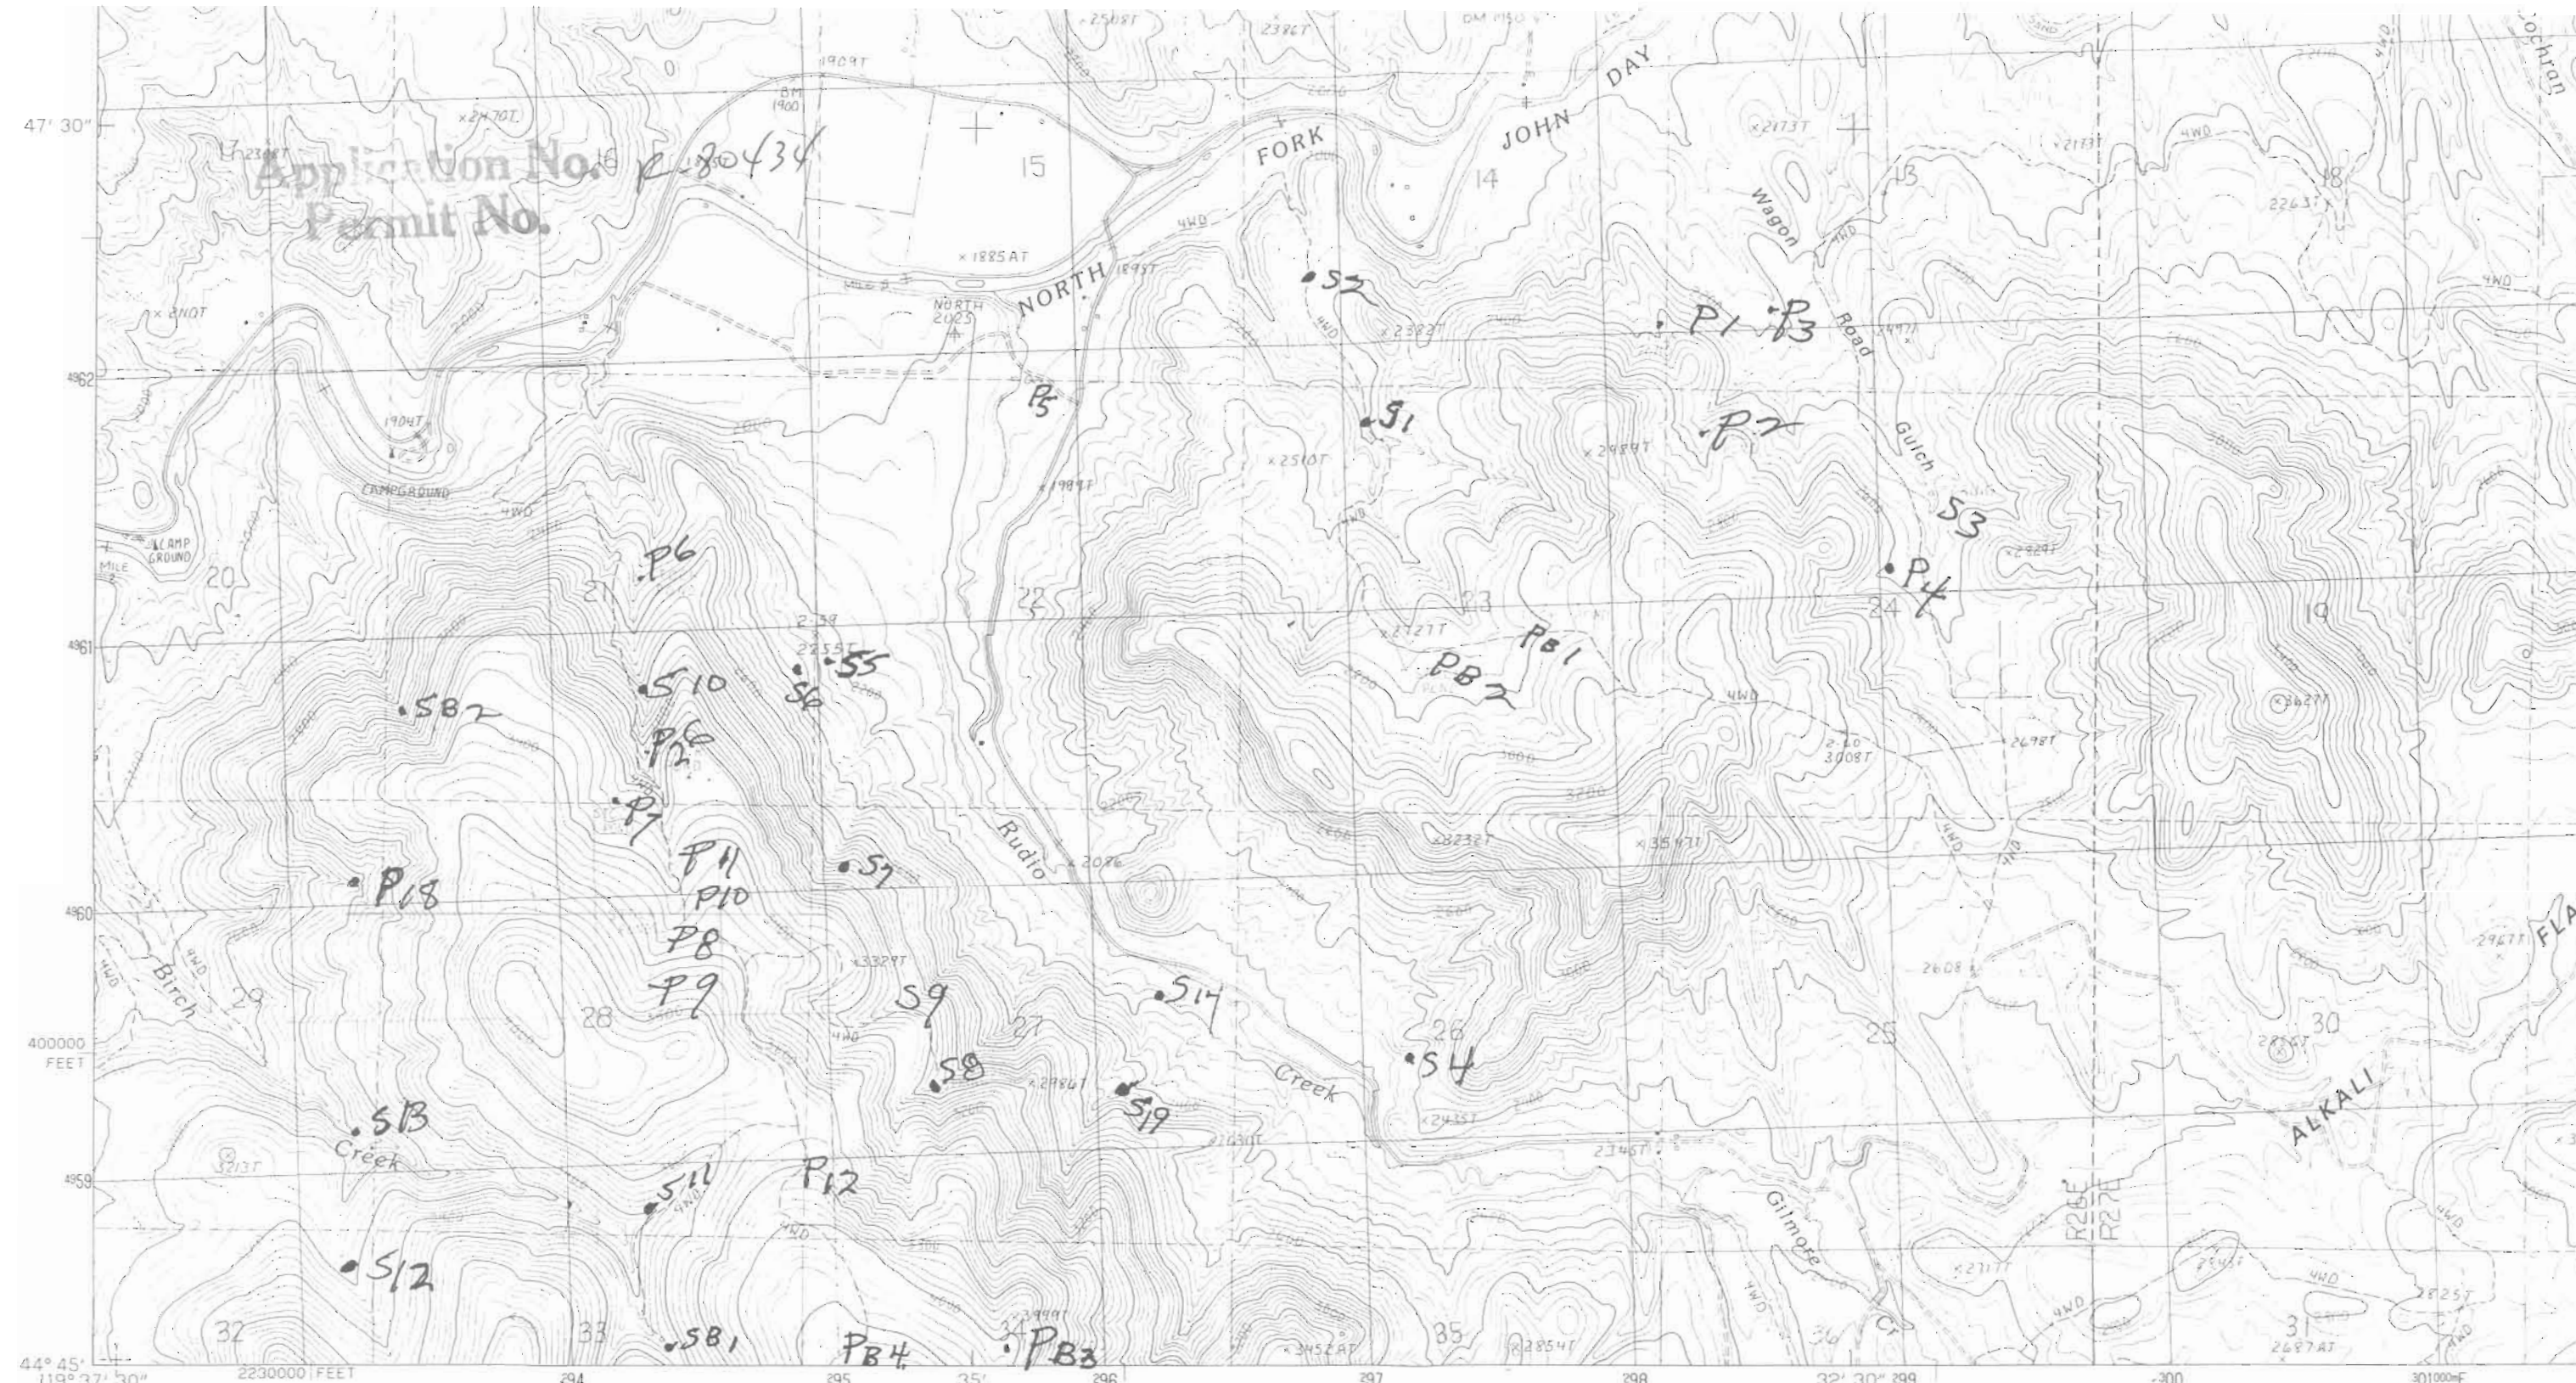

PRODUCED BY THE UNITED STATES GEOLOGICAL SURVEY
CONTROL BY USGS AND NOS/NOAA
COMPILED FROM AERIAL PHOTOGRAPHS TAKEN 1983
FIELD CHECKED 1987 MAP EDITED 1990
PROJECTION LAMBERT CONFORMAL CONIC
GRID: 1000-METER UNIVERSAL TRANSVERSE MERCATOR, ZONE 11
10,000-FOOT STATE GRID TICKS, OREGON, NORTH ZONE
UTM GRID DECLINATION 1° 48' WEST
1990 MAGNETIC NORTH DECLINATION 18° 00' EAST
VERTICAL DATUM NATIONAL GEODETIC VERTICAL DATUM OF 1929
HORIZONTAL DATUM 1927 NORTH AMERICAN DATUM
To place on the predicted North American Datum of 1983,
move the projection lines as shown by dashed corner ticks
(19 meters north and 86 meters east)
There may be private inholdings within the boundaries of any
Federal or State reservations shown on this map
No distinction made between houses, barns, and other buildings

71986

PROVISIONAL MAP
Produced from original
manuscript drawings. Infor-
mation shown as of date of
field check.

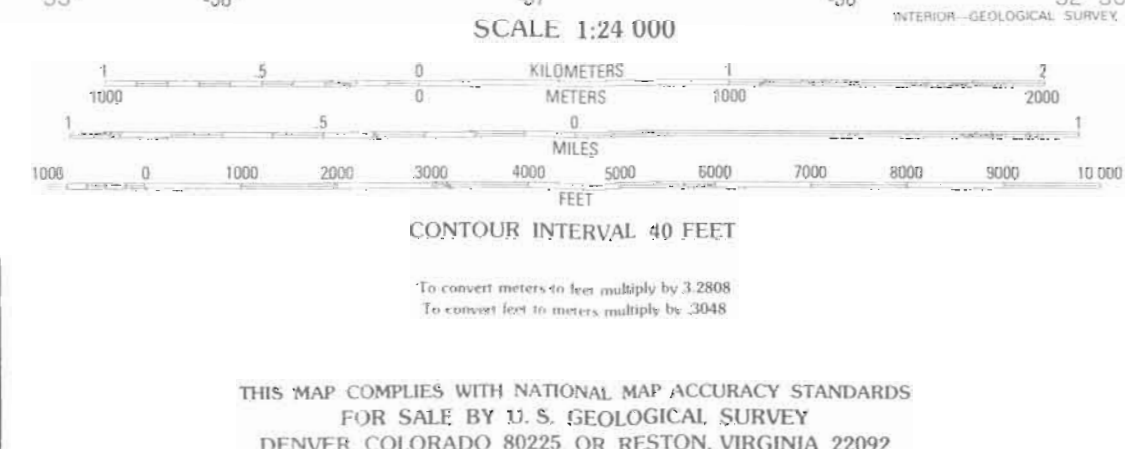

ROAD LEGEND

Improved Road
Unimproved Road
Trail

Interstate Route U.S.

QUADRANGLE LOCATION

1	2	3	1 Whitetail Butte
4		5	2 Turner Mtn
6	7	8	3 Johnny Cake Mtn
			4 Kimberly
			5 Monument
			6 Mt Misery
			7 Miller Flat
			8 Courthouse Rock

ADJOINING 7.5 QUADRANGLE NAMES

BOLOGNA
PROVISION

4411