


PRODUCED BY THE UNITED STATES GEOLOGICAL SURVEY CONTROL BY USGS AND NOS/NOAA COMPILED FROM AERIAL PHOTOGRAPHS TAKEN 1984 FIELD CHECKED 1987. MAP EDITED 1990 PROJECTION LAMBERT CONFORMAL CONIC GRID: 1000-METER UNIVERSAL TRANSVERSE MERCATOR ZONE 11 10,000-FOOT STATE GRID TICKS OREGON, NORTH ZONE UTM GRID DECLINATION 1' 48" WEST 1990 MAGNETIC NORTH DECLINATION 18 00' EAST VERTICAL DATUM NATIONAL GEODETIC VERTICAL DATUM OF 1929 HORIZONTAL DATUM 1927 NORTH AMERICAN DATUM To place on the predicted North American Datum of 1983, move the projection lines as shown by dashed corner ticks (19 meters north and 86 meters east) There may be private inholdings within the boundaries of any Federal or State reservations shown on this map No distinction made between houses, barns, and other buildings

PROVISIONAL MAP
Produced from original manuscript drawings. Information shown as of date of field check.

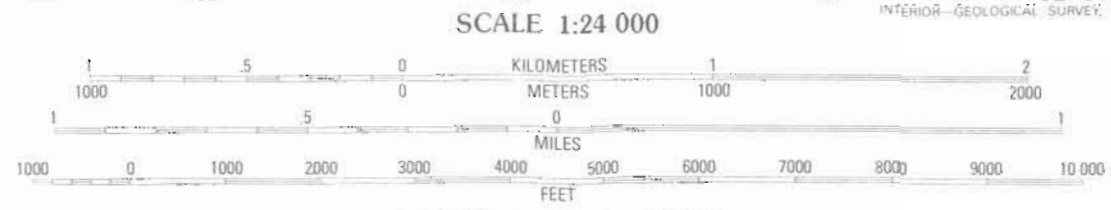

To convert meters to feet multiply by 3.2808
To convert feet to meters multiply by .3048
71988
THIS MAP COMPLIES WITH NATIONAL MAP ACCURACY STANDARDS FOR SALE BY U.S. GEOLOGICAL SURVEY DENVER COLORADO 80225. OR RESTON, VIRGINIA 22092

QUADRANGLE LOCATION

1	2	3	1 Whitetail Butte
			2 Turner Mtn
4		5	3 Johnny Cake Mtn
			4 Kimberly
			5 Monument
			6 Mt Misery
6	7	8	7 Miller Flat
			8 Courthouse Rock

ADJOINING 7.5 QUADRANGLE NAMES

ROAD LEG
Improved Road
Unimproved Road
Trail
InterState Route
U.S.

PROVISION