

BUD & MIRIAM LIBERATORE
22185 S. LOWER HIGHLAND RD.
BEAVERCREEK, OREGON 97004

Application No. 280452

Permit No.

71990


"CERTIFICATE NO.

DEC 30 1994

WATER RESOURCES DEP
SALEM, OREGON

CLACKAMAS COUNTY
45 35 02 500

DEC. 94

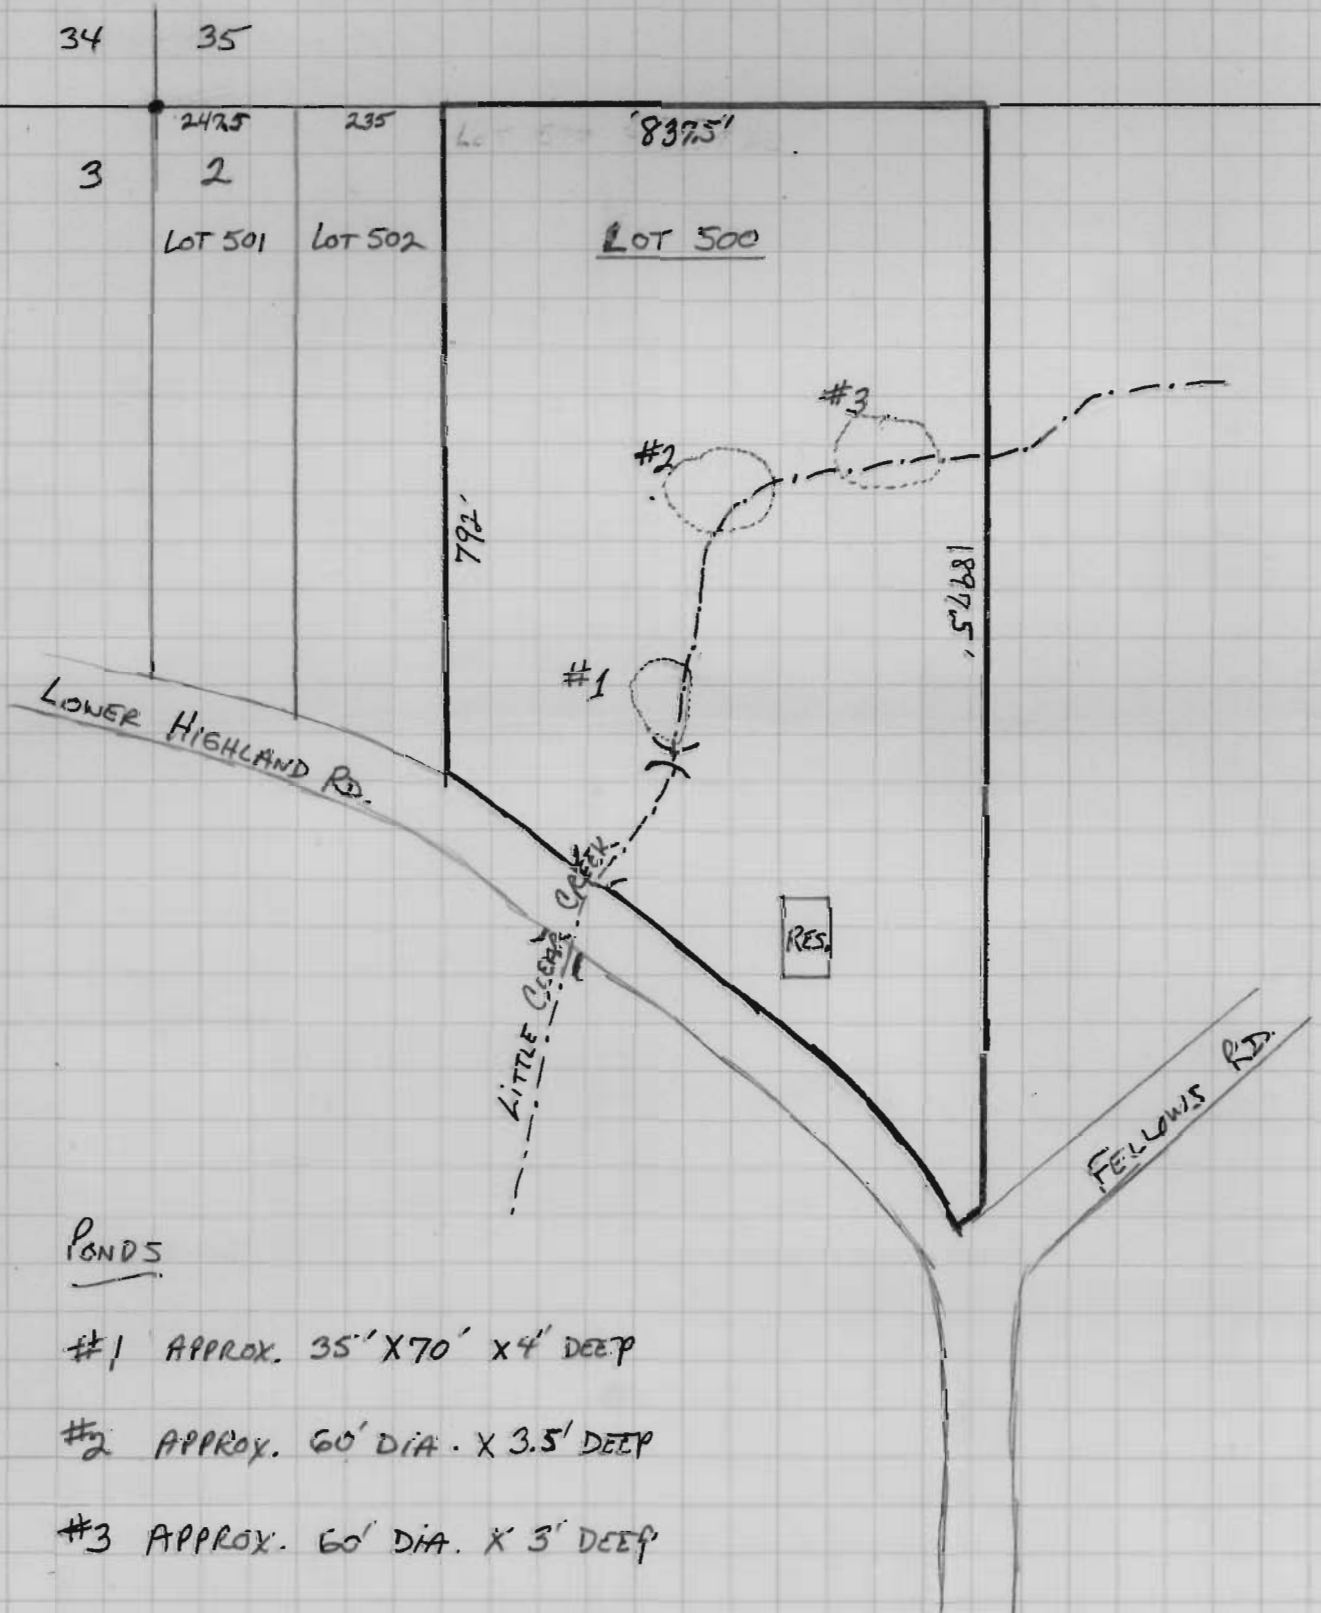

PONDS

#1 APPROX. 35' X 70' X 4' DEEP

#2 APPROX. 60' DIA. X 3.5' DEEP

#3 APPROX. 60' DIA. X 3' DEEP