


2326 W SE
(MOUNTAIN VIEW)

UNITED STATES
DEPARTMENT OF THE INTERIOR
GEOLOGICAL SURVEY

Paradise
Quadrangle

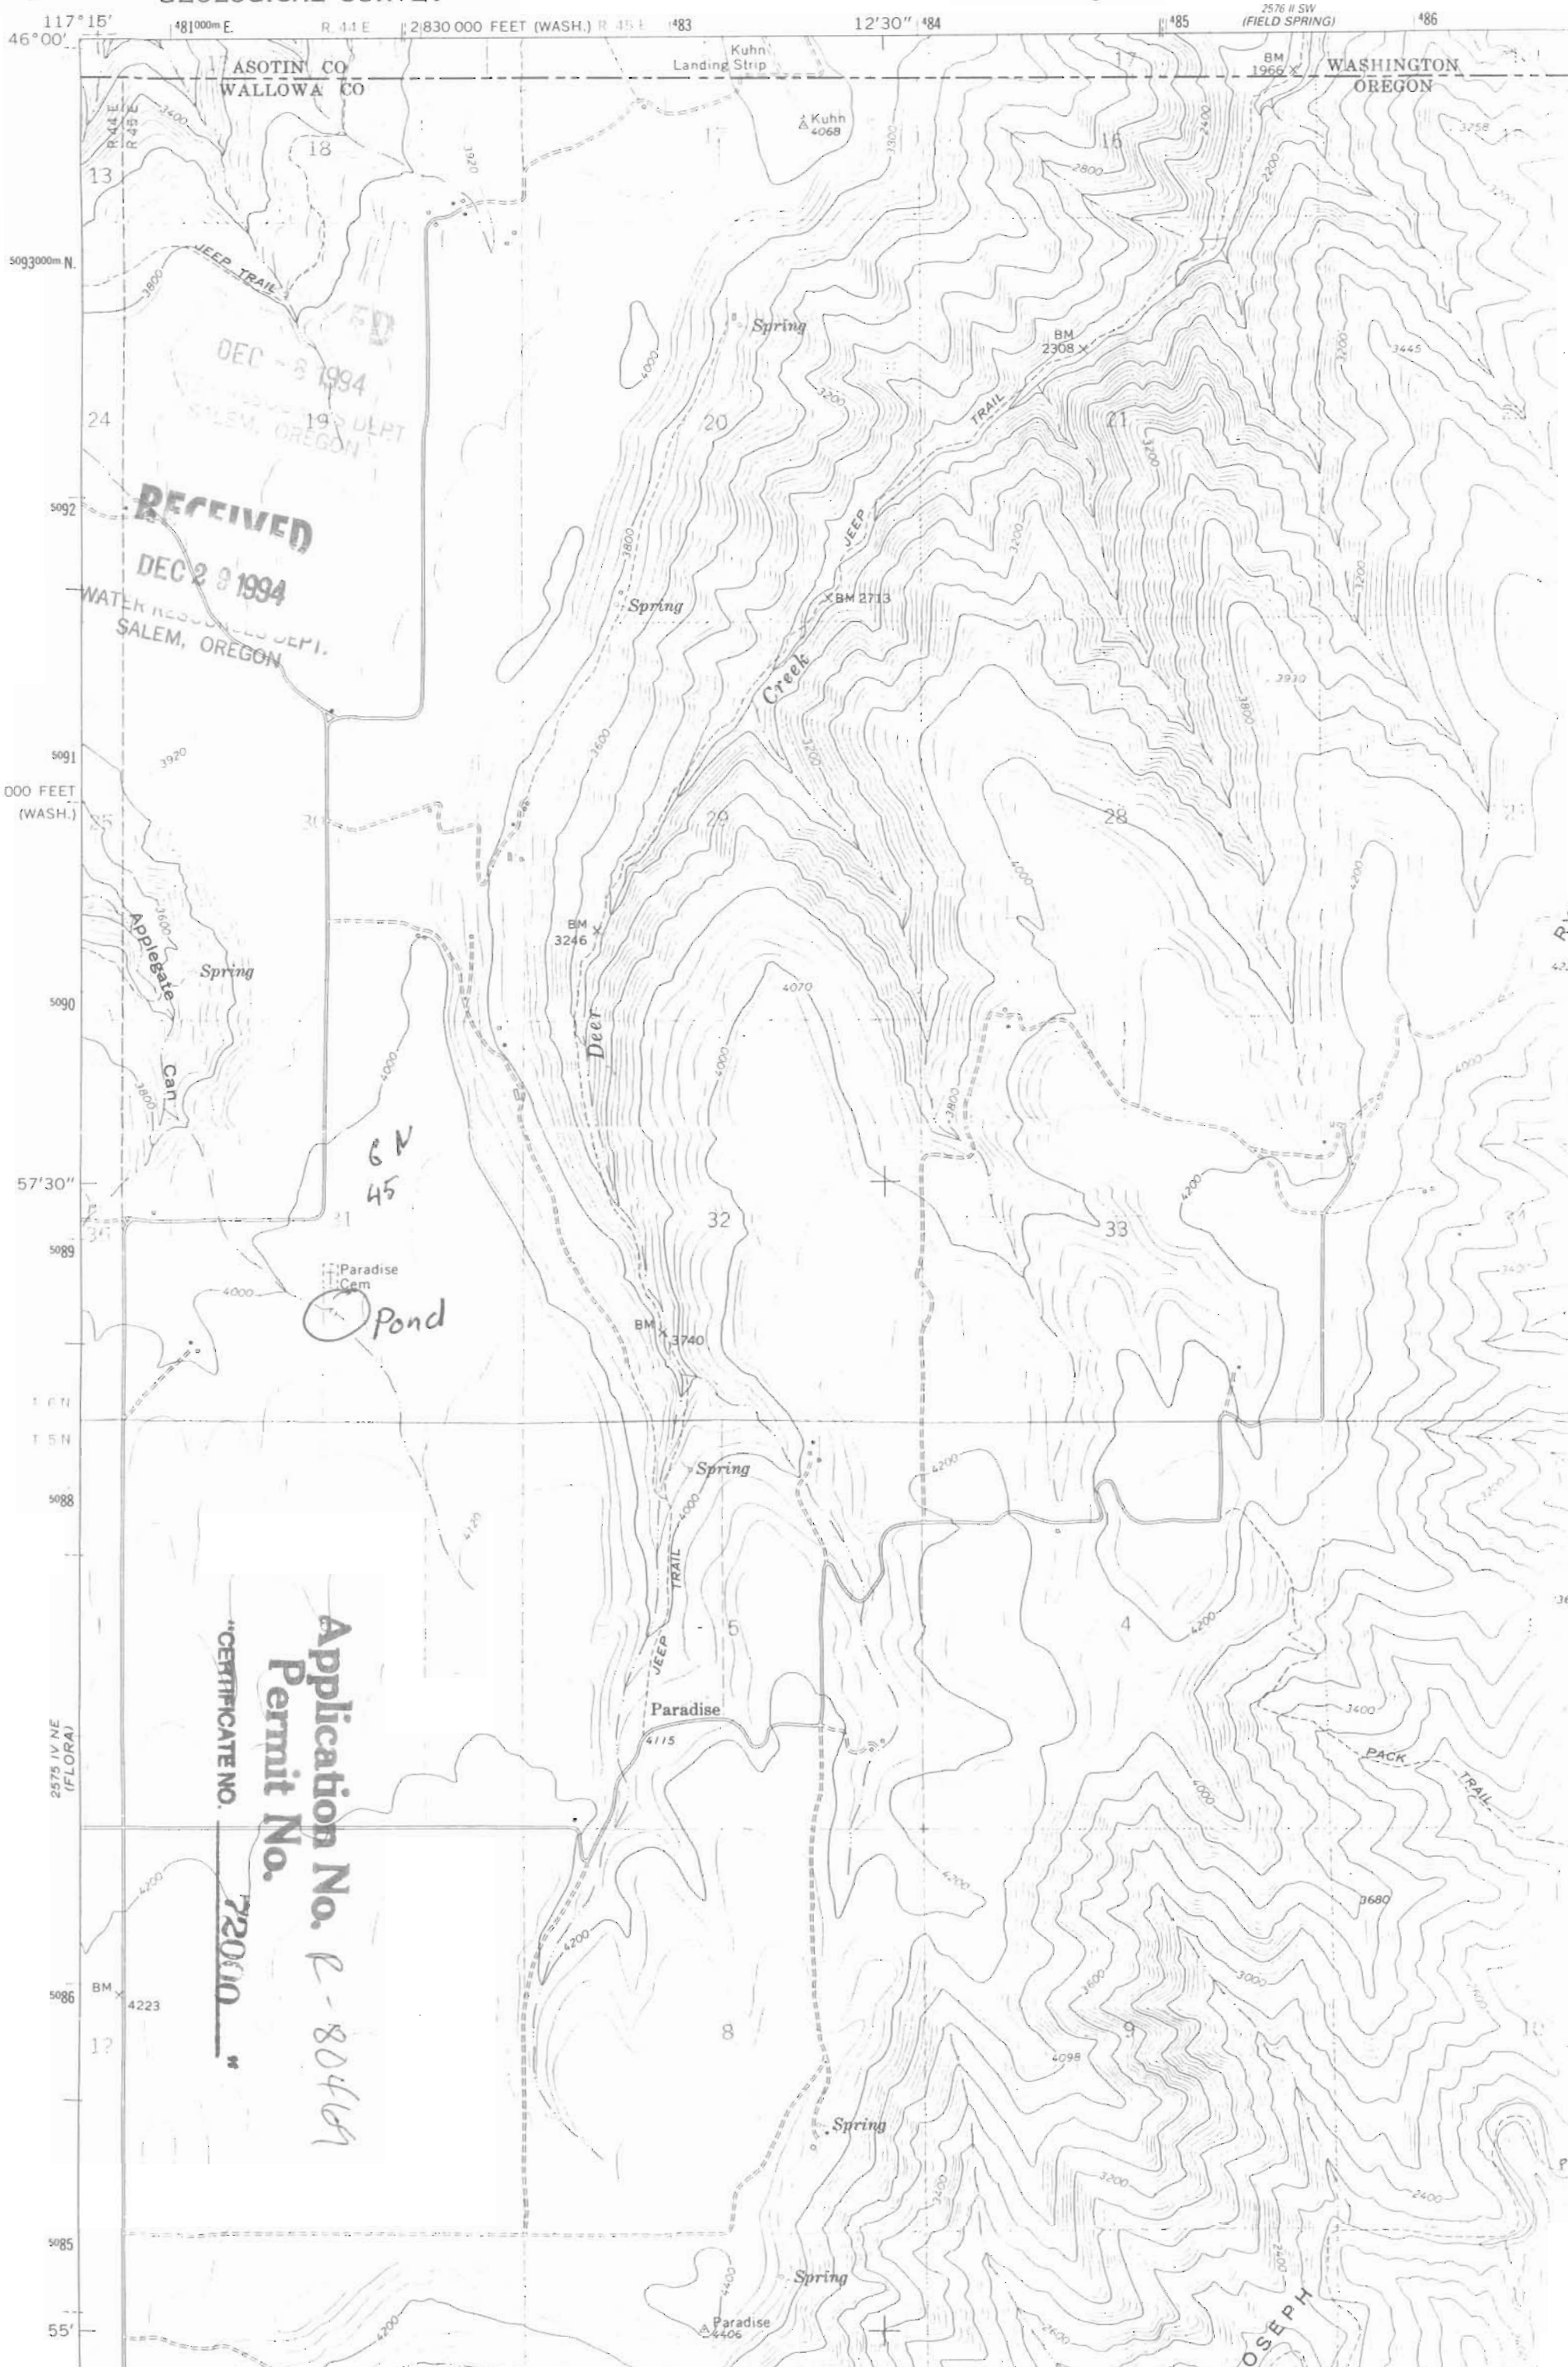

DEC - 8 1994
1993 DEPT
SALEM, OREGON

RECEIVED

DEC 28 1994

WATER RESOURCES DEPT.
SALEM, OREGON

Application No. 8-80461
Permit No. 72000

CERTIFICATE NO.

72000