


Poison Cr.
1990 Edition
W.H. Beal

72001

CERTIFICATE NO.

Application No. R-80470
Permit No.

urns NW

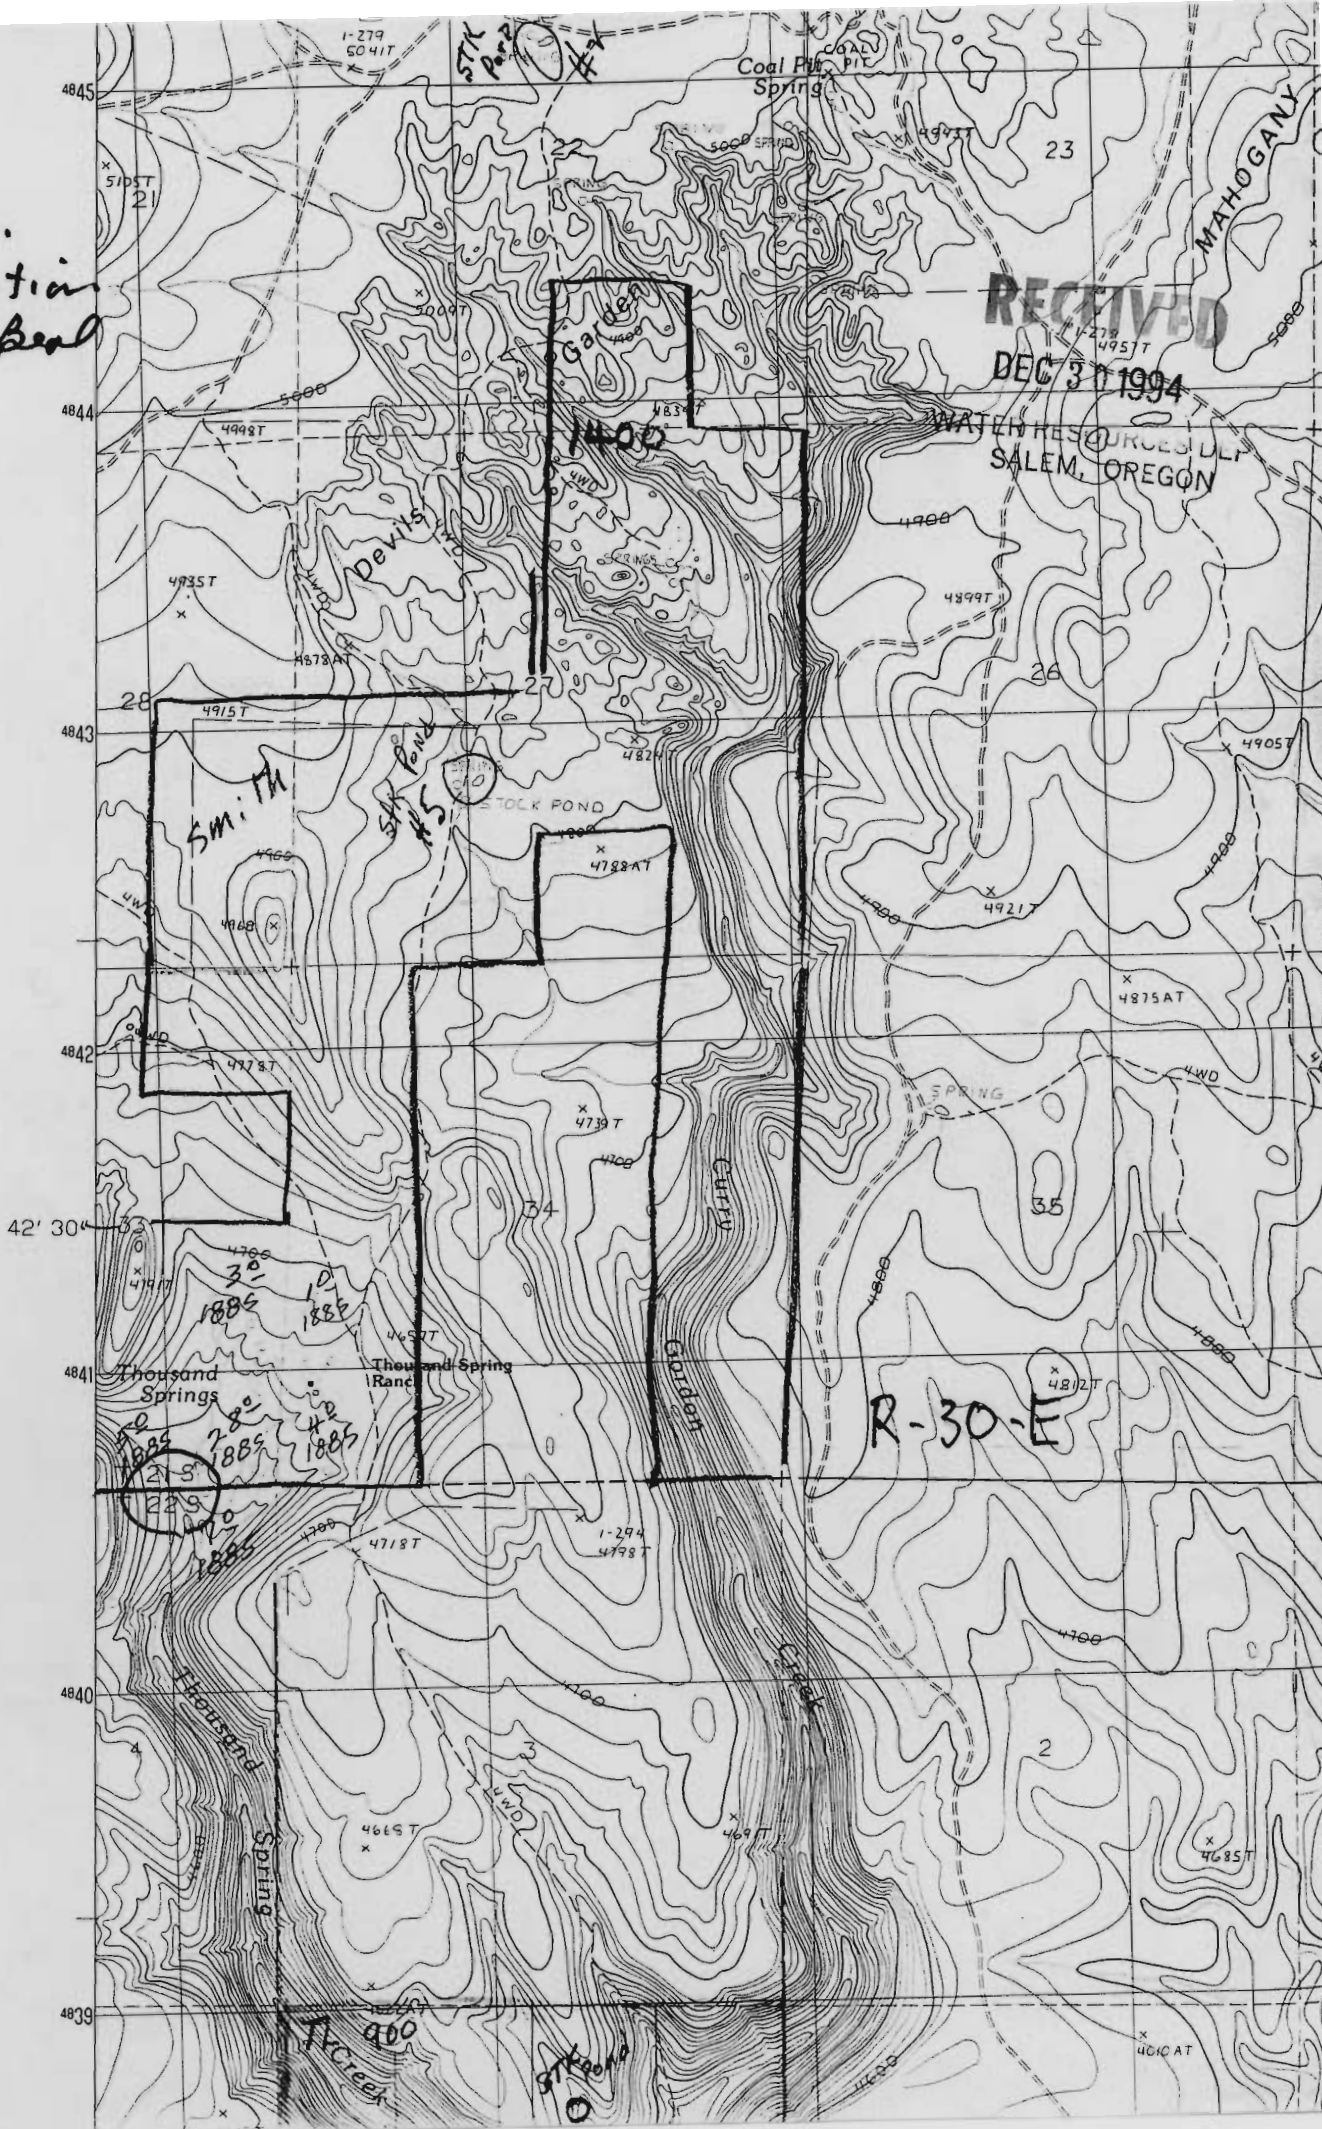

RECEIVED

DEC 30 1994

WATER RESOURCES DIVISION
SALEM, OREGON

R-30-E

To convert meters to feet multiply
To convert feet to meters multiply

Application No. 8-8470
Permit No.

RECEIVED
DEC 30 1994
WATER RESOURCES DIVISION
SALEM, OREGON

DEC 30 1994

WATER RESOURCES DIVISION
SALEM, OREGON

HOLLOW

Squaw

Creek

Landing

Creek

Beal
Prop

St. Lawrence
Road #2
Smith

1200

900

500



















SCALE 1:24 000

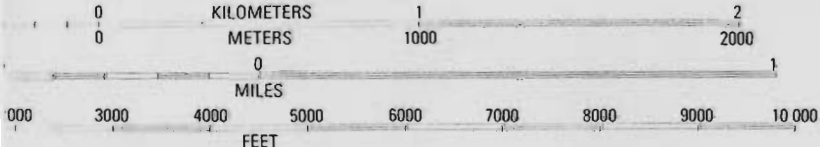

CONTOUR INTERVAL 40 FEET

To convert meters to feet multiply by 3.2808
To convert feet to meters multiply by .3048



QUADRANGLE LOCATION

ROAD LEGEND

Improved Road
Unimproved Road
Trail

○ Interstate Route ○ U. S. Route ○ State Route

1	2	3	1 Alsup Mountain
			2 West Myrtle Butte
			3 Myrtle Park Meadows
4		5	4 Hughet Valley
			5 Mosquito Flat
			6 Holmes Canyon
			7 Green Flat Reservoir
6	7	8	8 Poison Creek


LANDING CREEK, OREGON

PROVISIONAL EDITION 1990

CERTIFICATE NO. 12001

BURNS NW QUADRANGLE
OREGON-HARNEY CO.
7.5 MINUTE SERIES (TOPOGRAPHIC)

W. H. Beal

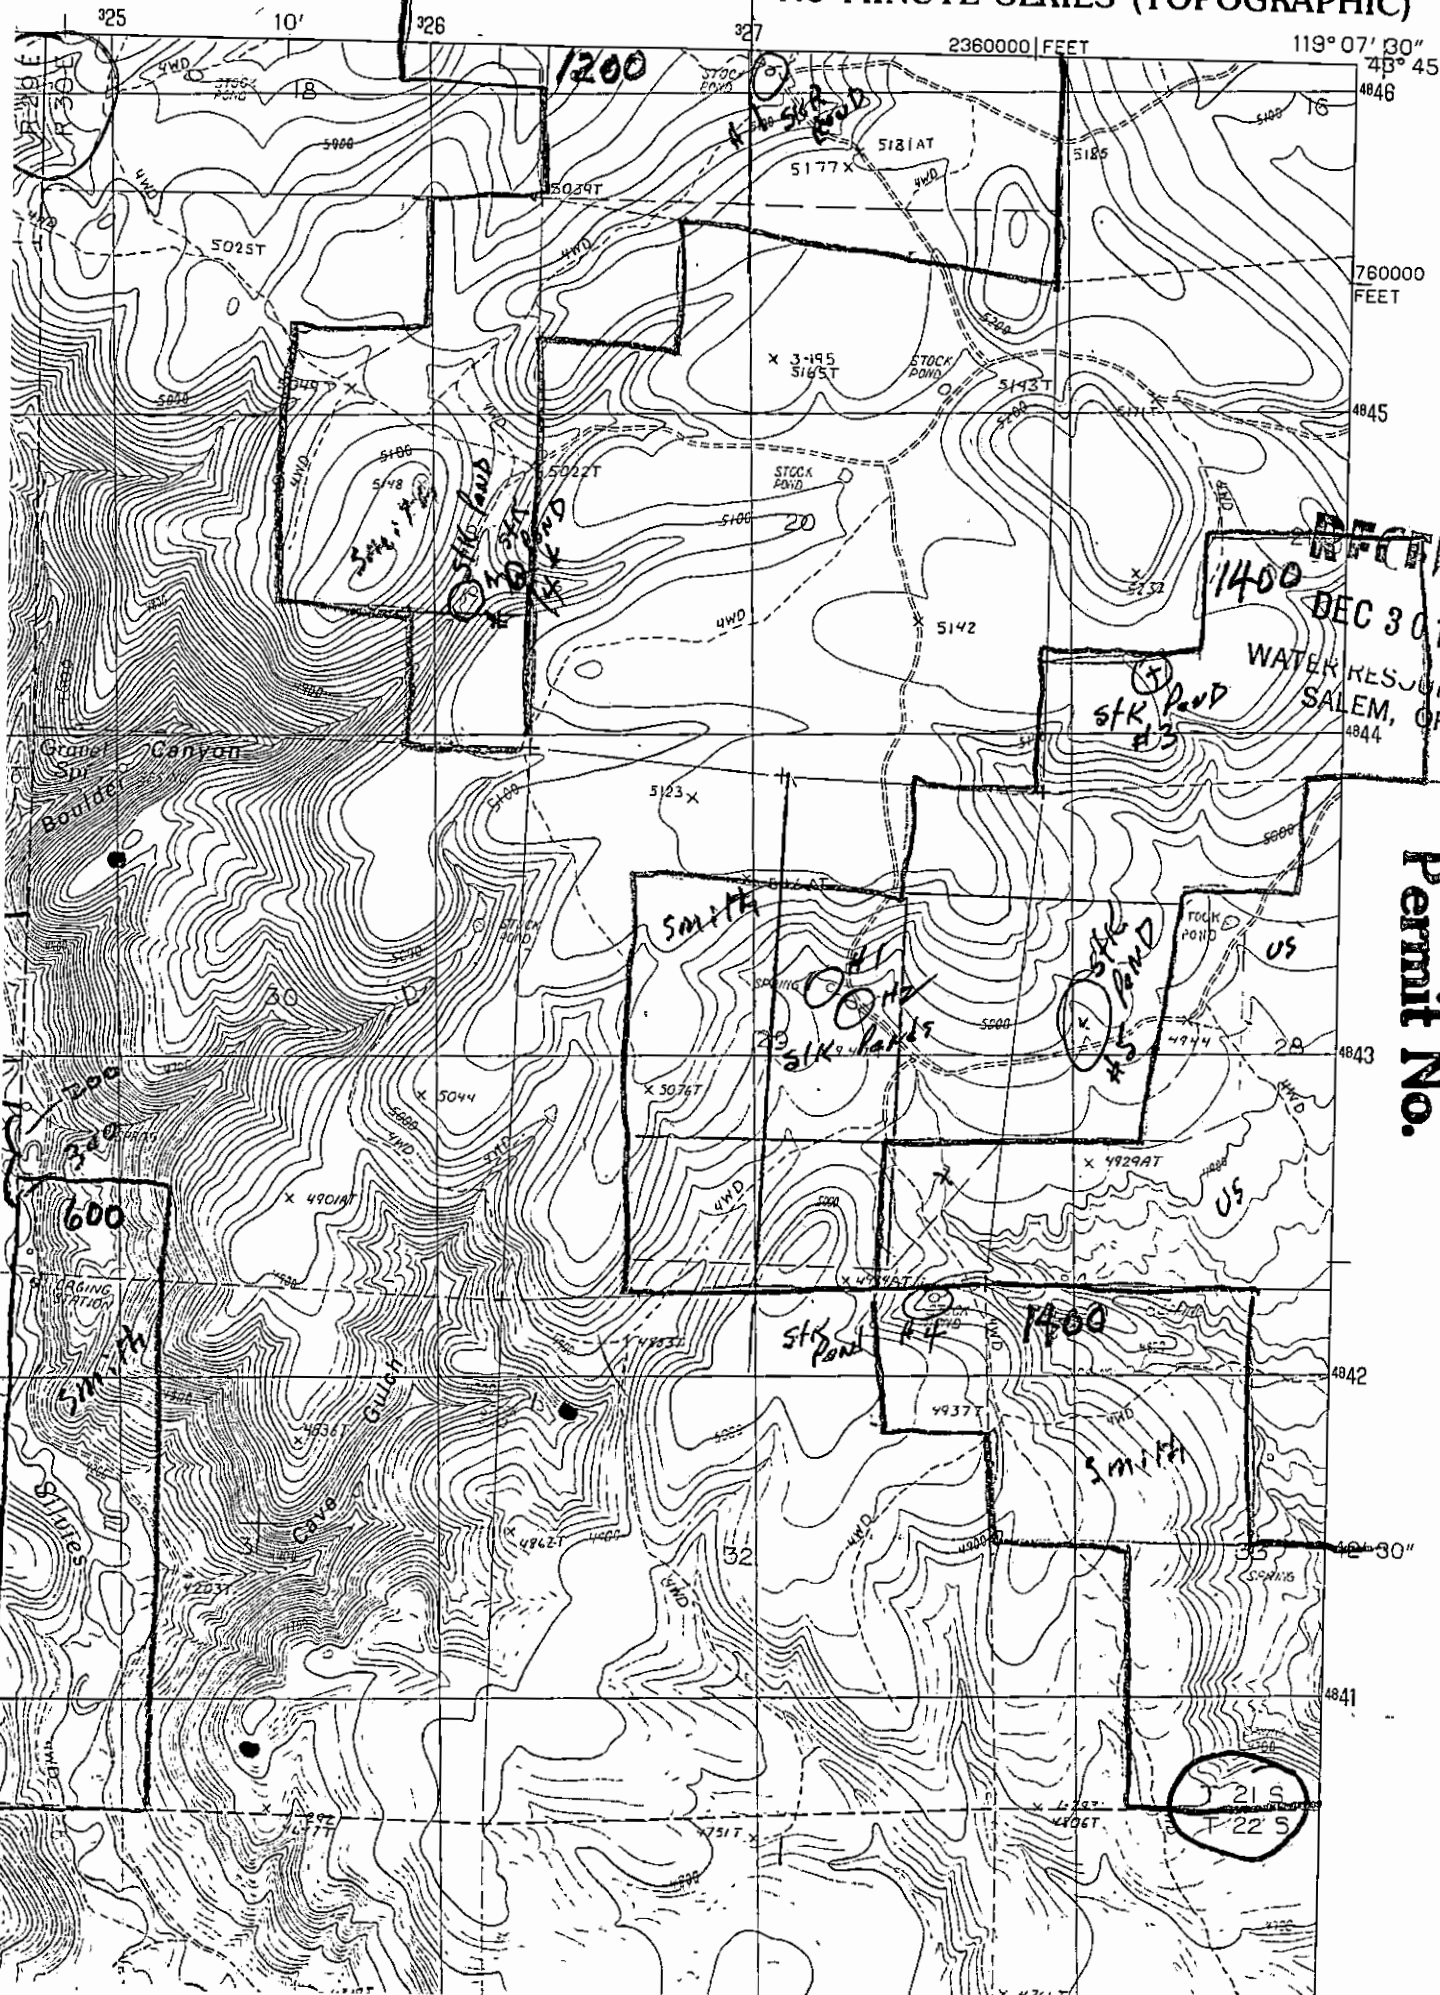

RECEIVED
DEC 30 1994
WATER RESOURCES DIV.
SALEM, OREGON

