


W. H. Beal

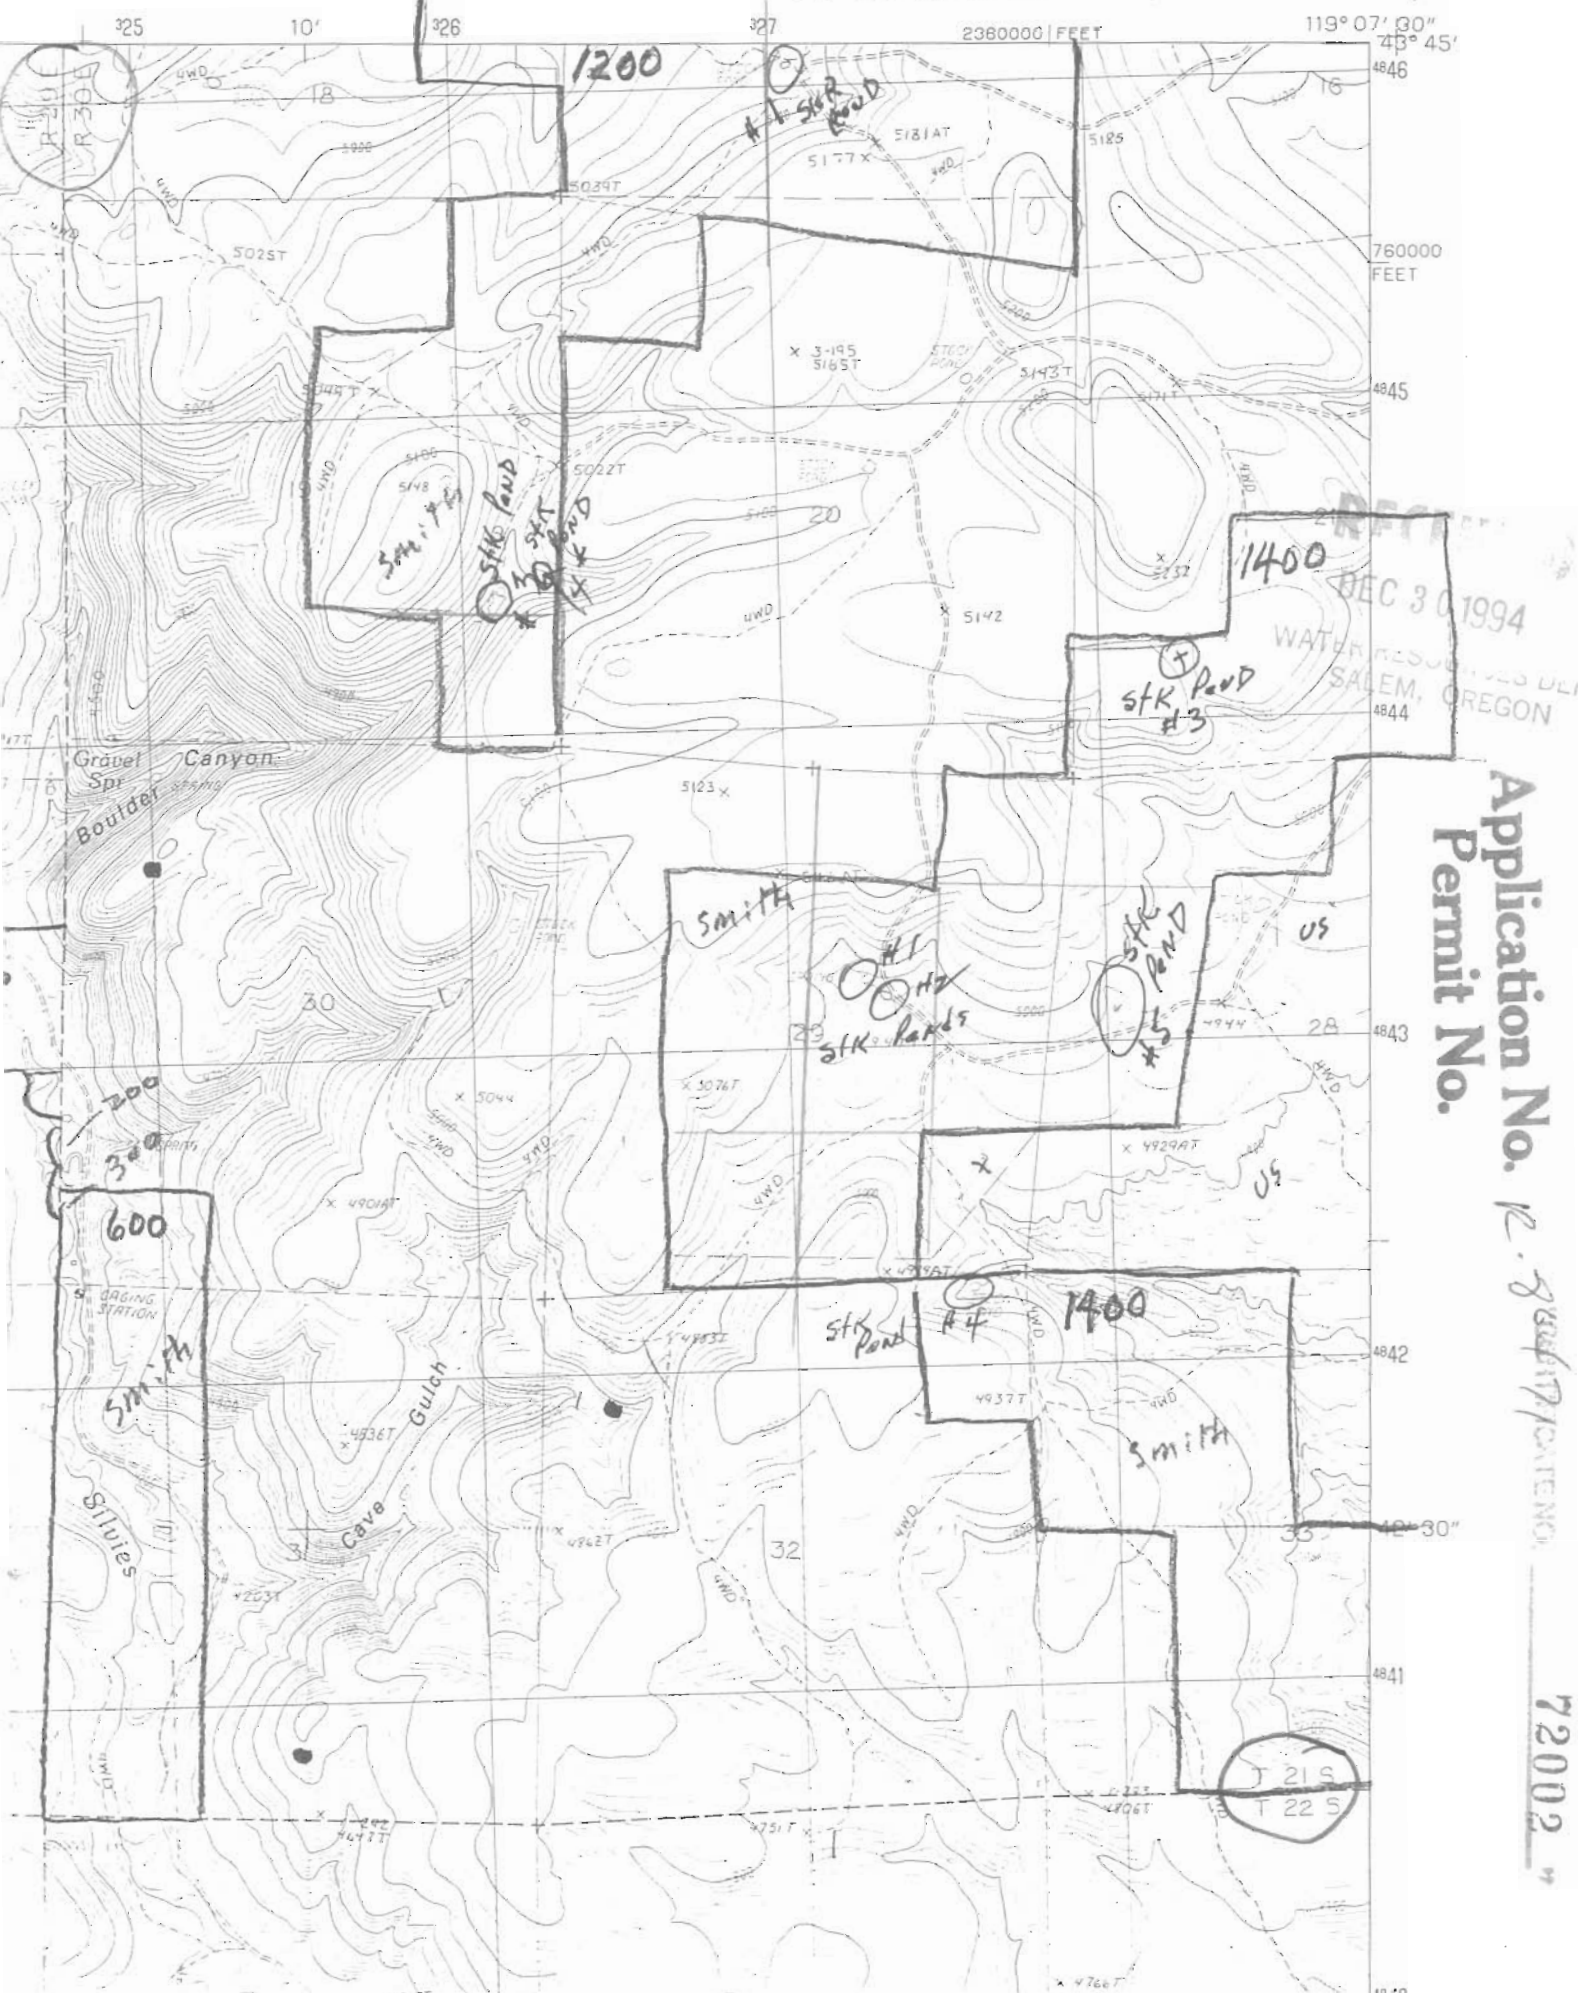

RECEIVED
DEC 30 1994

WATER RESOURCES
SALEM, OREGON

Landing

Creek

Creek


Beal
Prop

SPRING
S.M.
ford
H 2
S.M. H

1200



SCALE 1:24 000

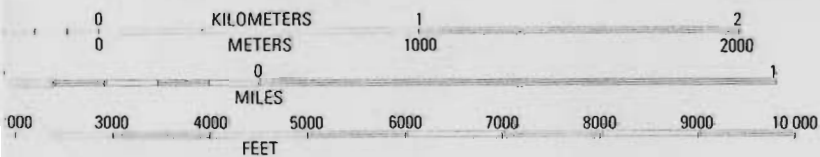

CONTOUR INTERVAL 40 FEET

To convert meters to feet multiply by 3.2808
To convert feet to meters multiply by .3048

INTERIOR, GEOLOGICAL SURVEY, RESTON, VIRGINIA--1990

OREGON

QUADRANGLE LOCATION

ROAD LEGEND

Improved Road	
Unimproved Road	
Trail	

 Interstate Route  U. S. Route  State Route

LANDING CREEK, OREGON

PROVISIONAL EDITION 1990

1	2	3	1 Alsop Mountain
			2 West Myrtle Butte
4		5	3 Myrtle Park Meadows
			4 Hughey Valley
			5 Mosquito Flat
			6 Holmes Canyon
6	7	8	7 Green Flat Reservoir
			8 Poison Creek

2001

2001

3° 45'
30"

Larraneta Reservoir

Silvies

STK Pond #2

STK Pond #3

H J Baker Ranch

R.D. Spring

WATER RES. SALE

RECEIVED DEC 30 1994

Smith

R F Smith Ranch

Landing Cr.
1990 Edition
W H Bond

STK Pond #1

STK Pond #2

STK Pond #1

SMITH

Old Dole-Smith Homestead

SMITH

STK Pond #1

SMITH

Red Lick Spring

Hamilton Ranch

Smith

SMITH

R-29-E

R-30-E

Landing

Creek

72002

Application No. R-80#
Permit No.

900

SMITH

Application No. 12-80471
Permit No.

