


15., 4E., SEC. 13, 14,
23, 24


72003 Application No. 12-80472
Permit No.

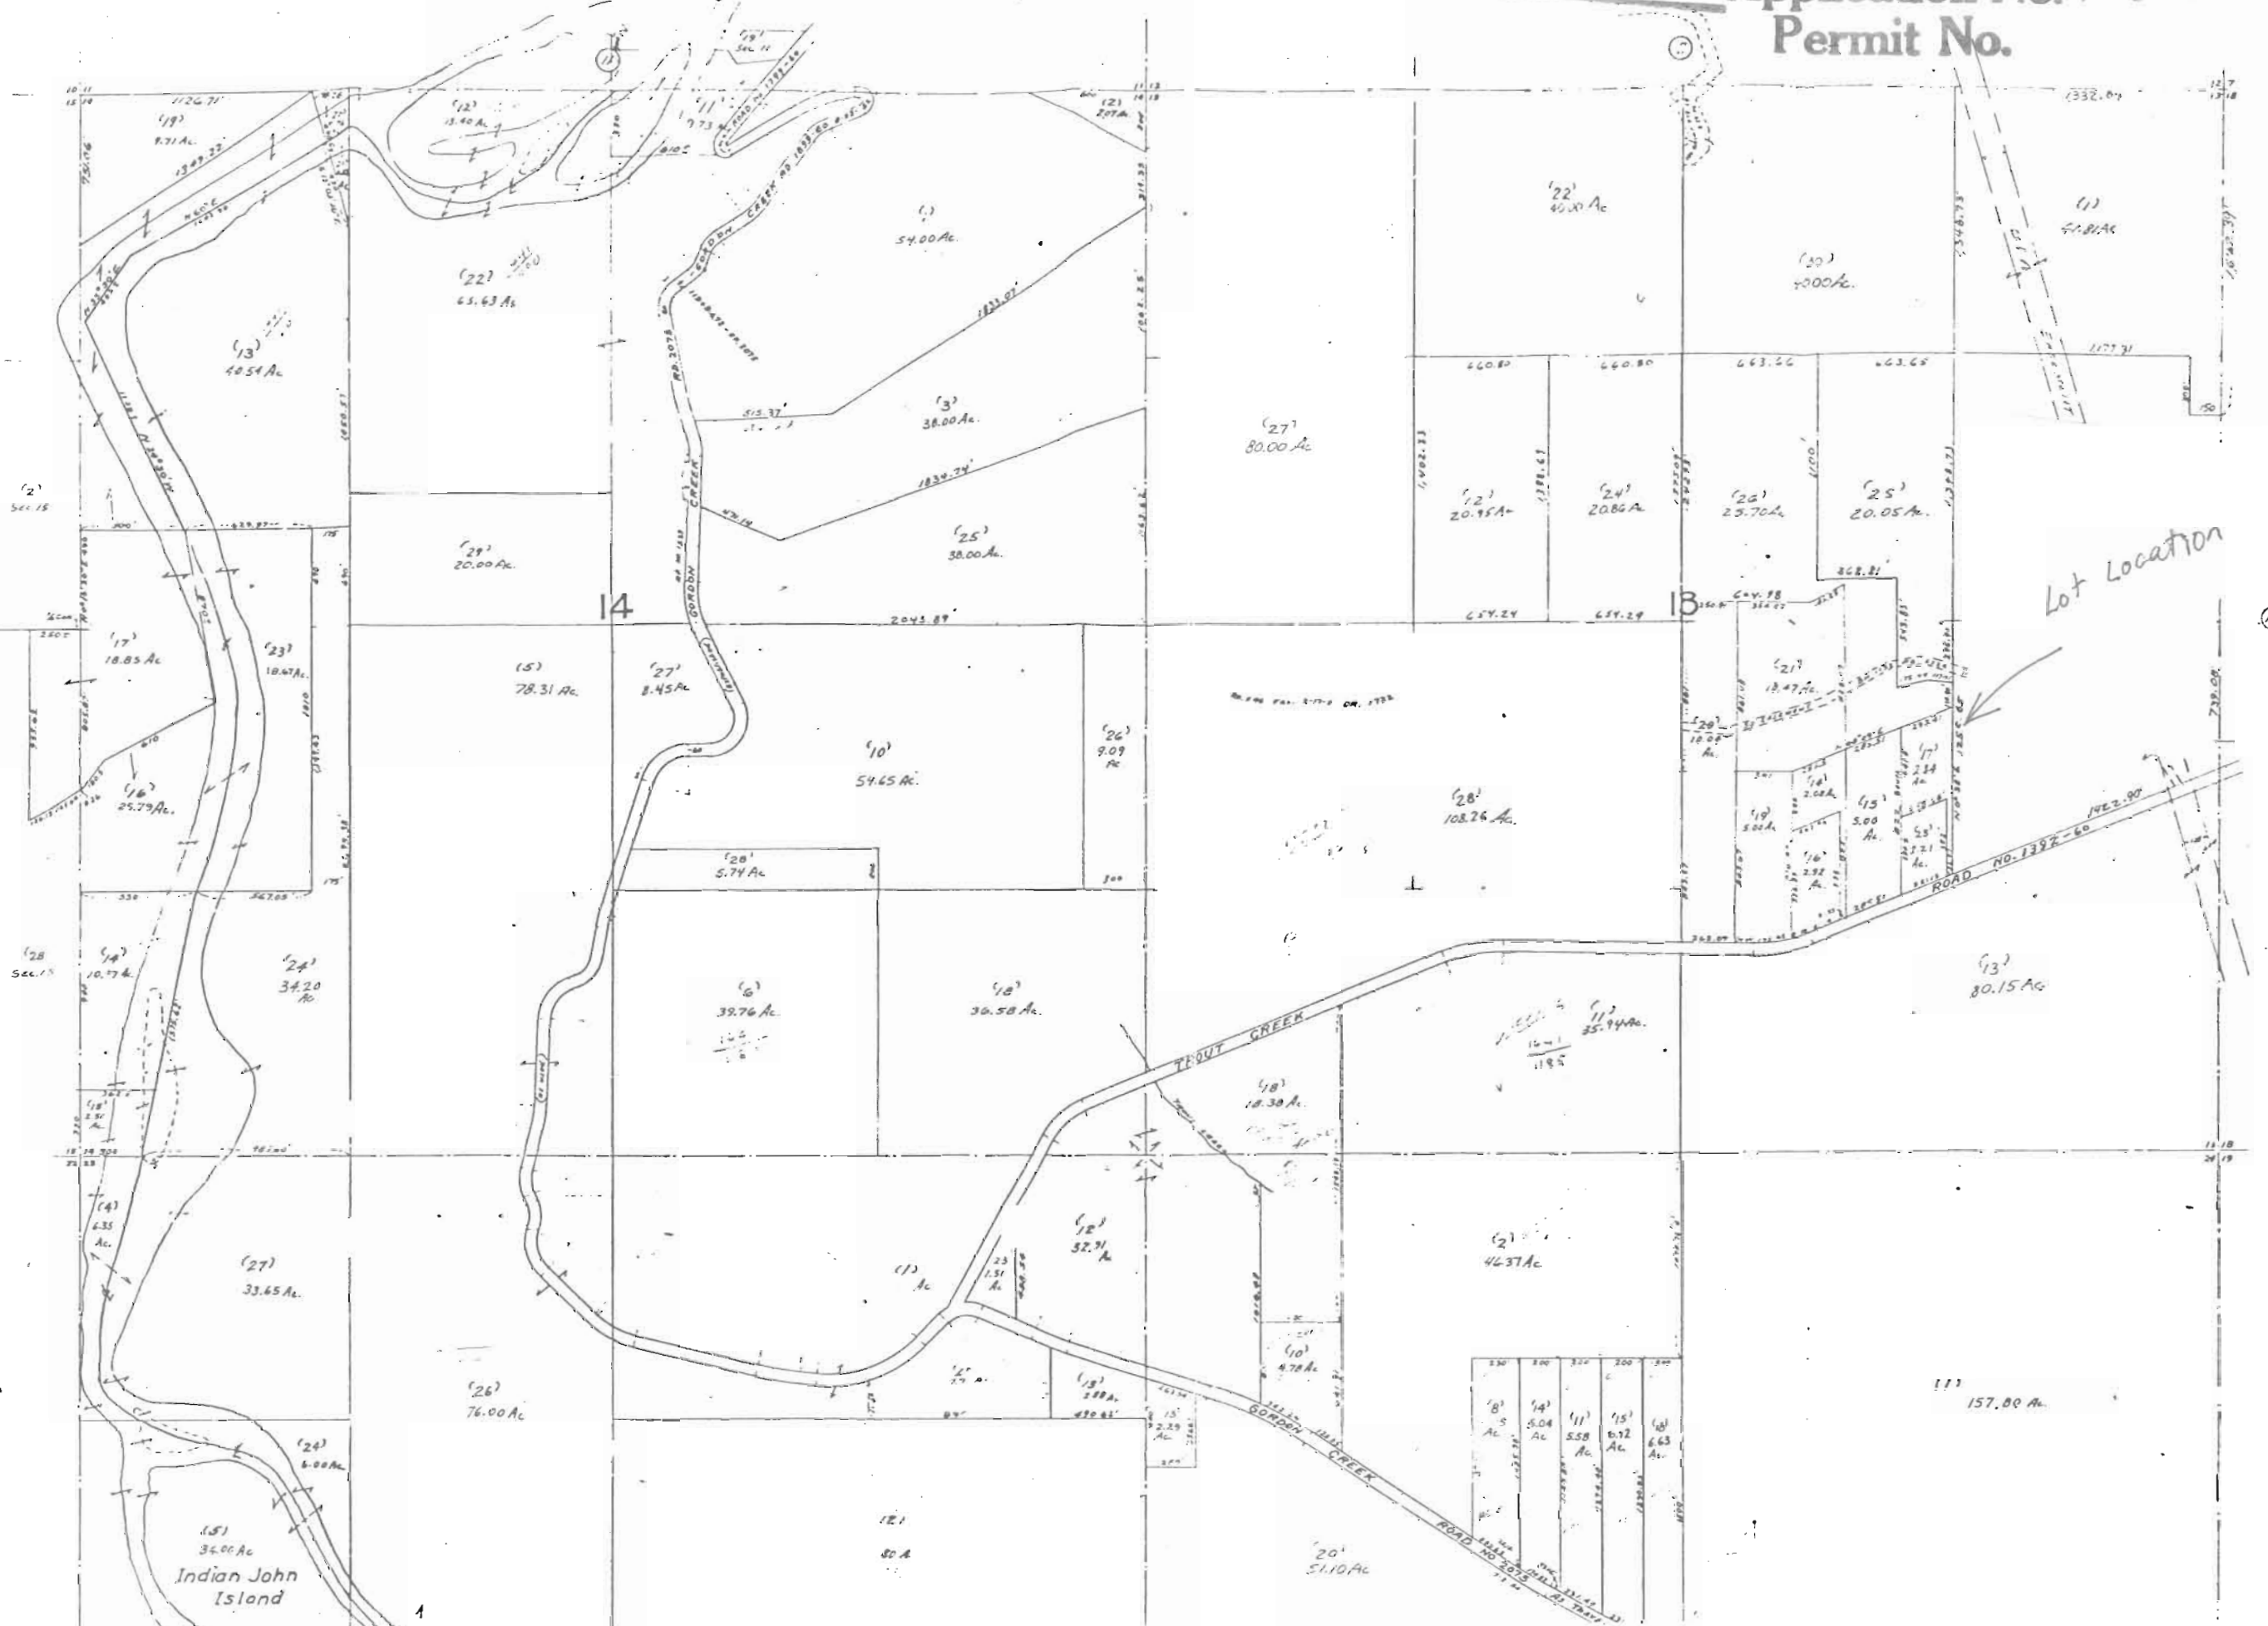

Application No. 12-80972
Permit No. 16

DEC 20 1954

U.S. GEOLOGICAL SURVEY

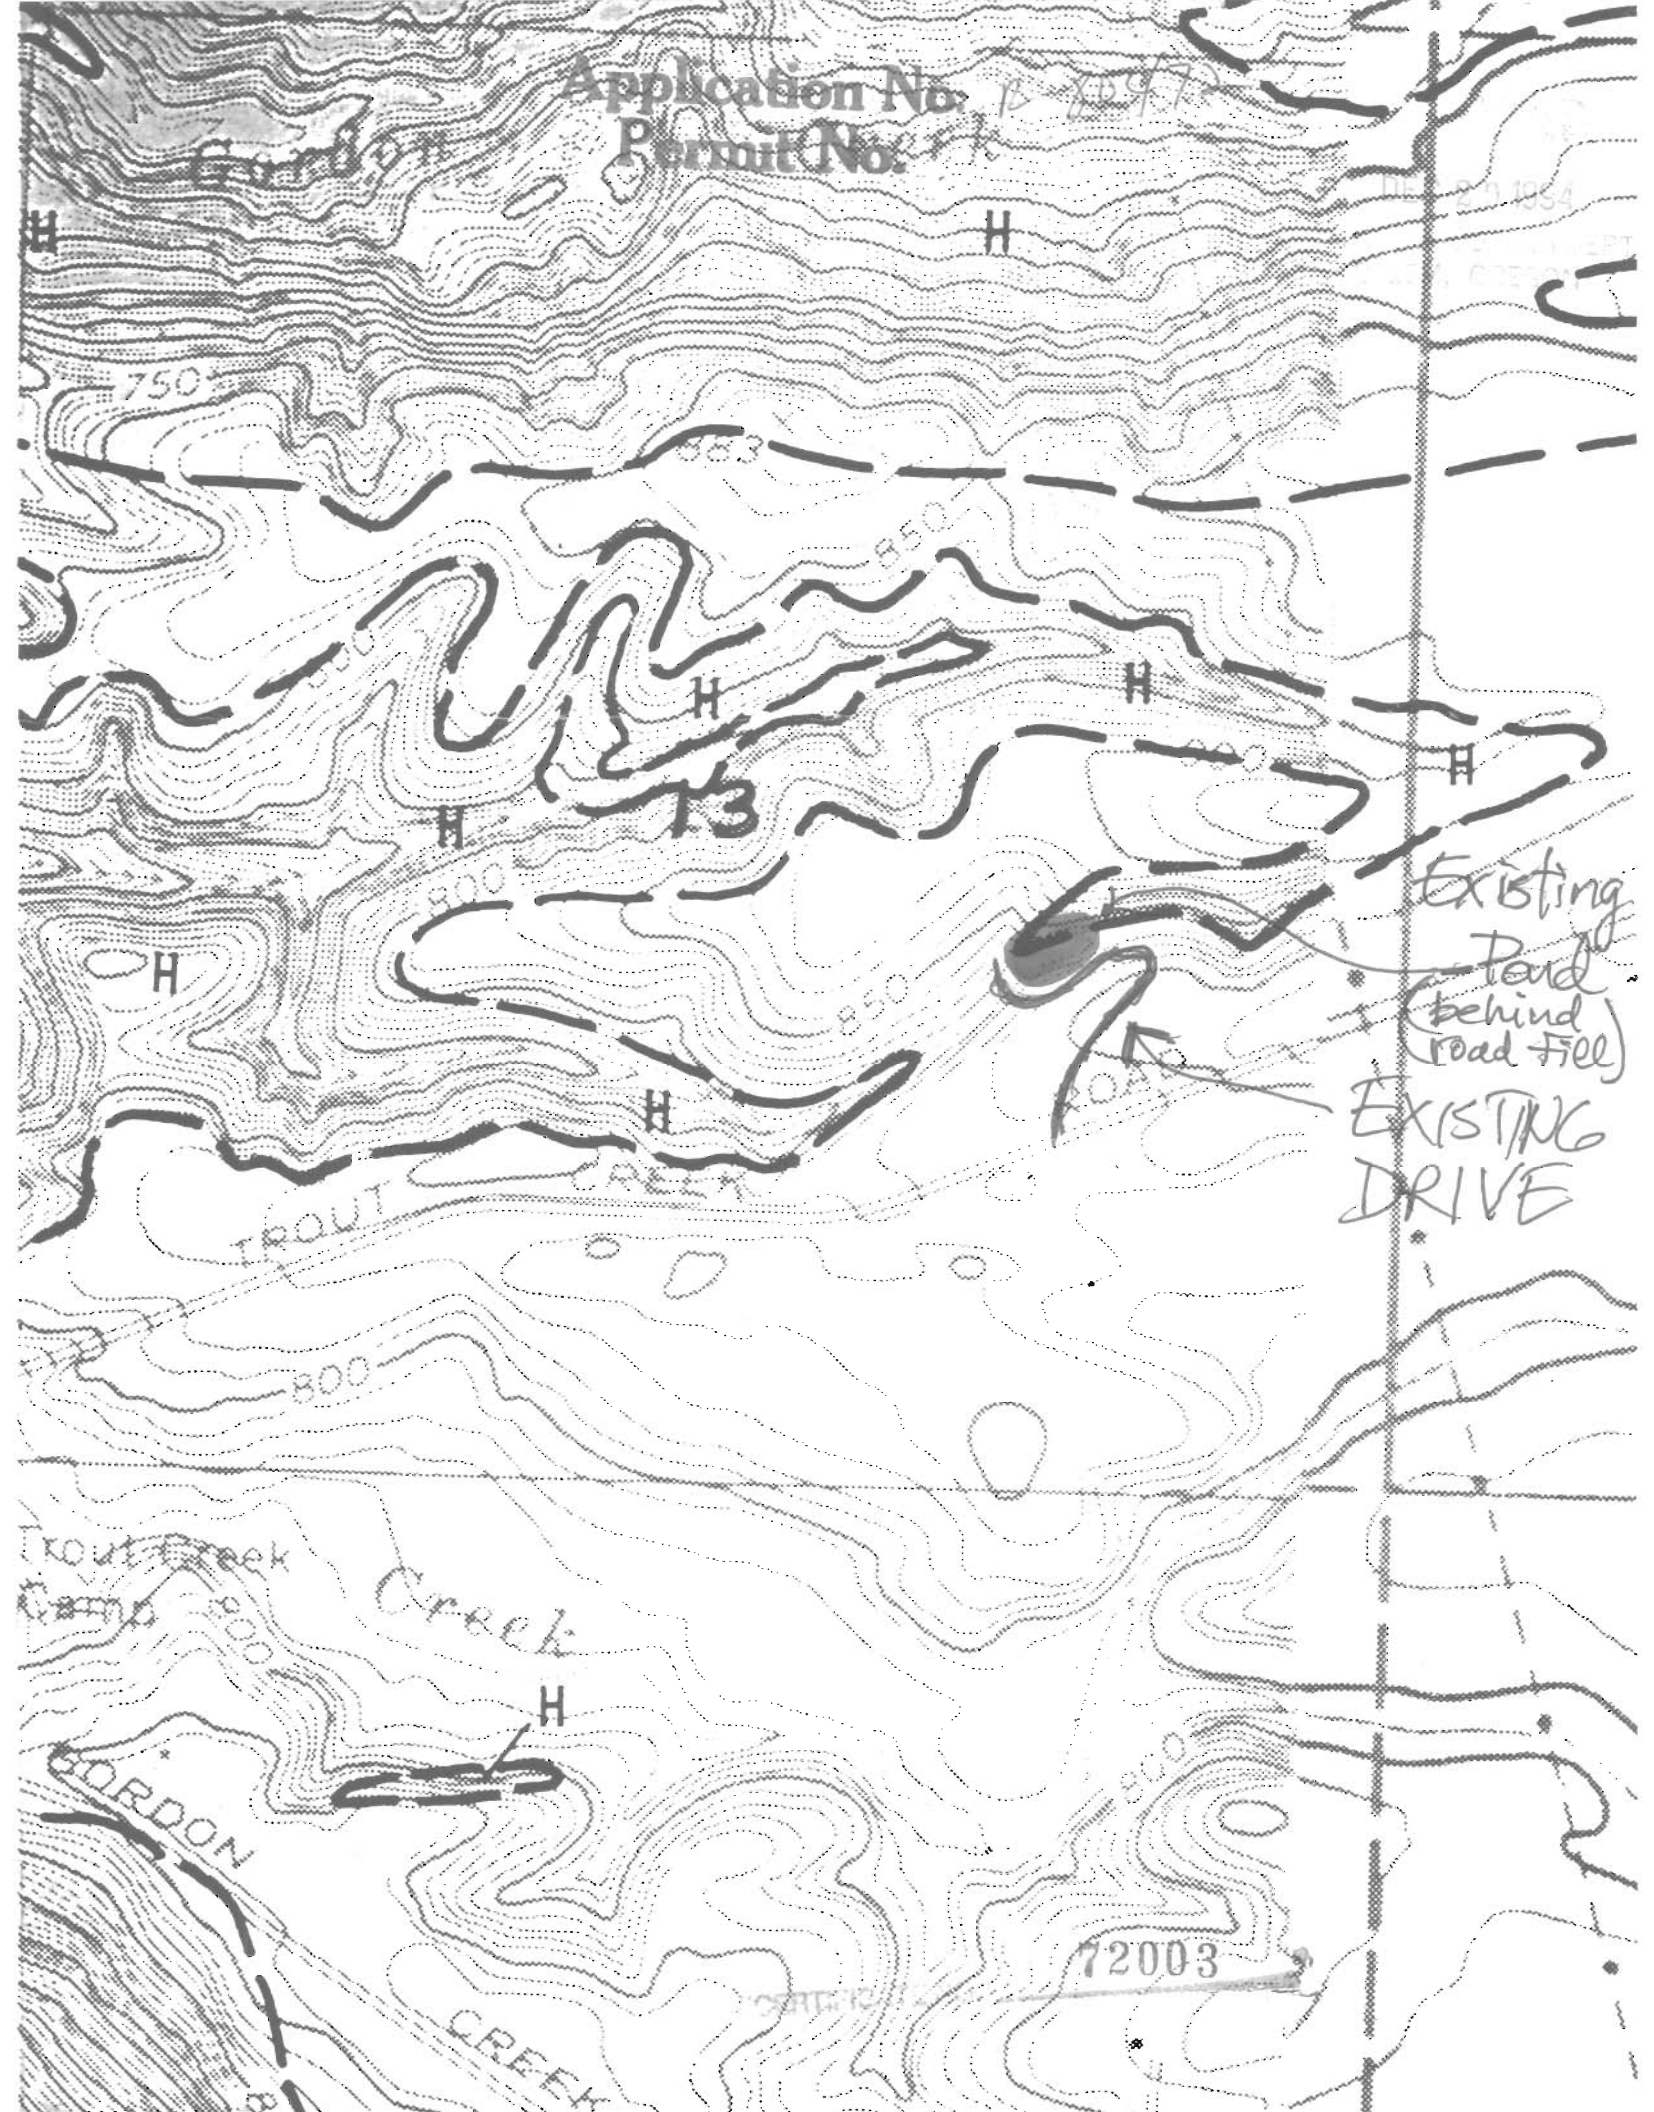

Existing
Pond
(behind
road fill)
EXISTING
DRIVE

72003

40 Ac.

Application No. R 804/72
Permit No. 72003

13

8

13

10

18'

40 Ac.

14

15'

17

Pond

ROAD NO. 1392-60

TROUT CREEK

10'

156.14 Ac.

Water will not be diverted. It is
for fire protection (storage only).

Section 13 1/4 4E Mt. Hood, OR
Tl. 17 2.84 Acres, in said County and State, described as follows:

Beginning at the Northwest corner of that parcel being South 89°01' East, 517.56 Feet and North 68°09' East, 571.02 Feet from a point on the West line of said Southeast Quarter of Sec. 13, the ending point being North 00°22'30" East from the South Quarter Corner of said Sec. 13. Thence North 68°09' East along the Northerly line 235.41 Feet; Thence South 00°38' West along the Easterly line 825.79 Feet; Thence South 68°09' West along the Northerly right-of-way line of Trout Creek Road, County Road No. 1392, 32.47 Feet; Thence North 00°38' East, 382.00 Feet; Thence South 68°09' West, 255.66 Feet; Thence North along the Westerly line 441.00 Feet to the Point of Beginning.