


Application No. 2-80474
Permit No.

RECEIVED
DEC 30 1994
WATER RESOURCES DIVISION
SALEM, OREGON

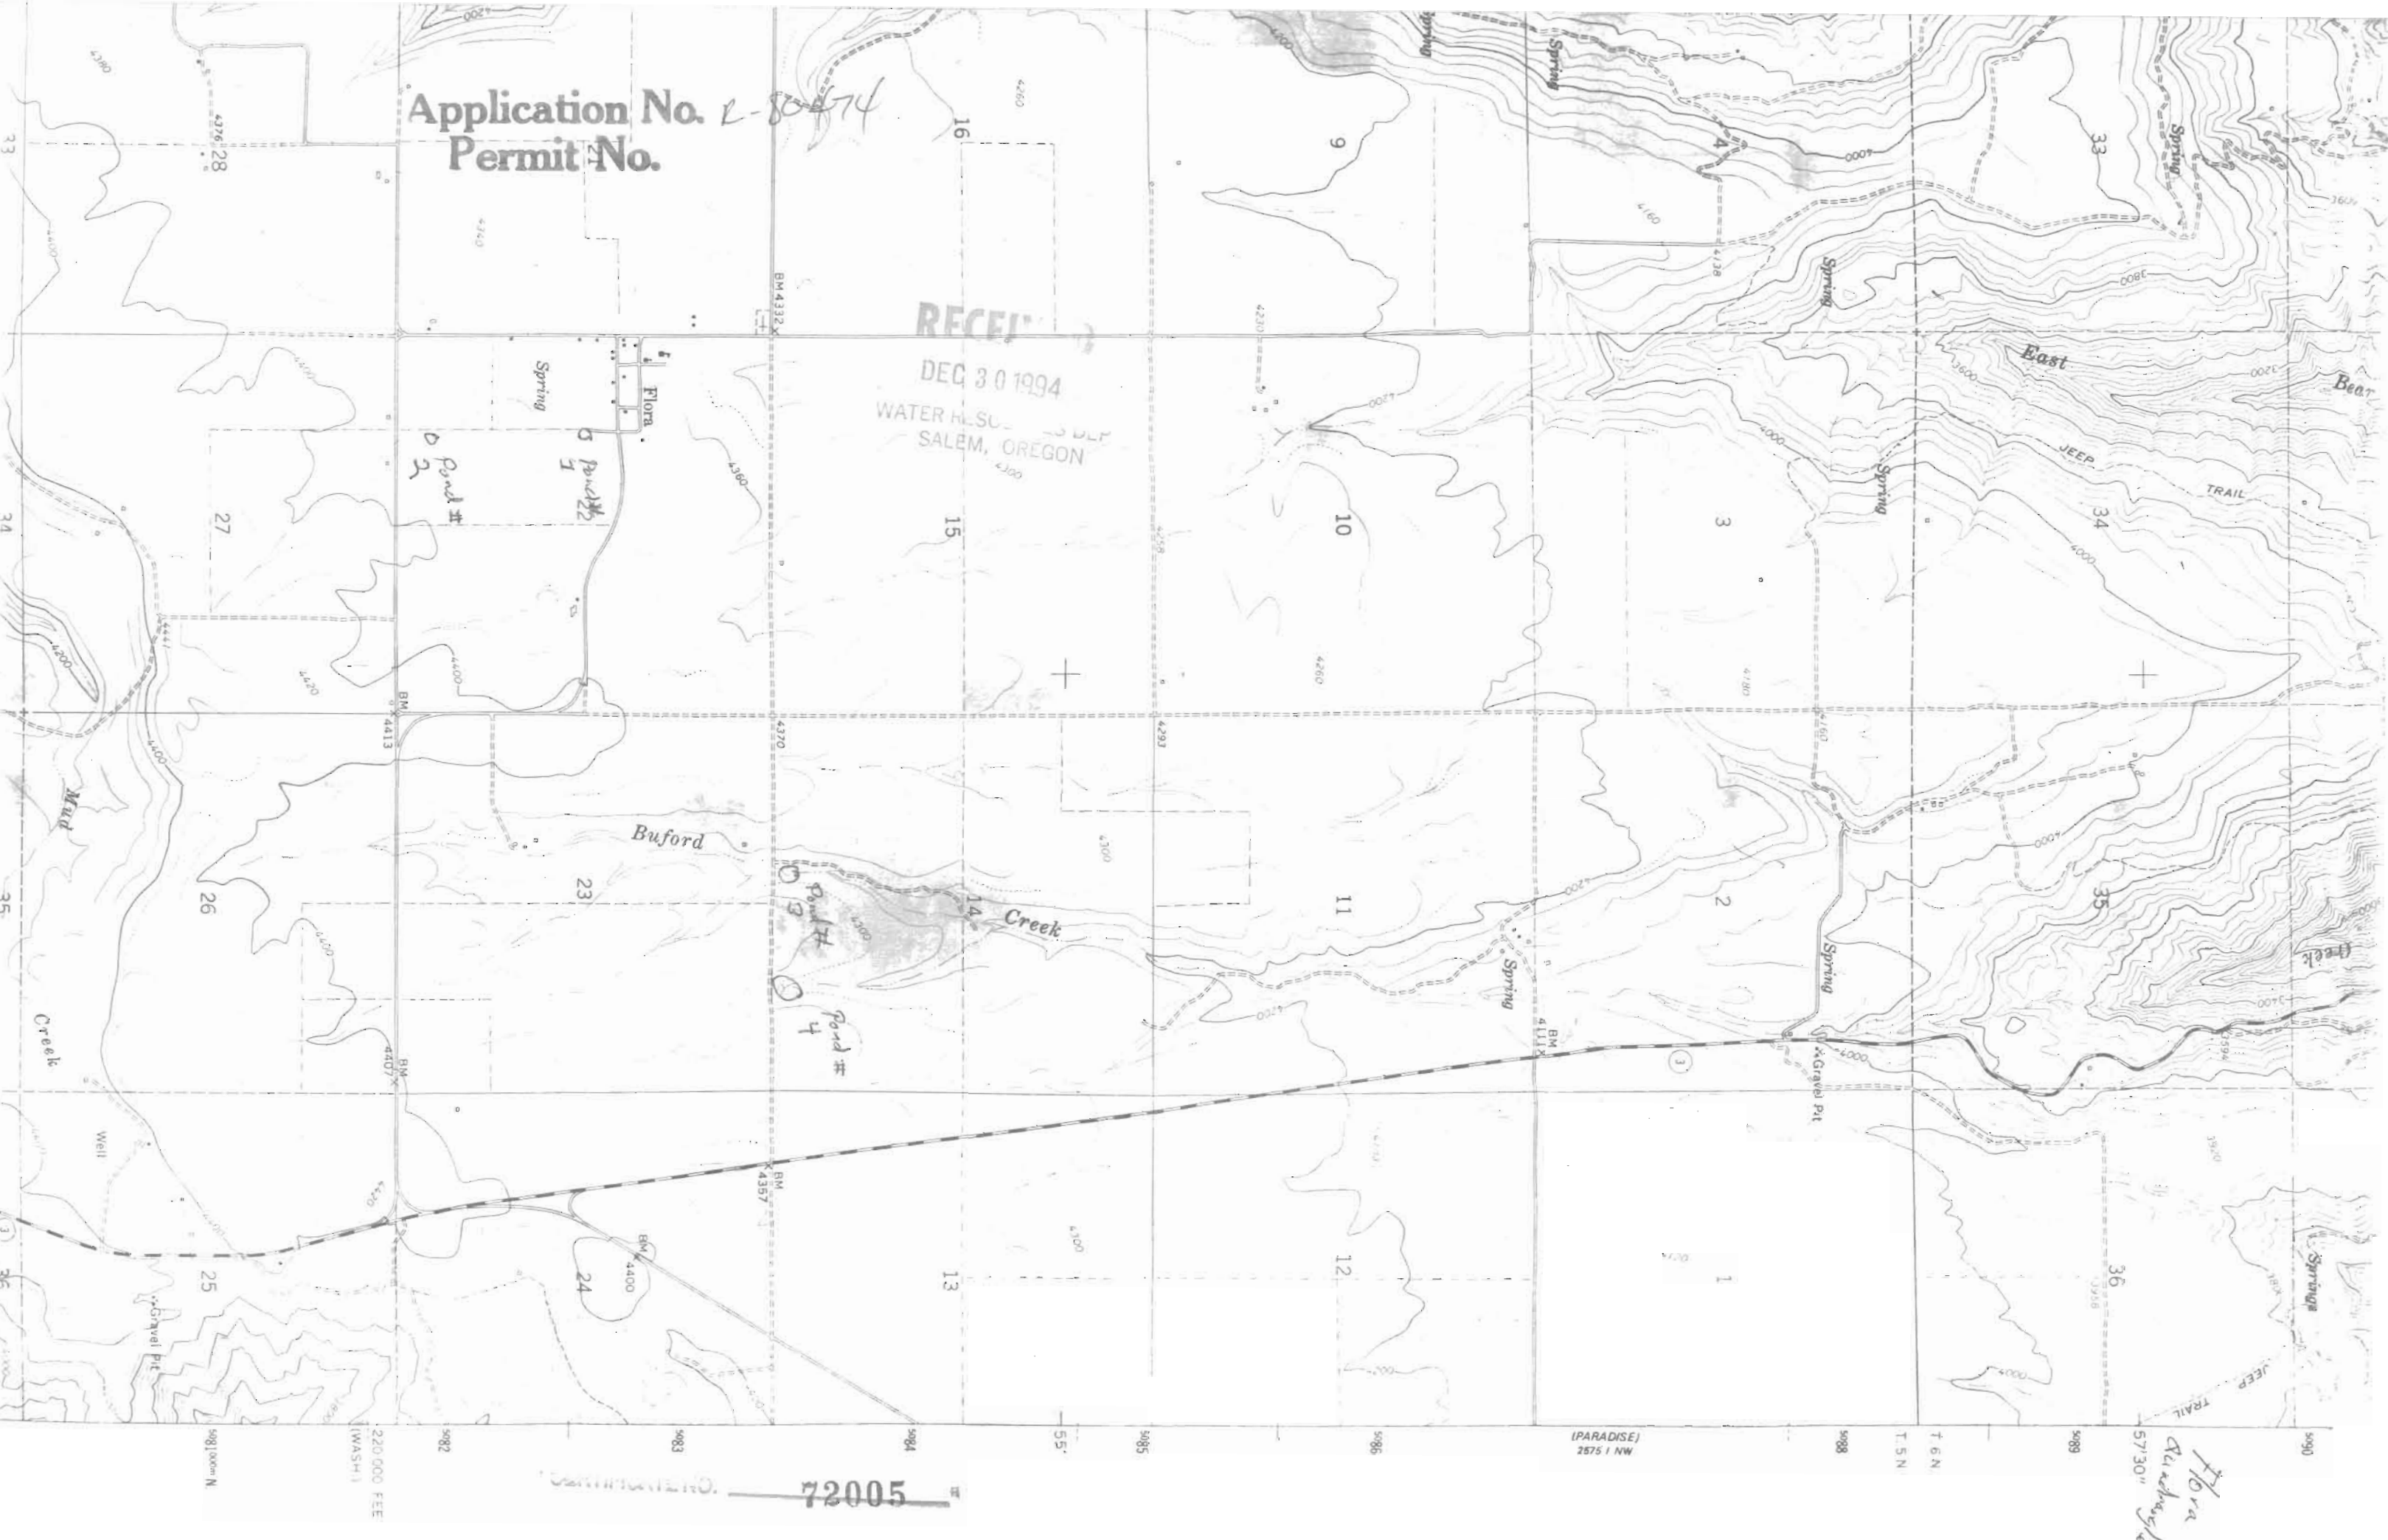

72005

H/O ra
Acres
5730'