

AND TAXATION
USE ONLY

LANE COUNTY

1"=400'

See Map 17 06 15

17 06 22

403 v.o. 400
5-17-93
FOR NOW 001260
1710 17-2531
1-12-95
PAID 600 INTO
P.P. 94-PO563

CERTIFICATE NO. 72008

16 15
21 22
N 894.660
E 1,238.282

CANCELLED
1700
800

15 14
22 23
N 894.660
E 1,238.282

400 800
0 400 800
FEET
KILOMETER

Application No. 1-8477
Permit No.
SCALE 1:9600


22 23
27 28
N 894.660
E 1,238.282

See Map 17 06 21

See Map 17 06 23

RECEIVED
JAN 23 1995
DEPT. OF REVENUE
STATE OF OREGON

21 22
28 27
N 894.660
E 1,238.282

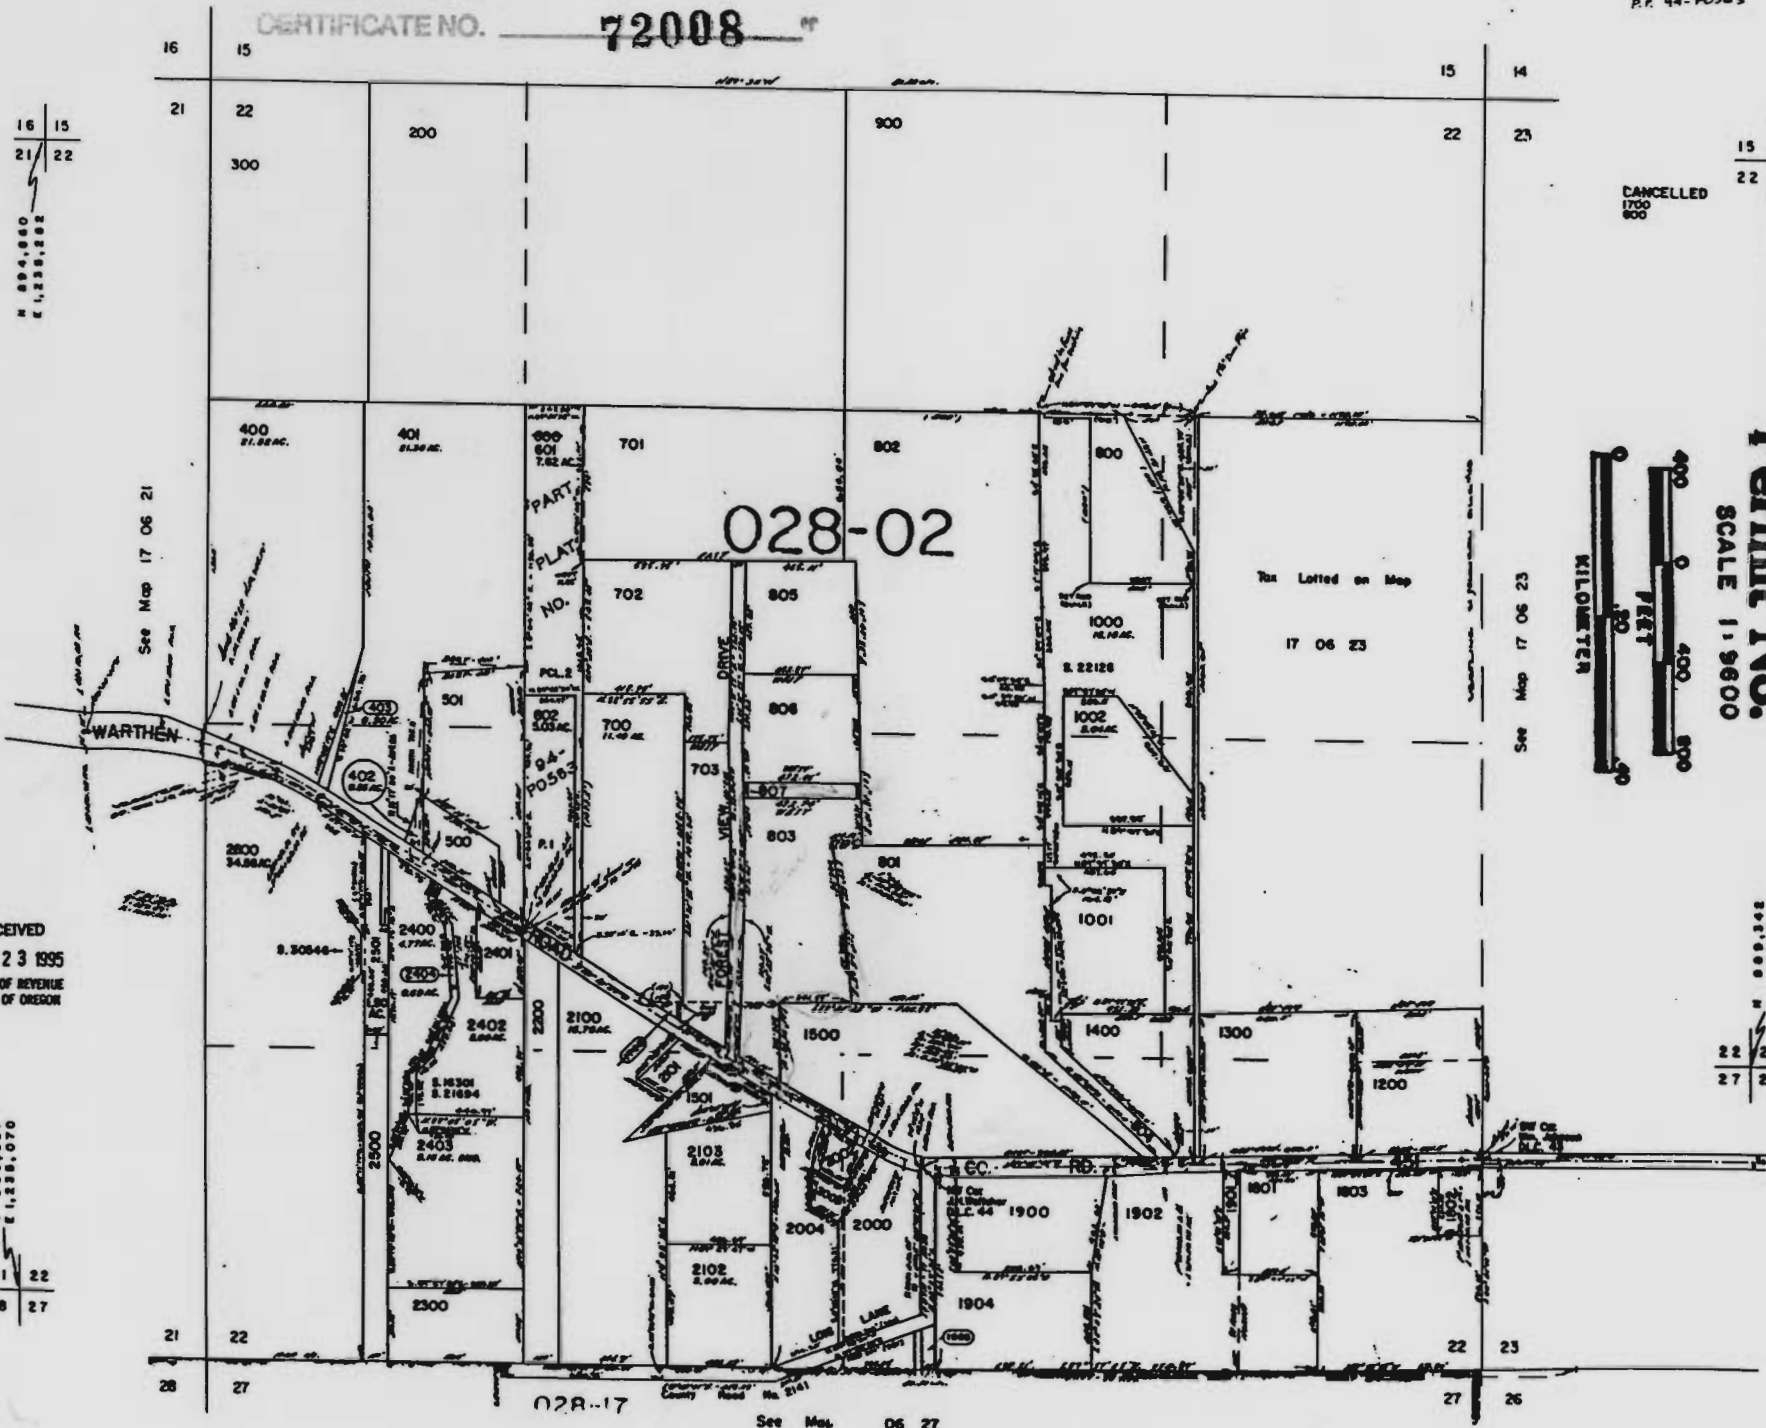


Application No. 2-80477
Permit No.

72008

4

"CERTIFICATE NO."

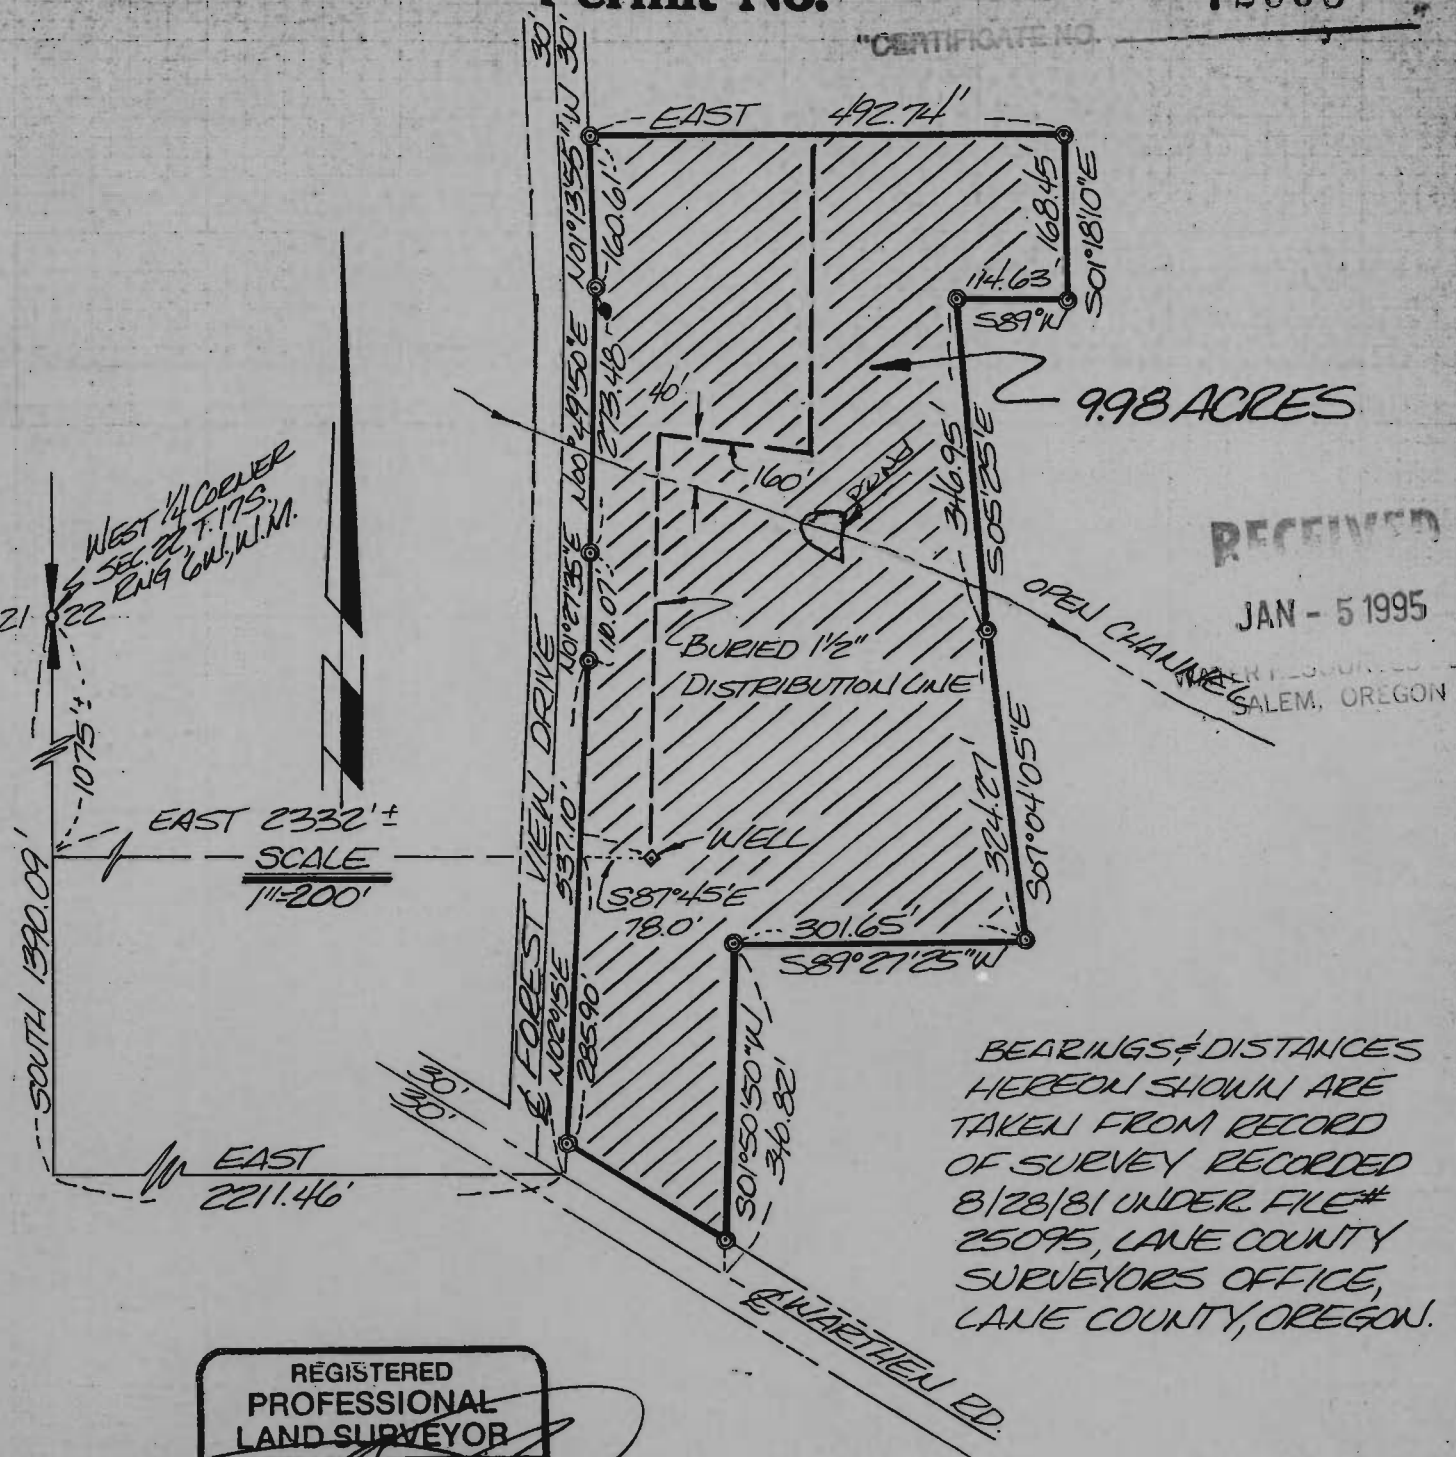

REGISTERED
PROFESSIONAL
LAND SURVEYOR

OREGON
DECEMBER 2, 1983
MONTE P. MONTEITH
2075

7/18/86