



RECEIVED

72011

DEC 29 1994

RESOURCES DEP
SALEM, OREGON

T. 19 S. R. 36 E.W.M.

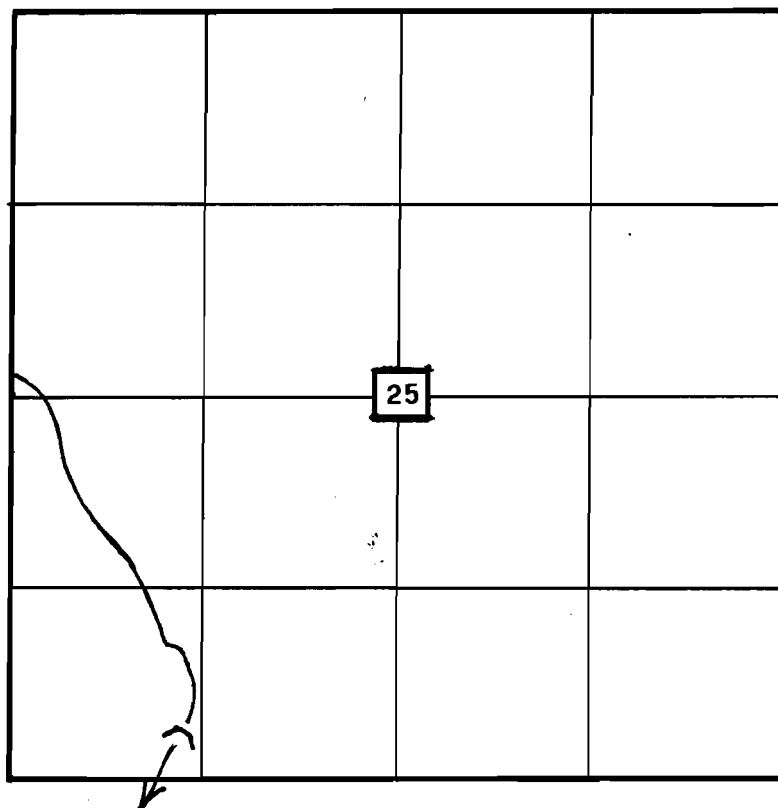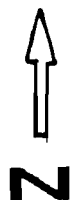

Application No. K-80480
Permit No.

SCALE 4"=1 MILE
S.I. _____
ENG. _____
DRAWN: KP
APPROV: _____

**EAGLE-PICHER
INDUSTRIES INC.**

MINERALS DIVISION

P. O. BOX 12130

RENO

NEVADA 89510

PLANT: **CELATOM**

SEC 25 RESERVOIR

SWSW

DATE: 12/22/94

WORK ORDER NO.

DEPT.

DRAWING NO.:


SHEET OF

72011

CERTIFICATE NO.

RECEIVED


DEC 29 1994

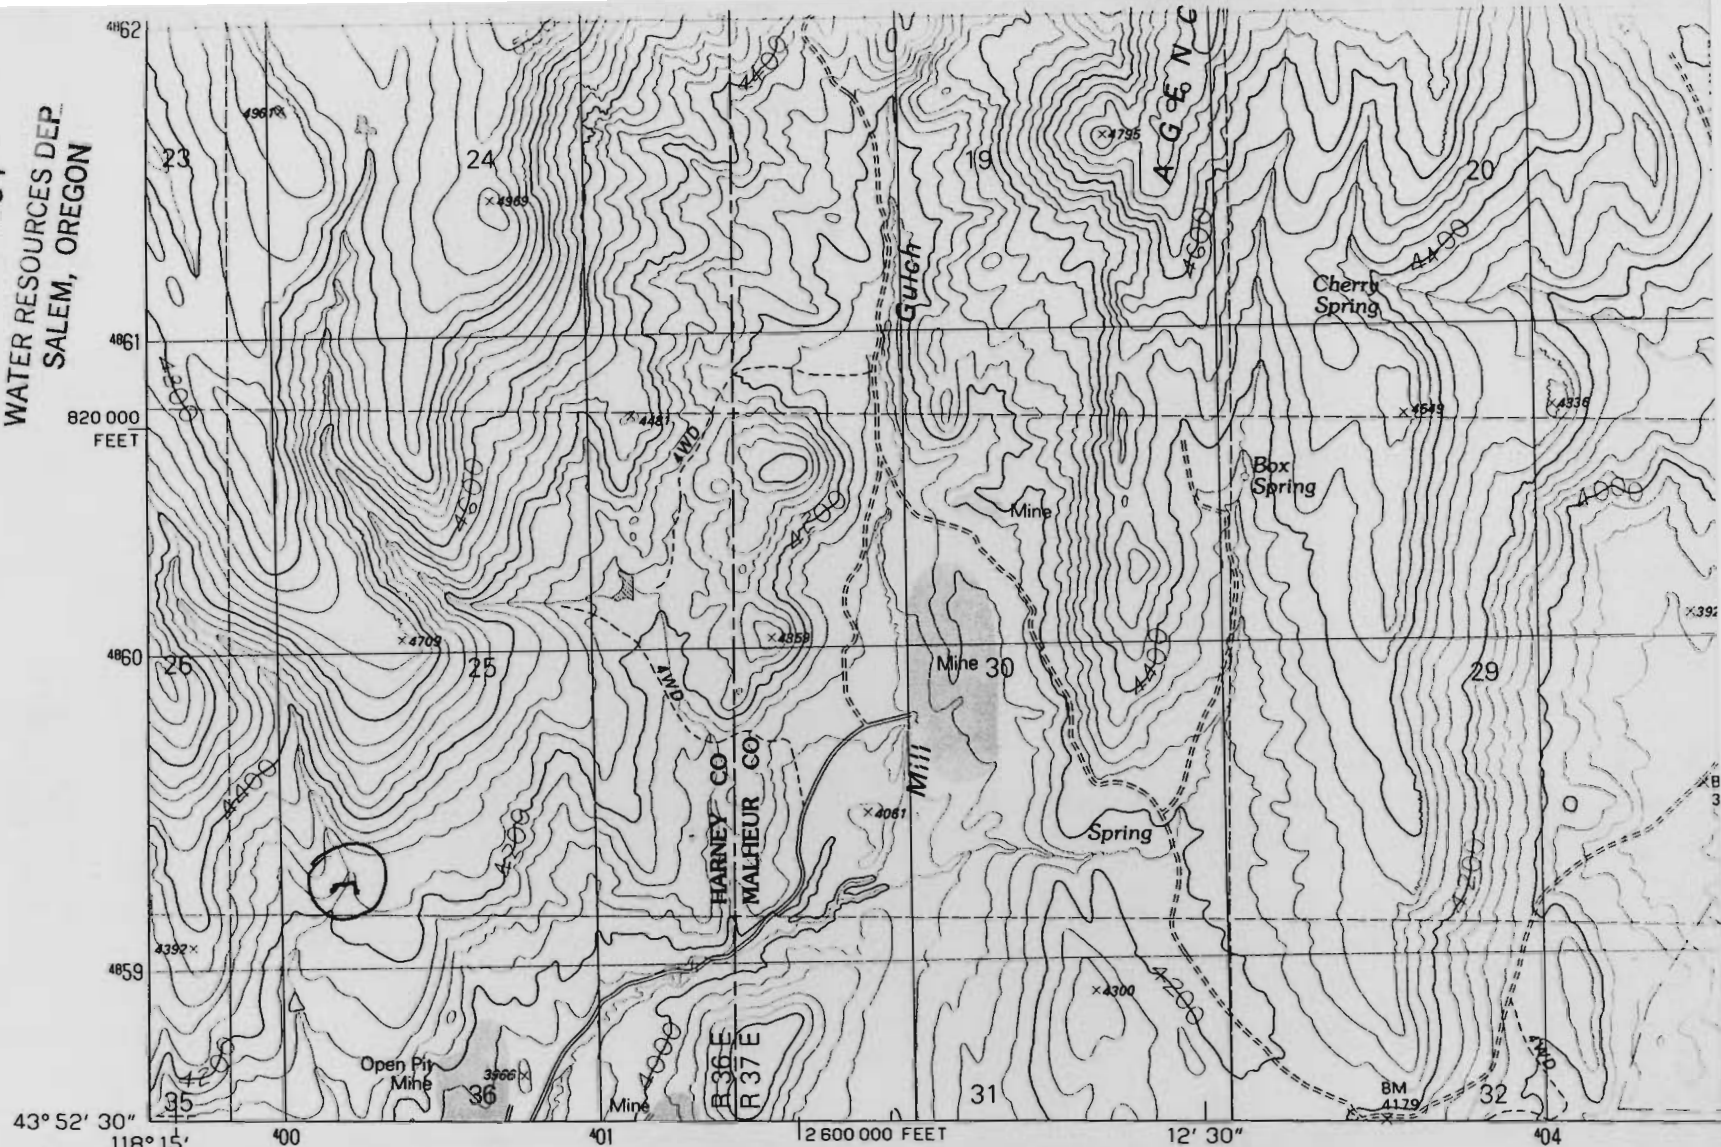WATER RESOURCES DEPT.
SALEM, OREGON

PRODUCED BY THE UNITED STATES GEOLOGICAL SURVEY
 CONTROL BY USGS, NOS/NOAA
 COMPILED FROM AERIAL PHOTOGRAPHS TAKEN 1966
 FIELD CHECKED 1966
 LIMITED REVISION FROM AERIAL PHOTOGRAPHS TAKEN 1985
 FIELD CHECKED 1987 MAP EDITED 1990
 PROJECTION LAMBERT CONFORMAL CONIC
 GRID: 1000-METER UNIVERSAL TRANSVERSE MERCATOR ZONE 11
 10,000-FOOT STATE GRID TICKS OREGON, SOUTH ZONE
 UTM GRID DECLINATION 0°49' WEST
 1990 MAGNETIC NORTH DECLINATION 17' EAST
 VERTICAL DATUM NATIONAL GEODETIC VERTICAL DATUM OF 1929
 HORIZONTAL DATUM 1927 NORTH AMERICAN DATUM
 To place on the predicted North American Datum of 1983,
 move the projection lines as shown by dashed corner ticks
 (17 meters north and 82 meters east)
 There may be private inholdings within the boundaries of any
 Federal and State Reservations shown on this map
 Public Land Survey System is shown as published in 1966 and
 verified or supplemented in 1987

PROVISIONAL MAP
 Produced from original
 manuscript drawings. Infor-
 mation shown as of date of
 field check. T

SCALE

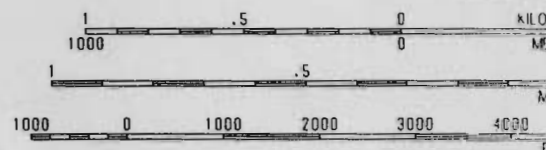

CONTOUR INT

To convert feet to m
 To convert meters to

THIS MAP COMPLIES WITH NATION
 FOR SALE BY U.S. GEOLOGICAL S
 OR RESTON,