


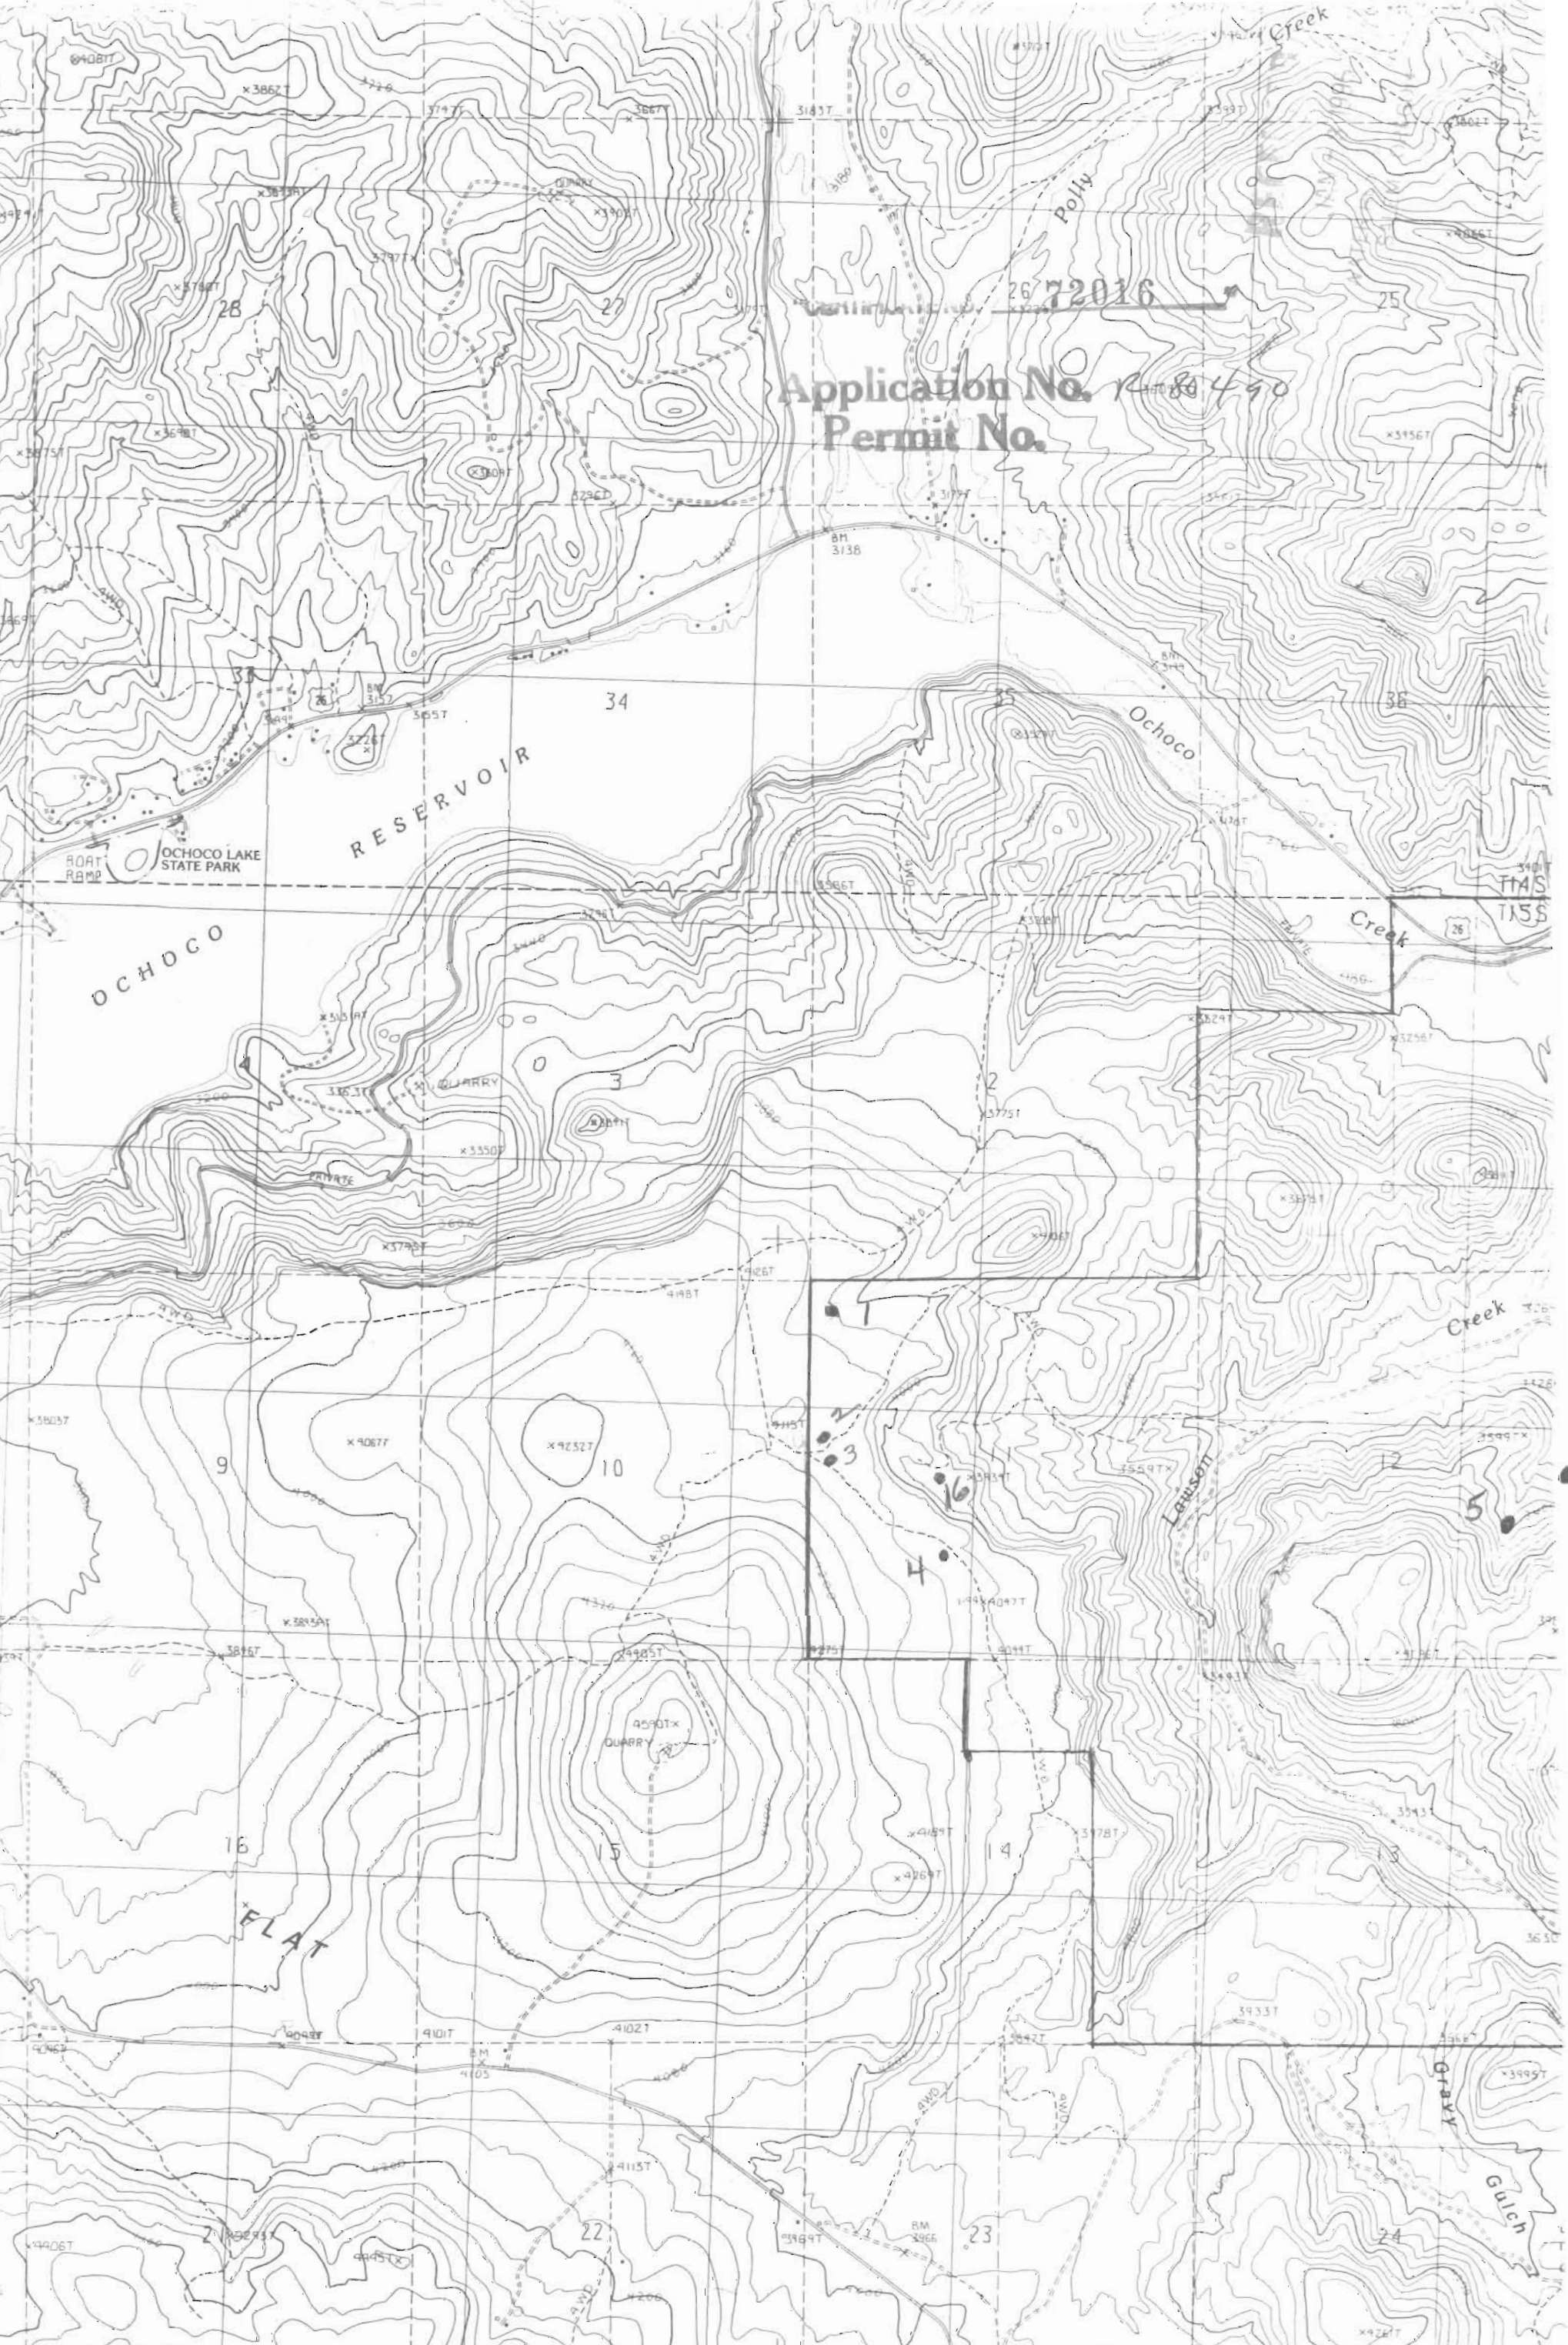


Application No. *R-80490*
Permit No. *2672016*

SCALE 1:24 000




Ochocho Reservoir, OR.
April 1990

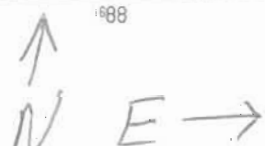

ROAD LEGEND



Application No. E-80490
Permit No.

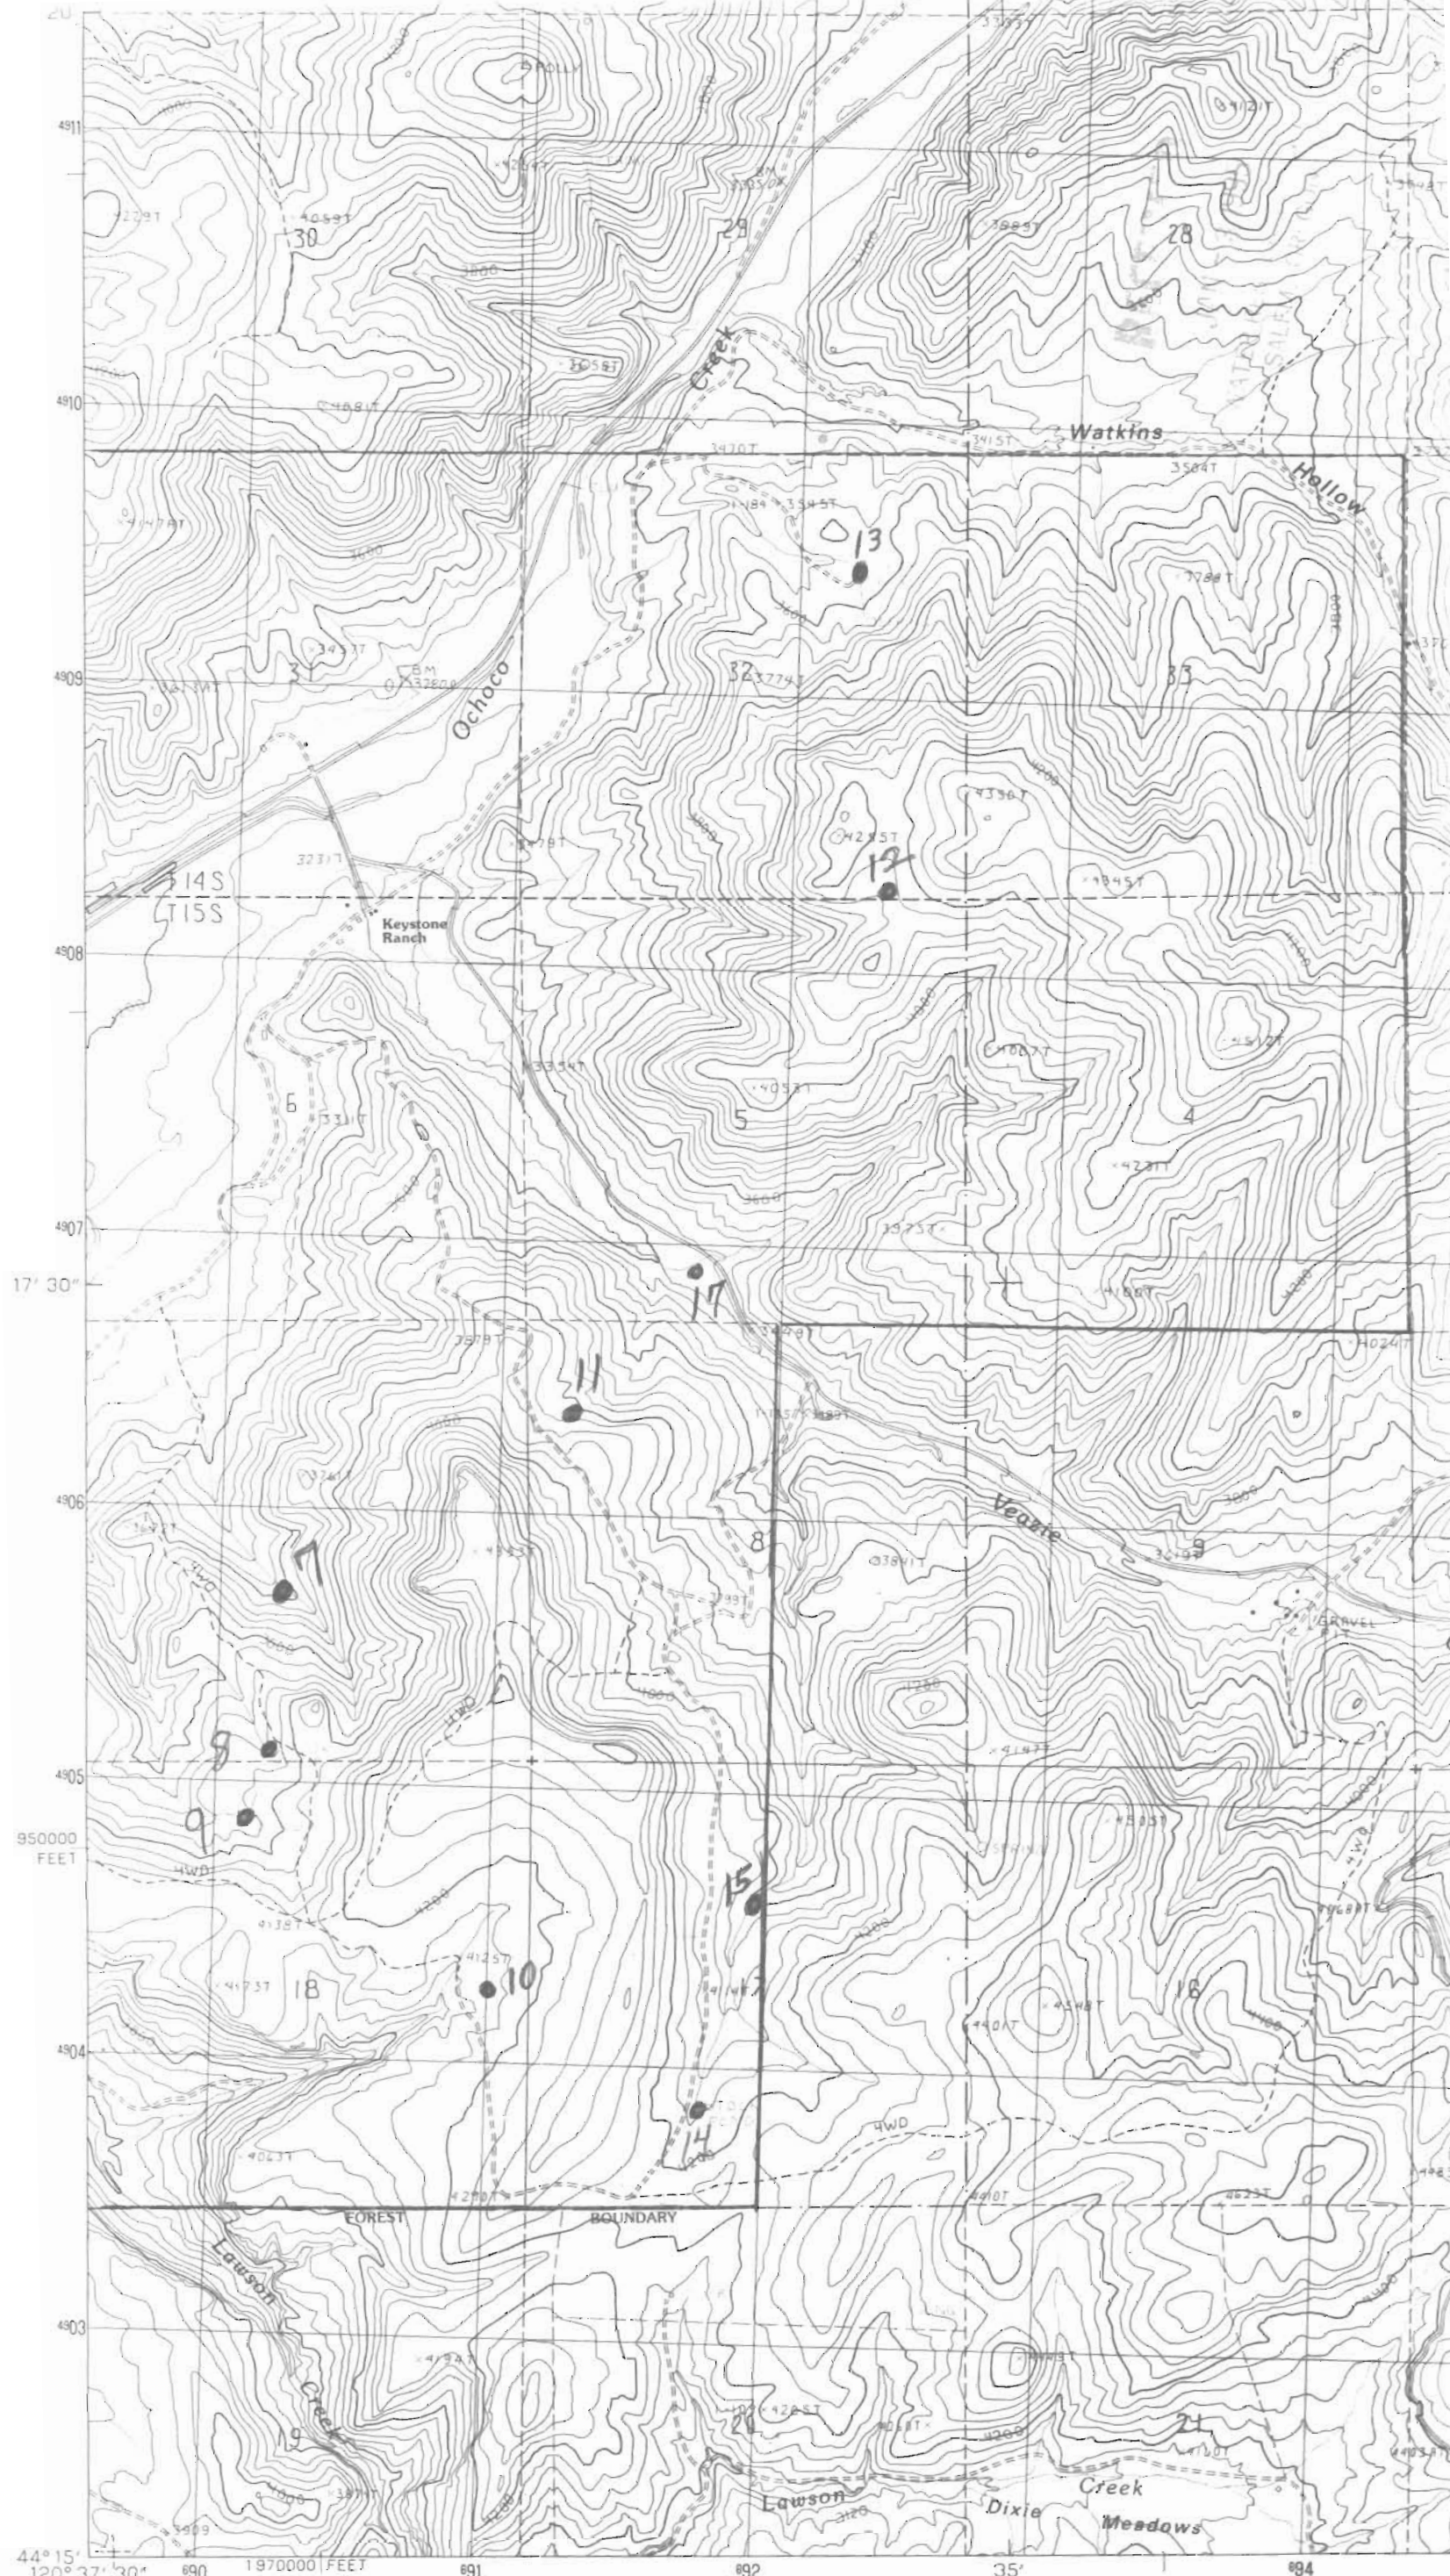

Cadle Butte
Oregon
Quad 1990

PRODUCED BY THE UNITED STATES GEOLOGICAL SURVEY
CONTROL BY USGS AND NOS/NOAA
COMPILED FROM AERIAL PHOTOGRAPHS TAKEN 1984
FIELD CHECKED 1986. MAP EDITED 1990
PROJECTION LAMBERT CONFORMAL CONIC
GRID: 1000-METER UNIVERSAL TRANSVERSE MERCATOR, ZONE 10
10,000-FOOT STATE GRID TICKS, OREGON, SOUTH ZONE
UTM GRID DECLINATION 1°42' EAST
1990 MAGNETIC NORTH DECLINATION 18°00' EAST
VERTICAL DATUM NATIONAL GEODETIC VERTICAL DATUM OF 1929
HORIZONTAL DATUM 1927 NORTH AMERICAN DATUM

72016

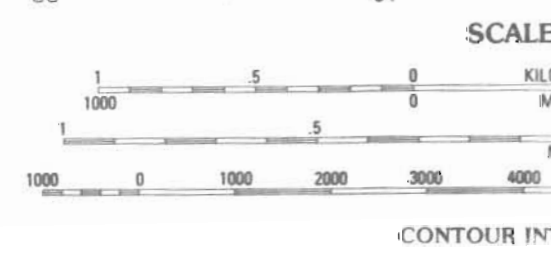

CONTOUR IN