


Legend Pond 21

RECEIVED

JAN - 3 1995

WATER RESOURCES DEPT
SALEM, OREGON

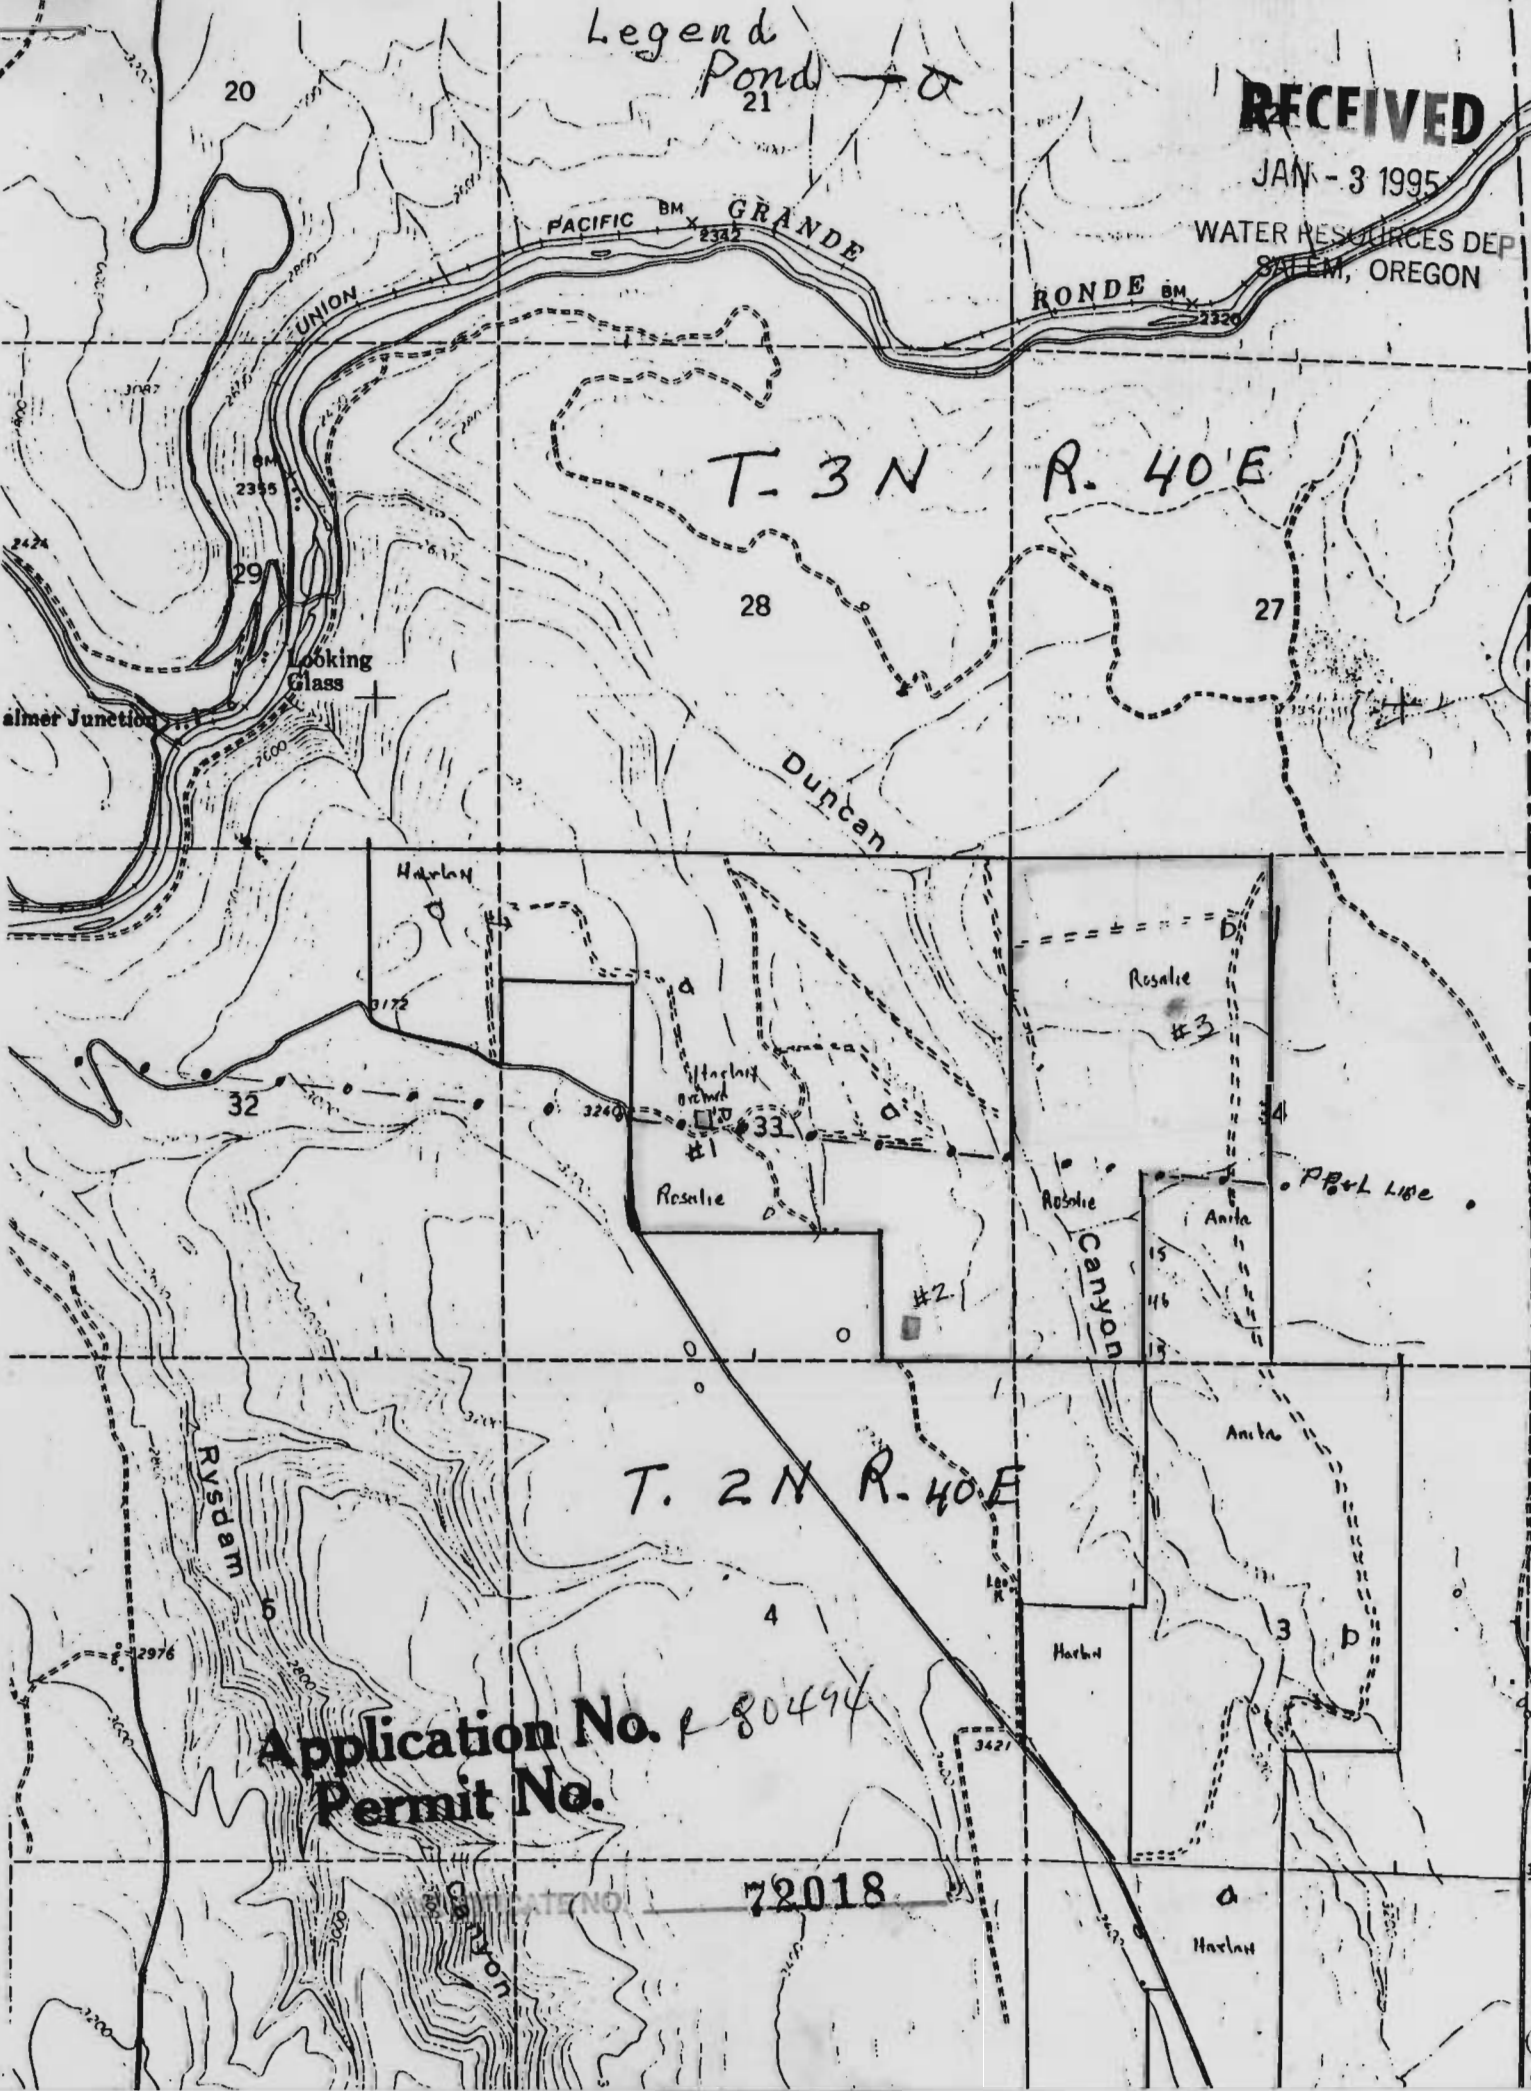

Application No. 80494
Permit No.

72018