Pond "A"

DEC 2 9 1994

WATER
SALEM, OREGON
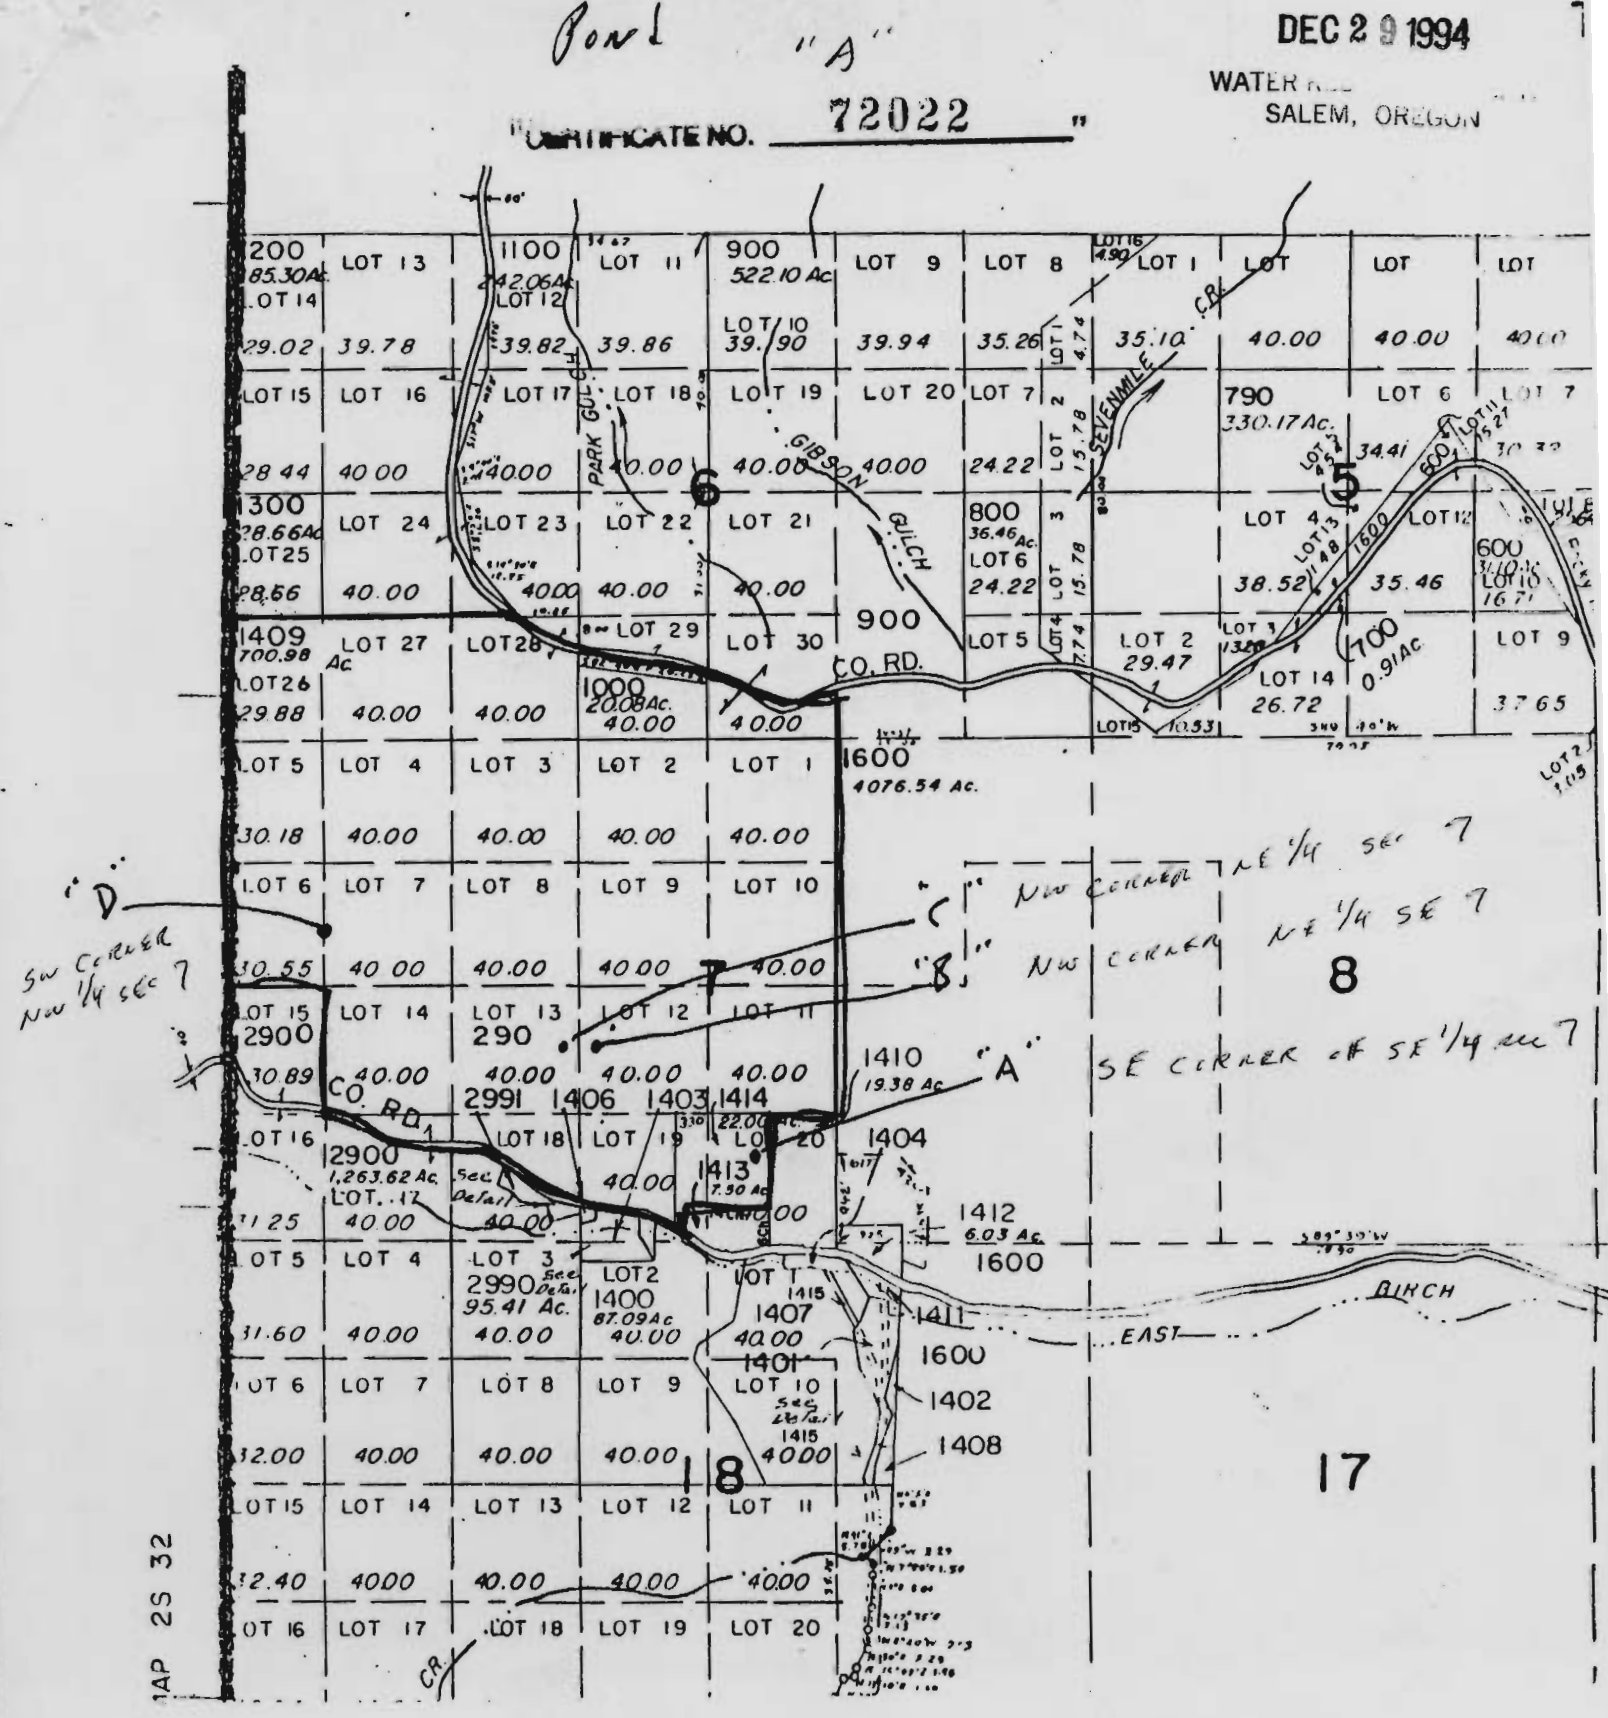
"CERTIFICATE NO. 72022"