

RECEIVED


DEC 29 1994

WATER RESOURCES DEPT
SALEM, OREGON

WRS 8-2-94

Photo 1978

T12S R1W S30

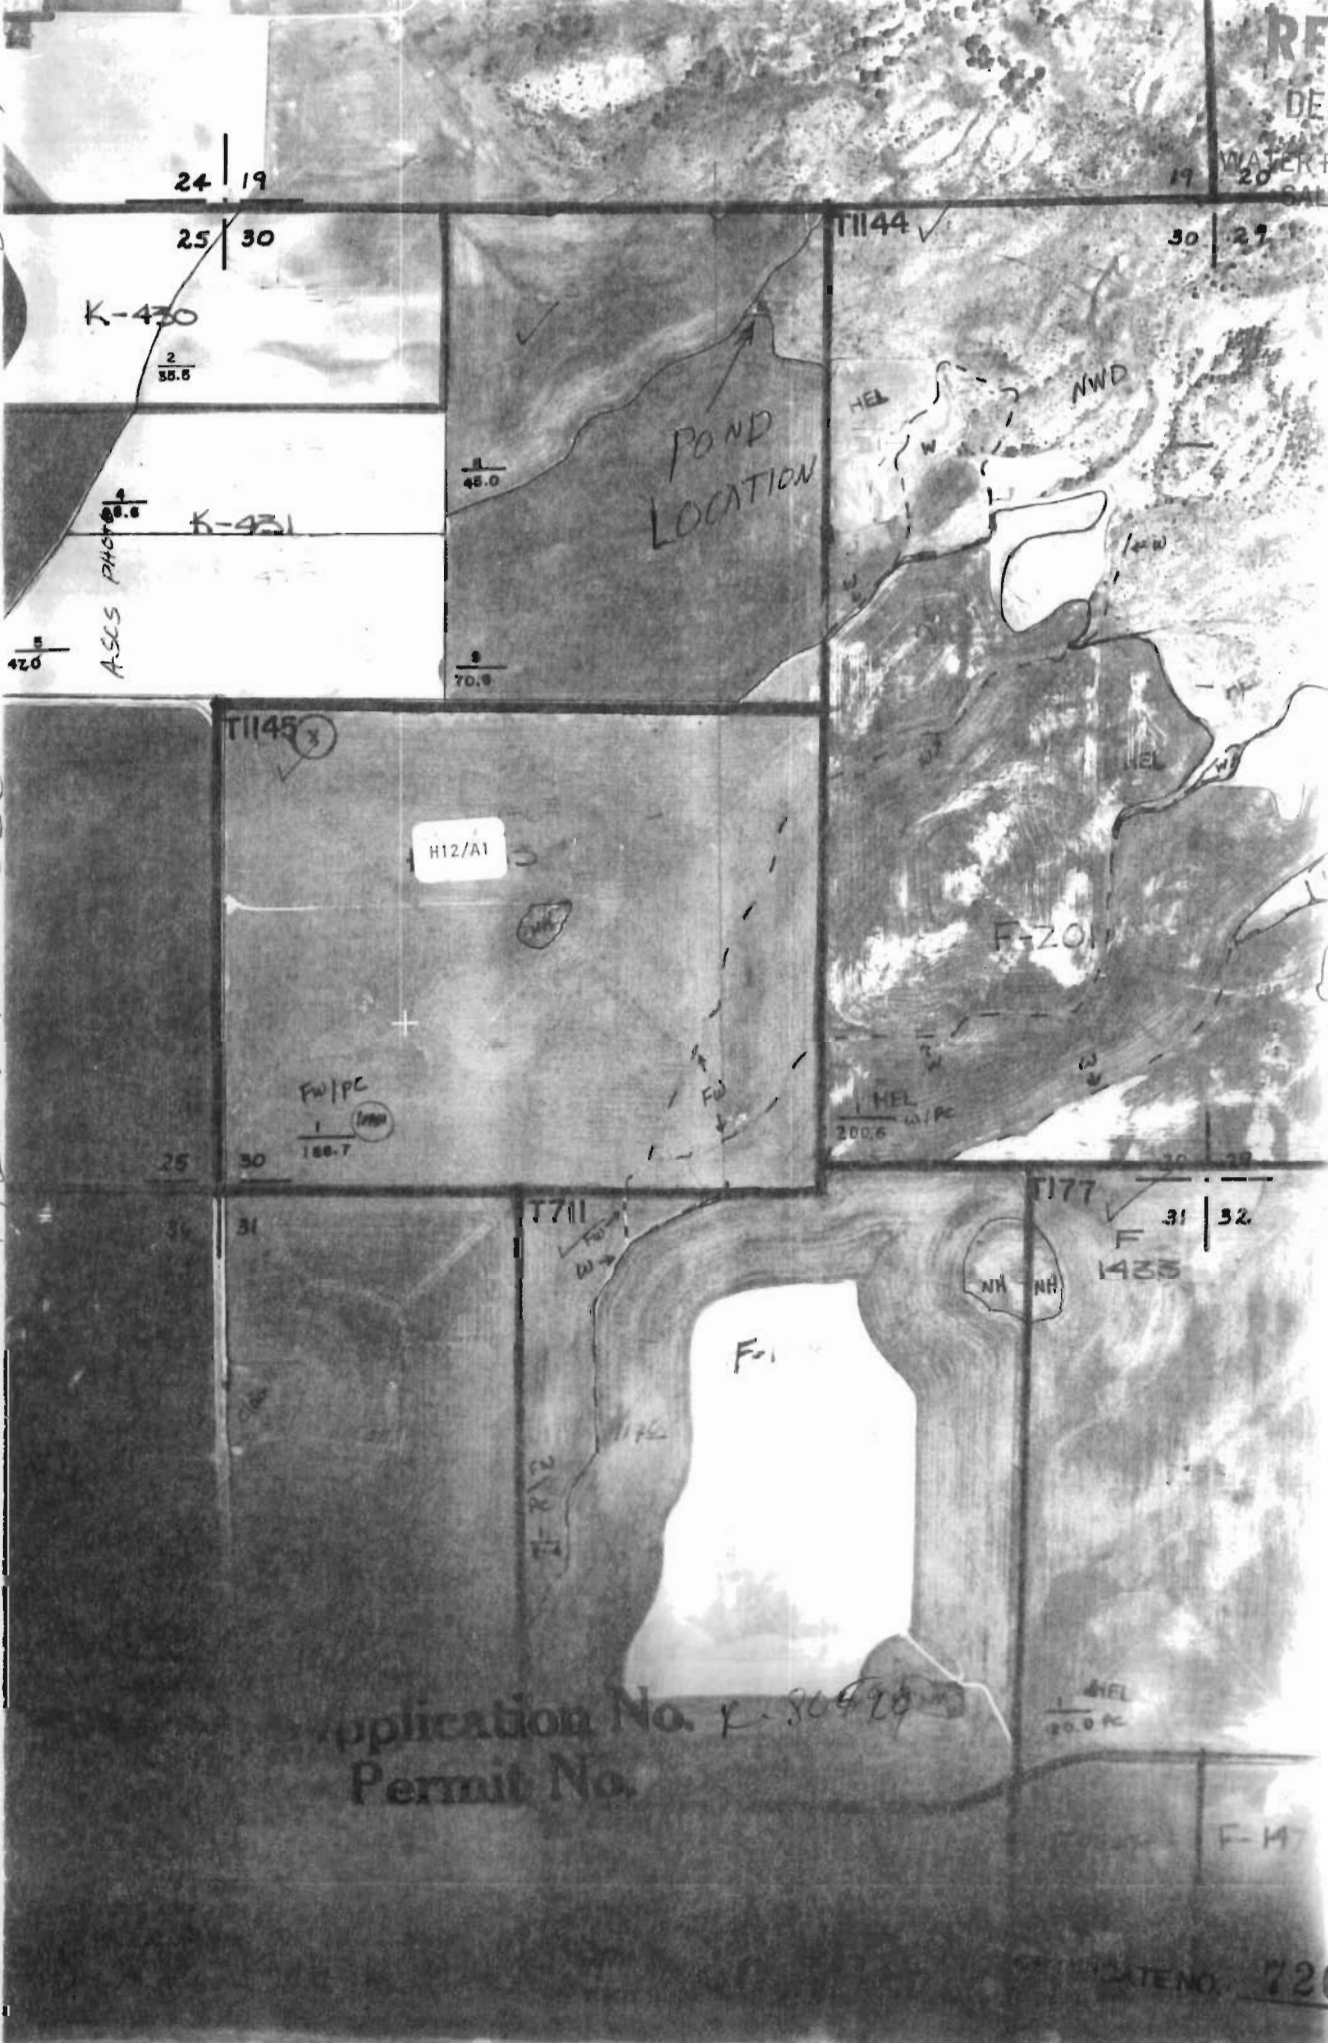

Application No. 80420
Permit No.

72024