



Fidelity National Title Co. of Oregon

RECEIVED

JAN - 3 1995

WATER RESOURCES DEPT.
SALEM, OREGON


The sketch below is made solely for the purpose of assisting in locating said premises and the Company assumes no liability for variations, if any, in dimensions and location ascertained by actual survey.

RECEIVED

JUN 21 1995

WATER RESOURCES DEPT.
SALEM, OREGON

23-14

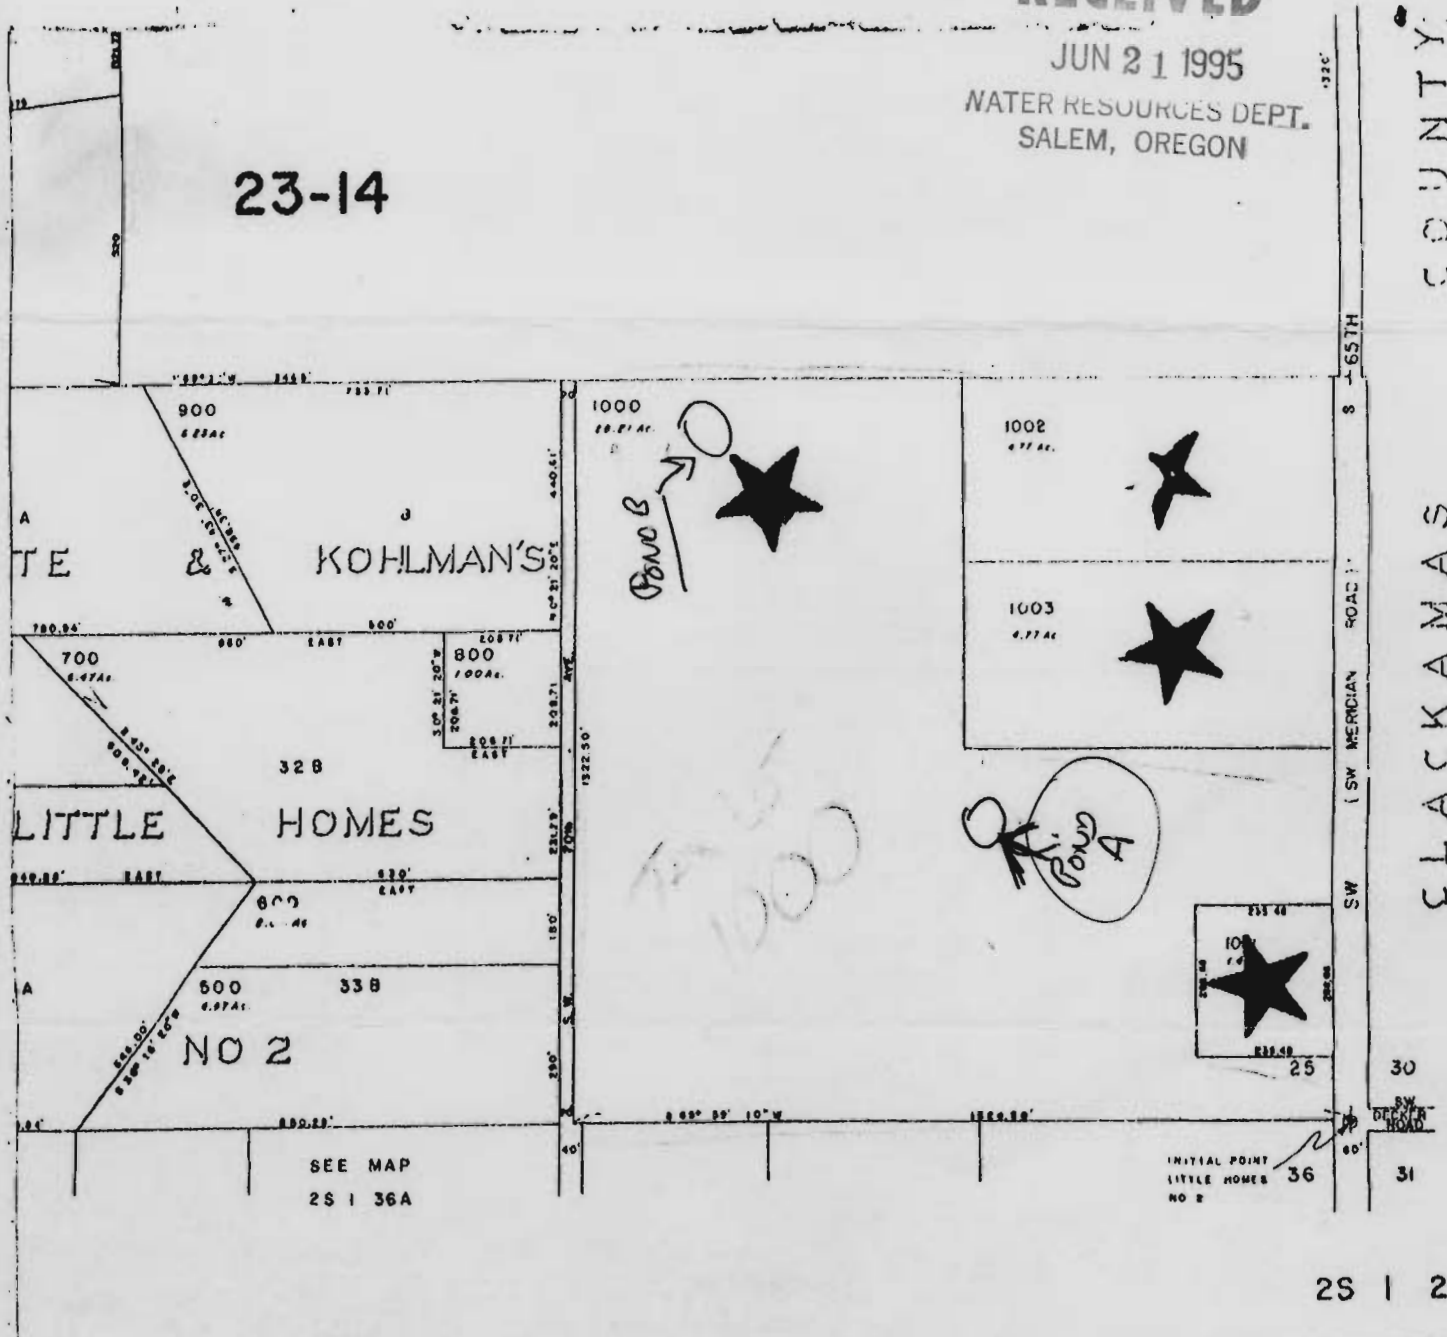

FILED 17-04-89 DEPARTMENT OF ASSESSMENT

Application No. R-80509
Permit No.

CERTIFICATE NO. 72030

2S | 25D