


Application No. 2
Permit No.

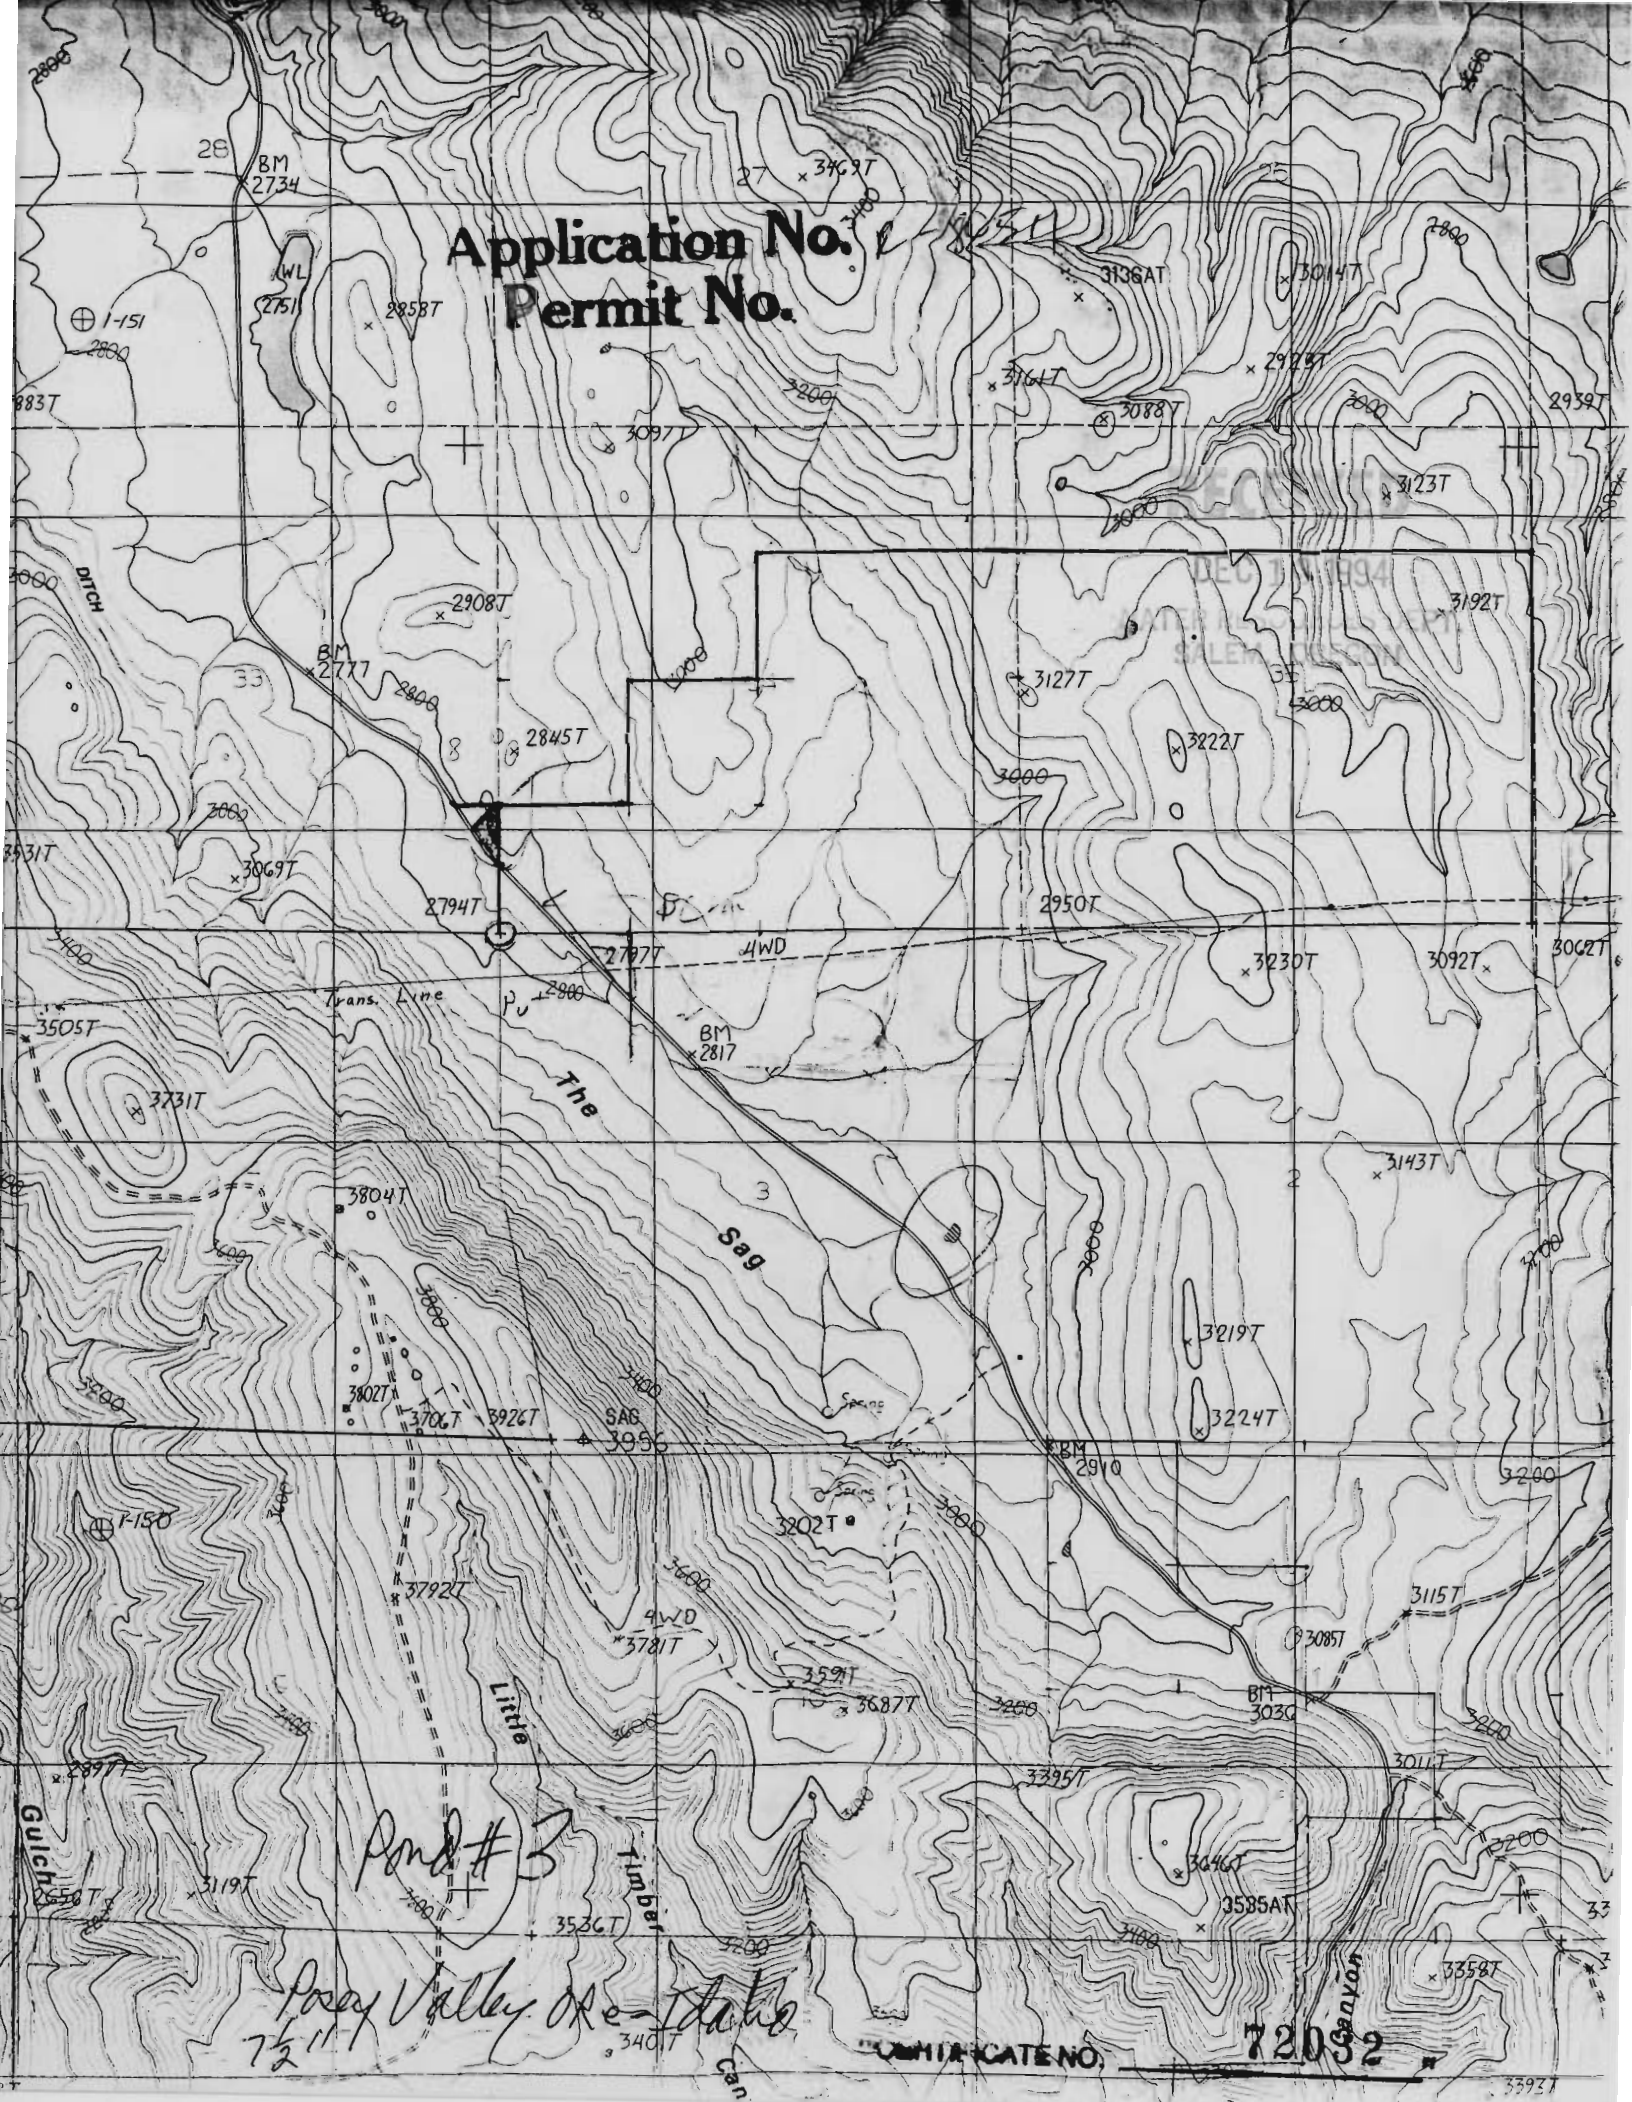

Pond #3

Posy Valley, Ore. Idaho
72032

UNITED STATES

72032