

HB 2153


T. 2 S.
T. 3 S.

T. 35 R-37

top lot
1200

T. 3 S.
R-37

JACK and OPAL M. COURTNEY
HB 2153

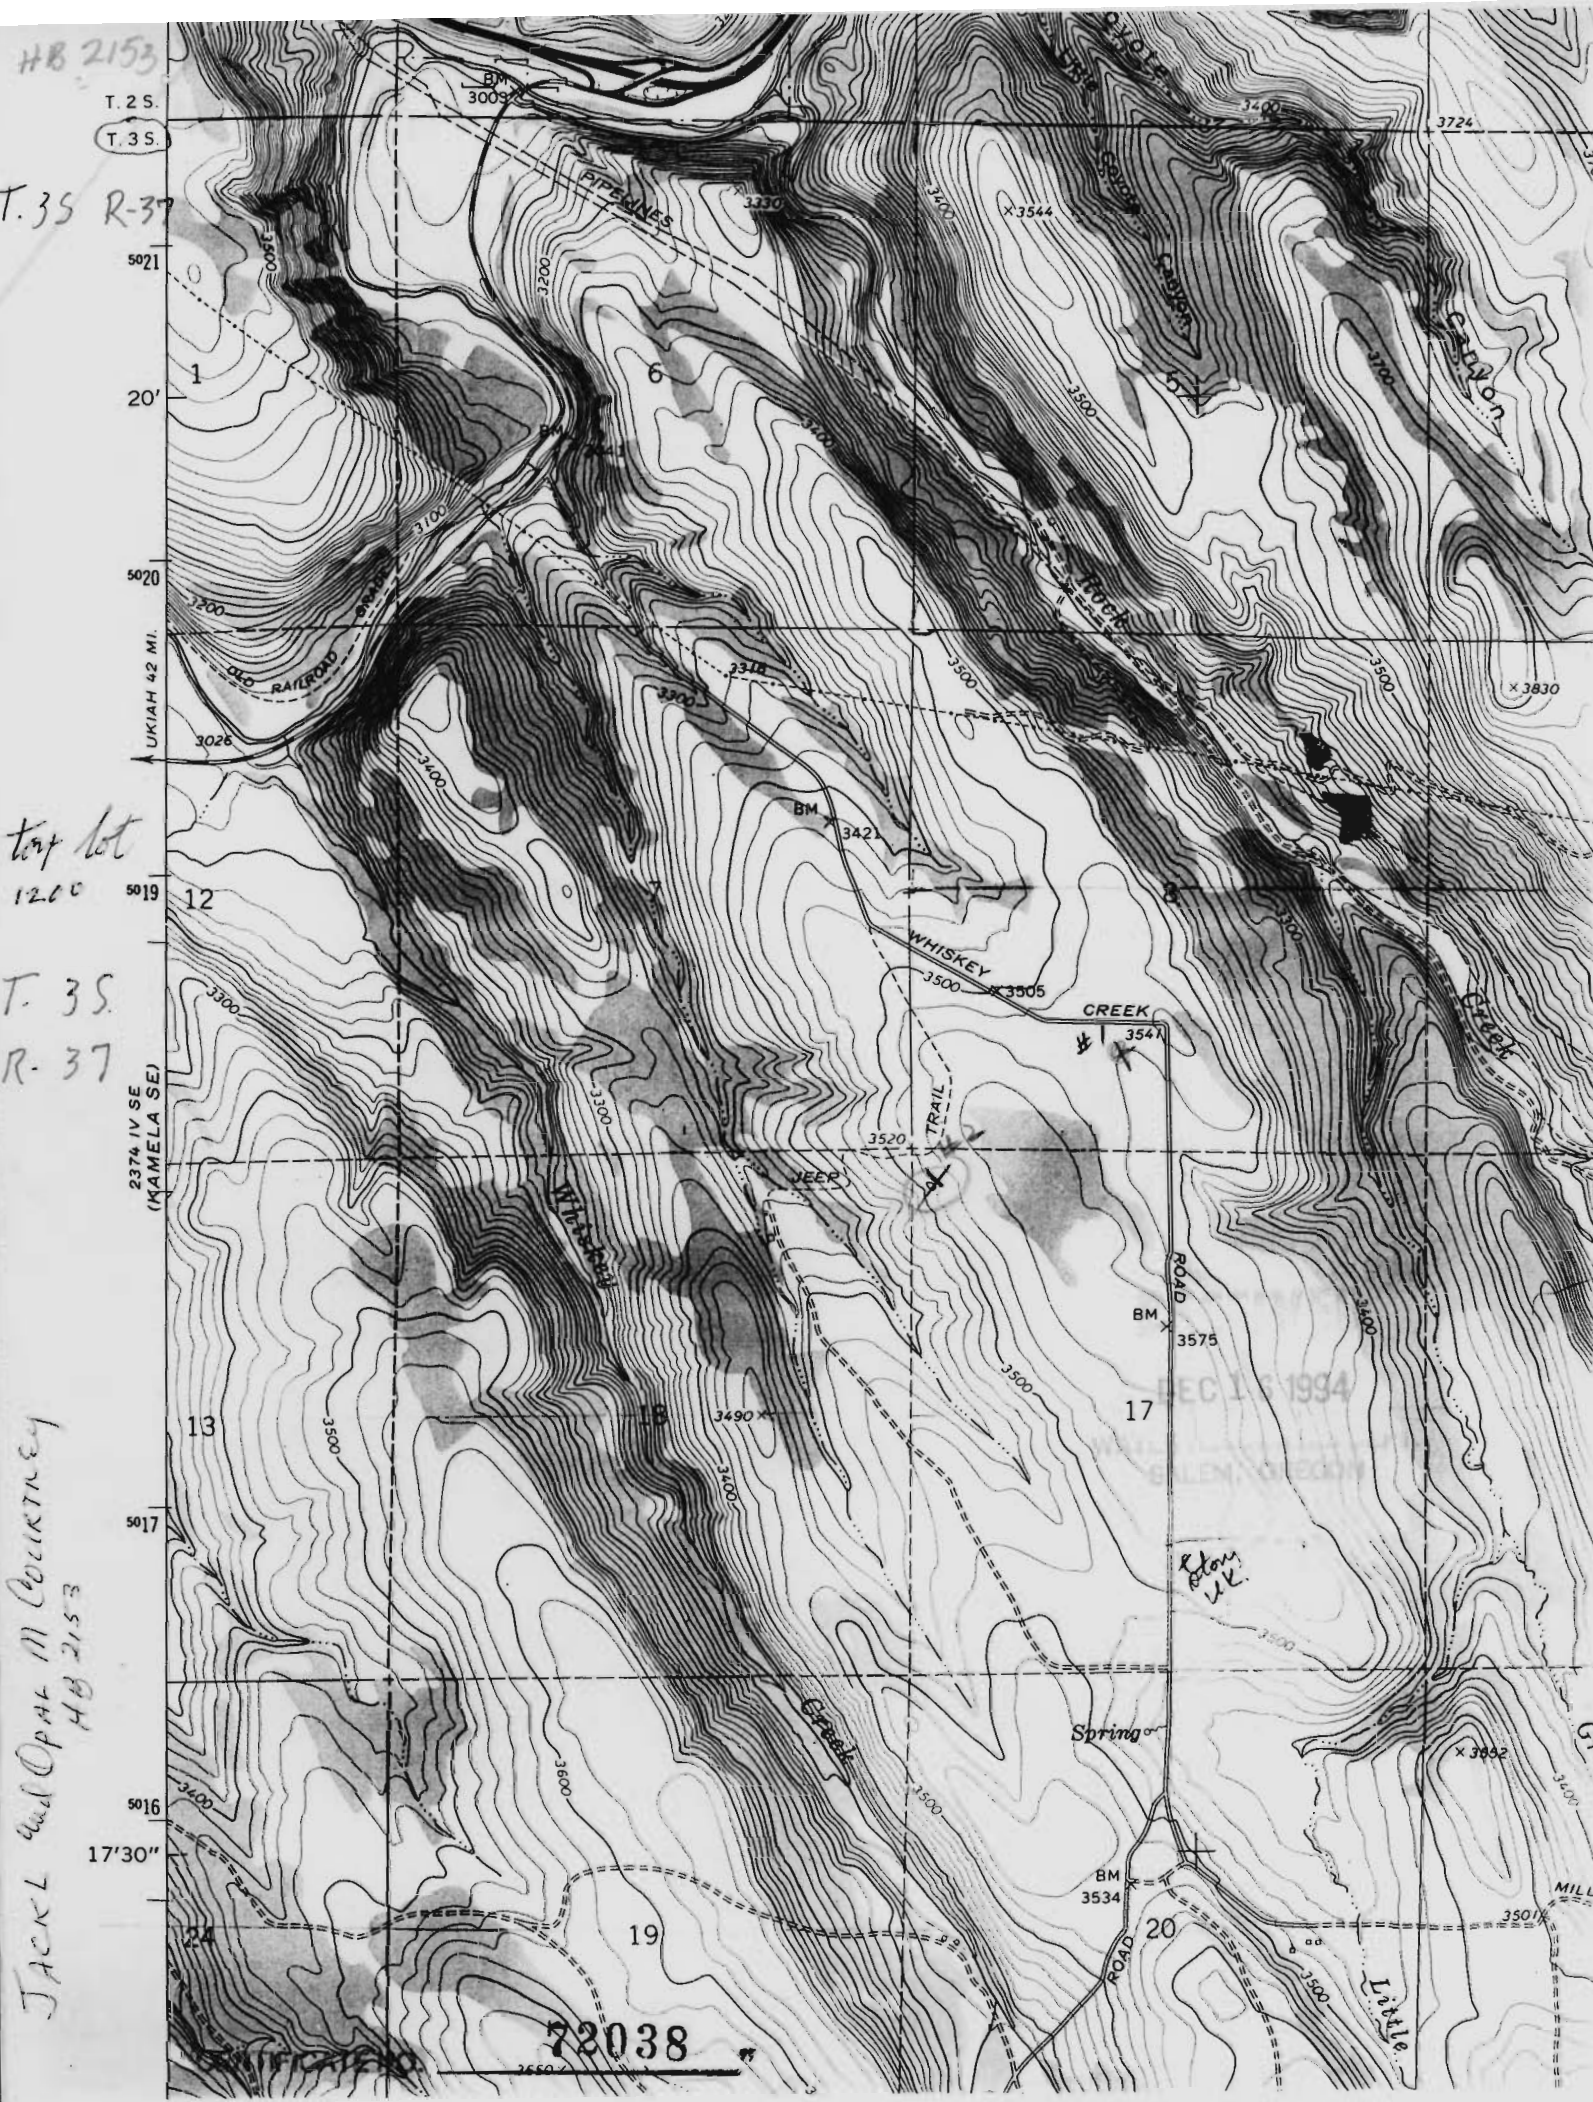

72038