


5

CERTIFICATE NO. 72015

1979 Map

GALES CREEK QUADRANGLE OREGON-WASHINGTON CO. 7.5 MINUTE SERIES (TOPOGRAPHIC) SW/4 FOREST GROVE 15' QUADRANGLE

6

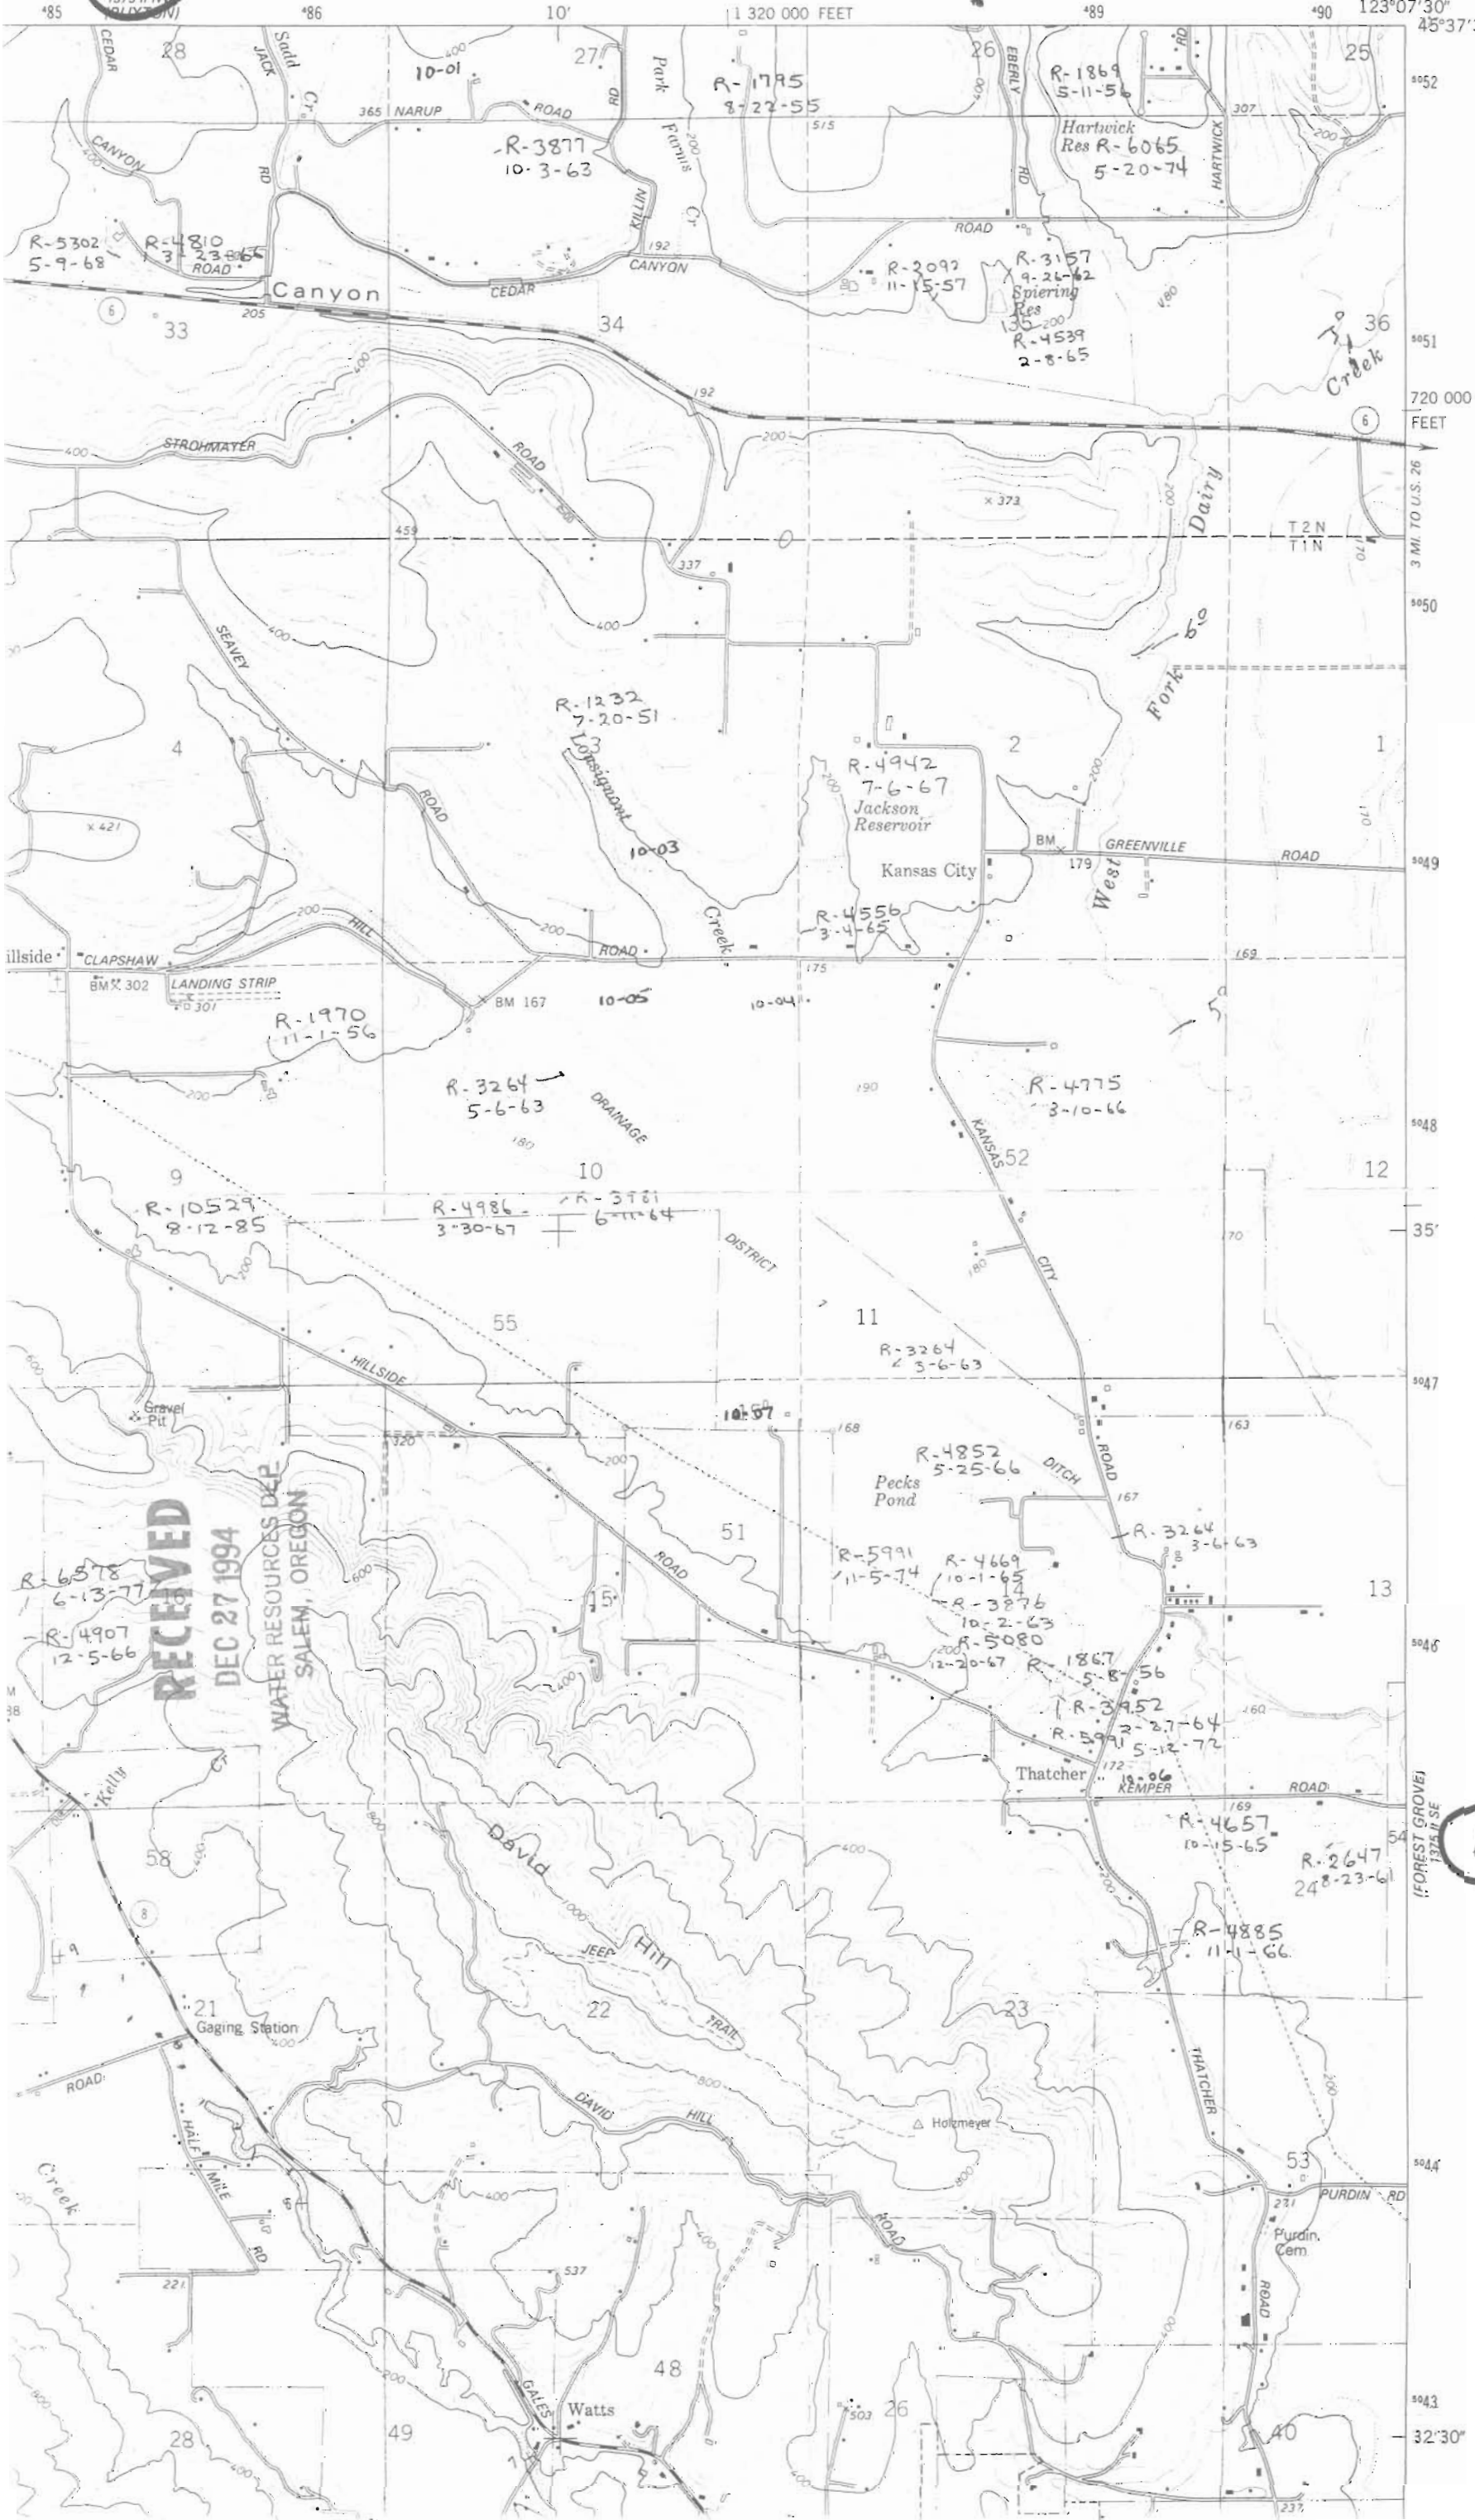

VED GWA
6/29/55
RUK

RECEIVED
DEC 27 1994
WATER RESOURCES DEPT
SALEM, OREGON

Application No. K-80536
Permit No.

11