

CERTIFICATE NO. 72049

DEC 30 1994  
WATER RESOURCES UNIT  
SALEM, OREGON


T-25-S


Permit No.



R-35-E  
R-36-E

Dunnean, Or  
1972

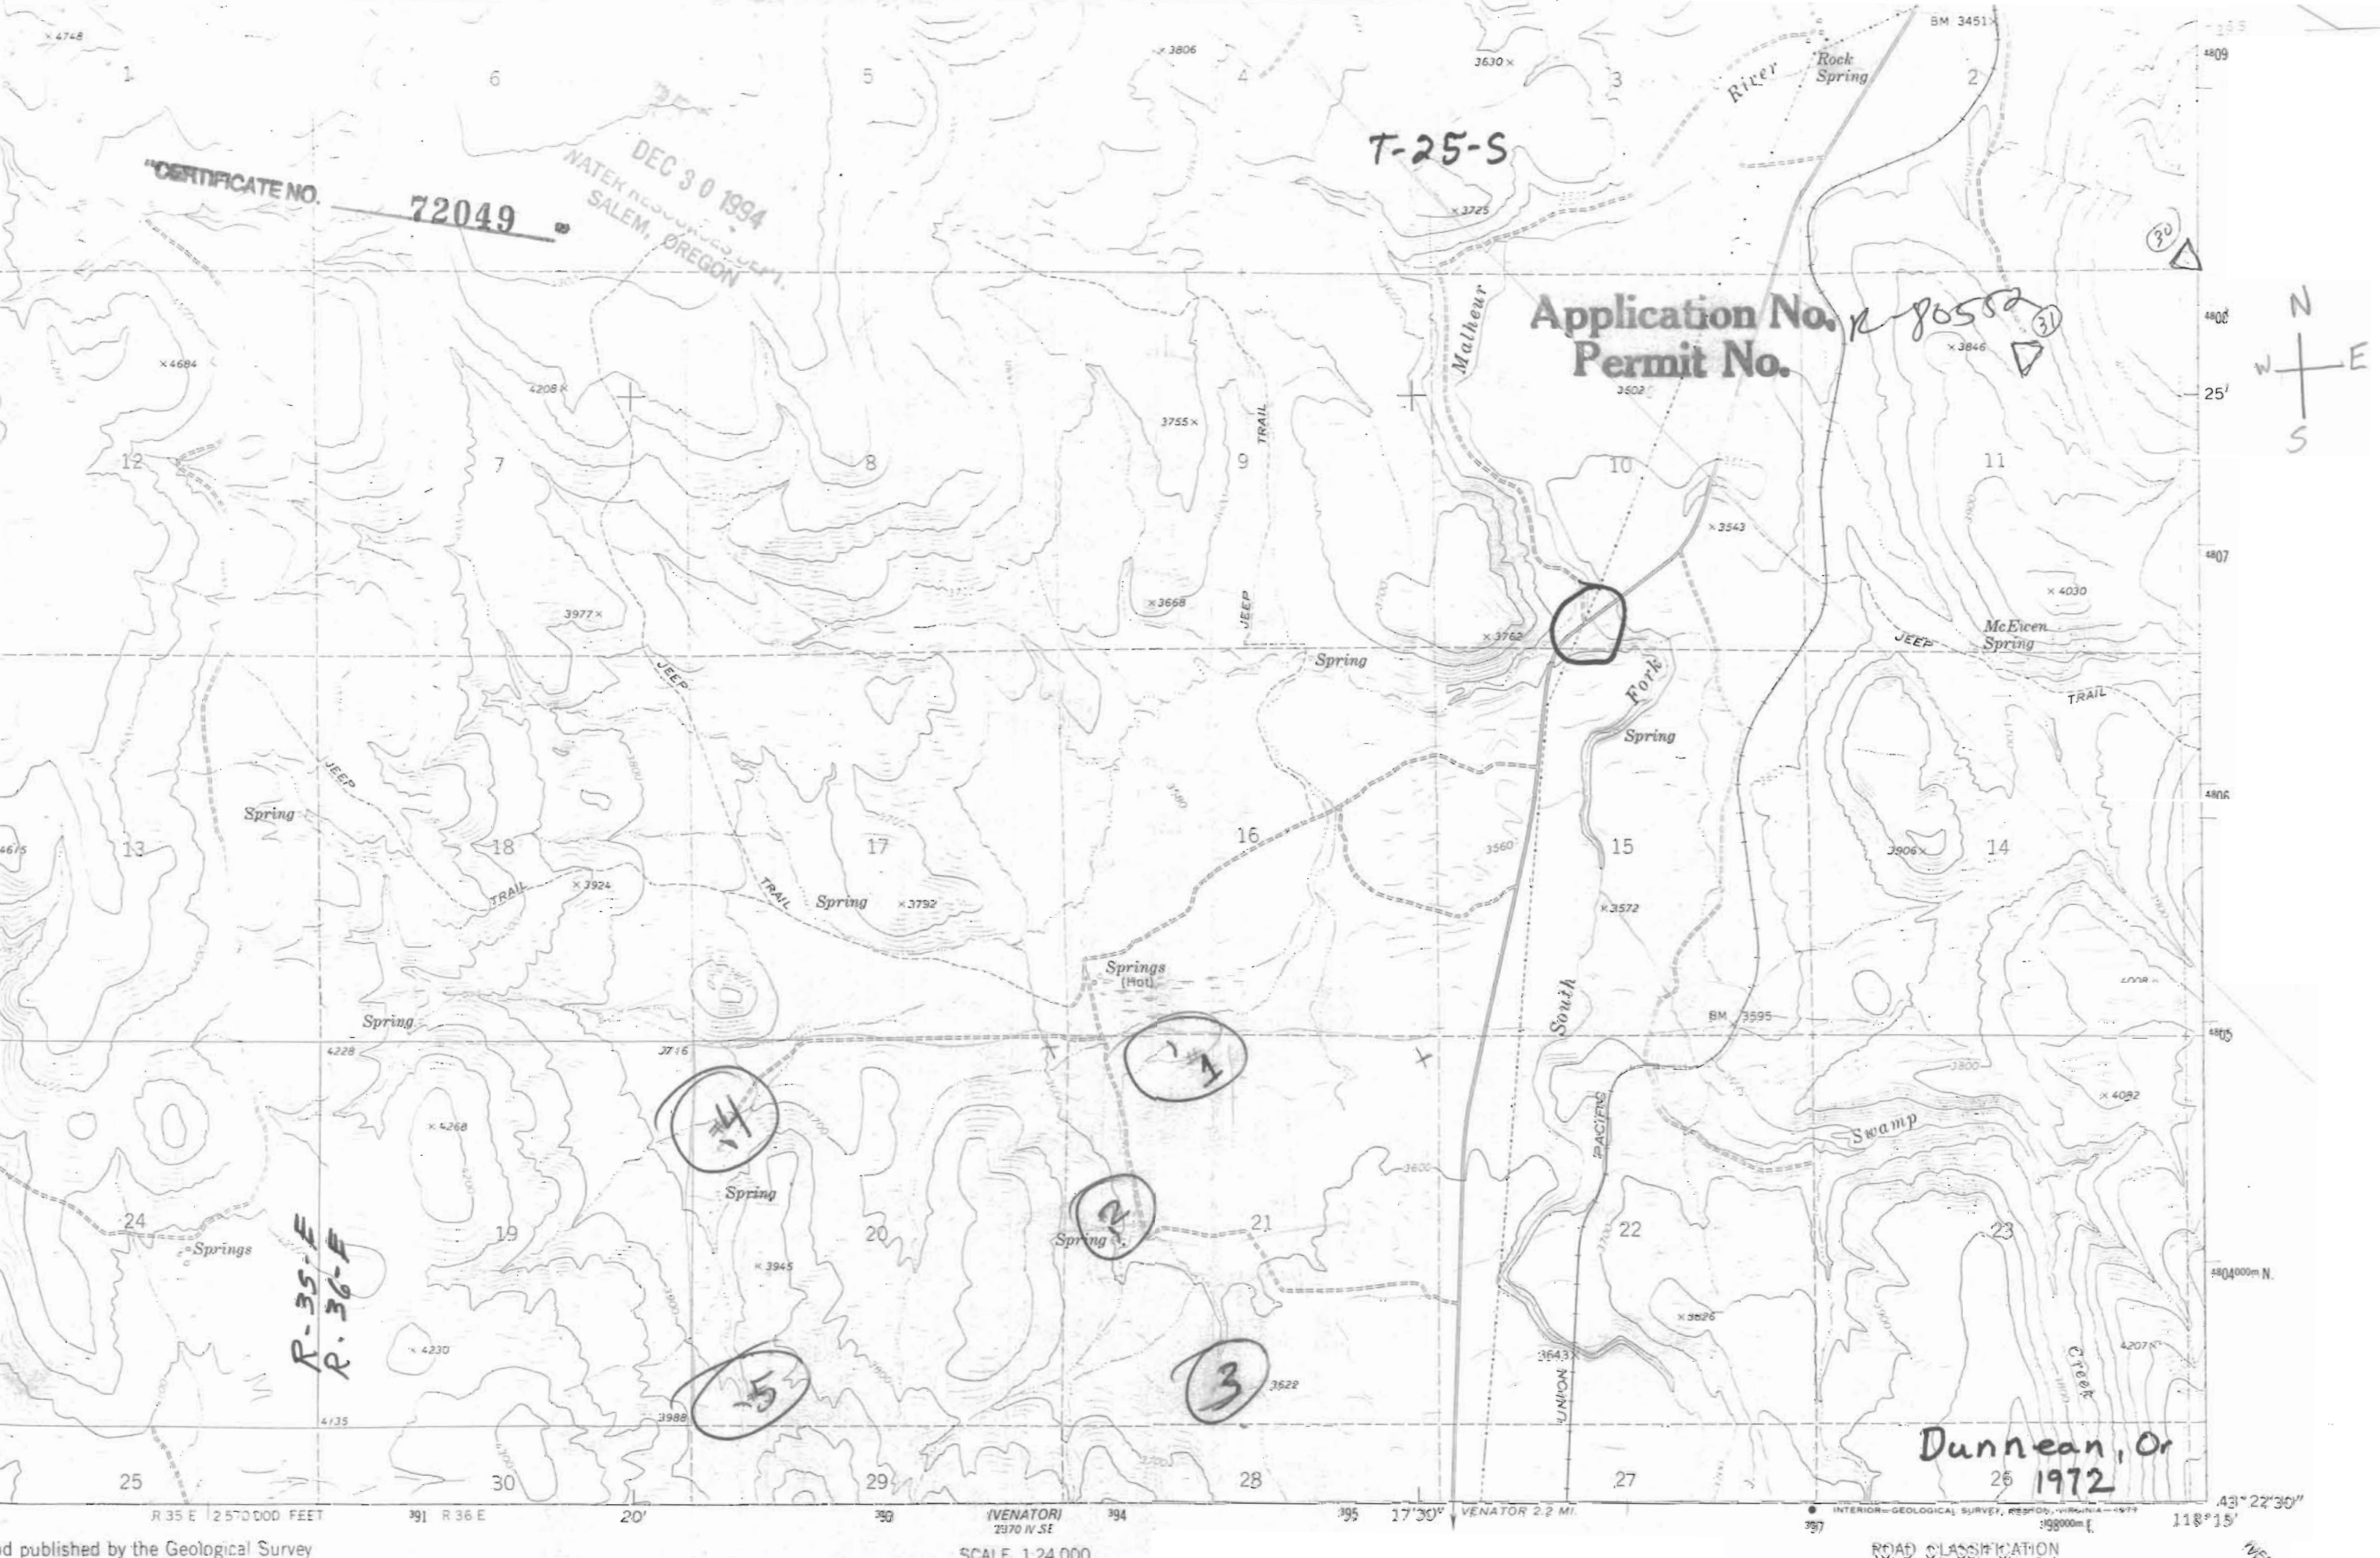

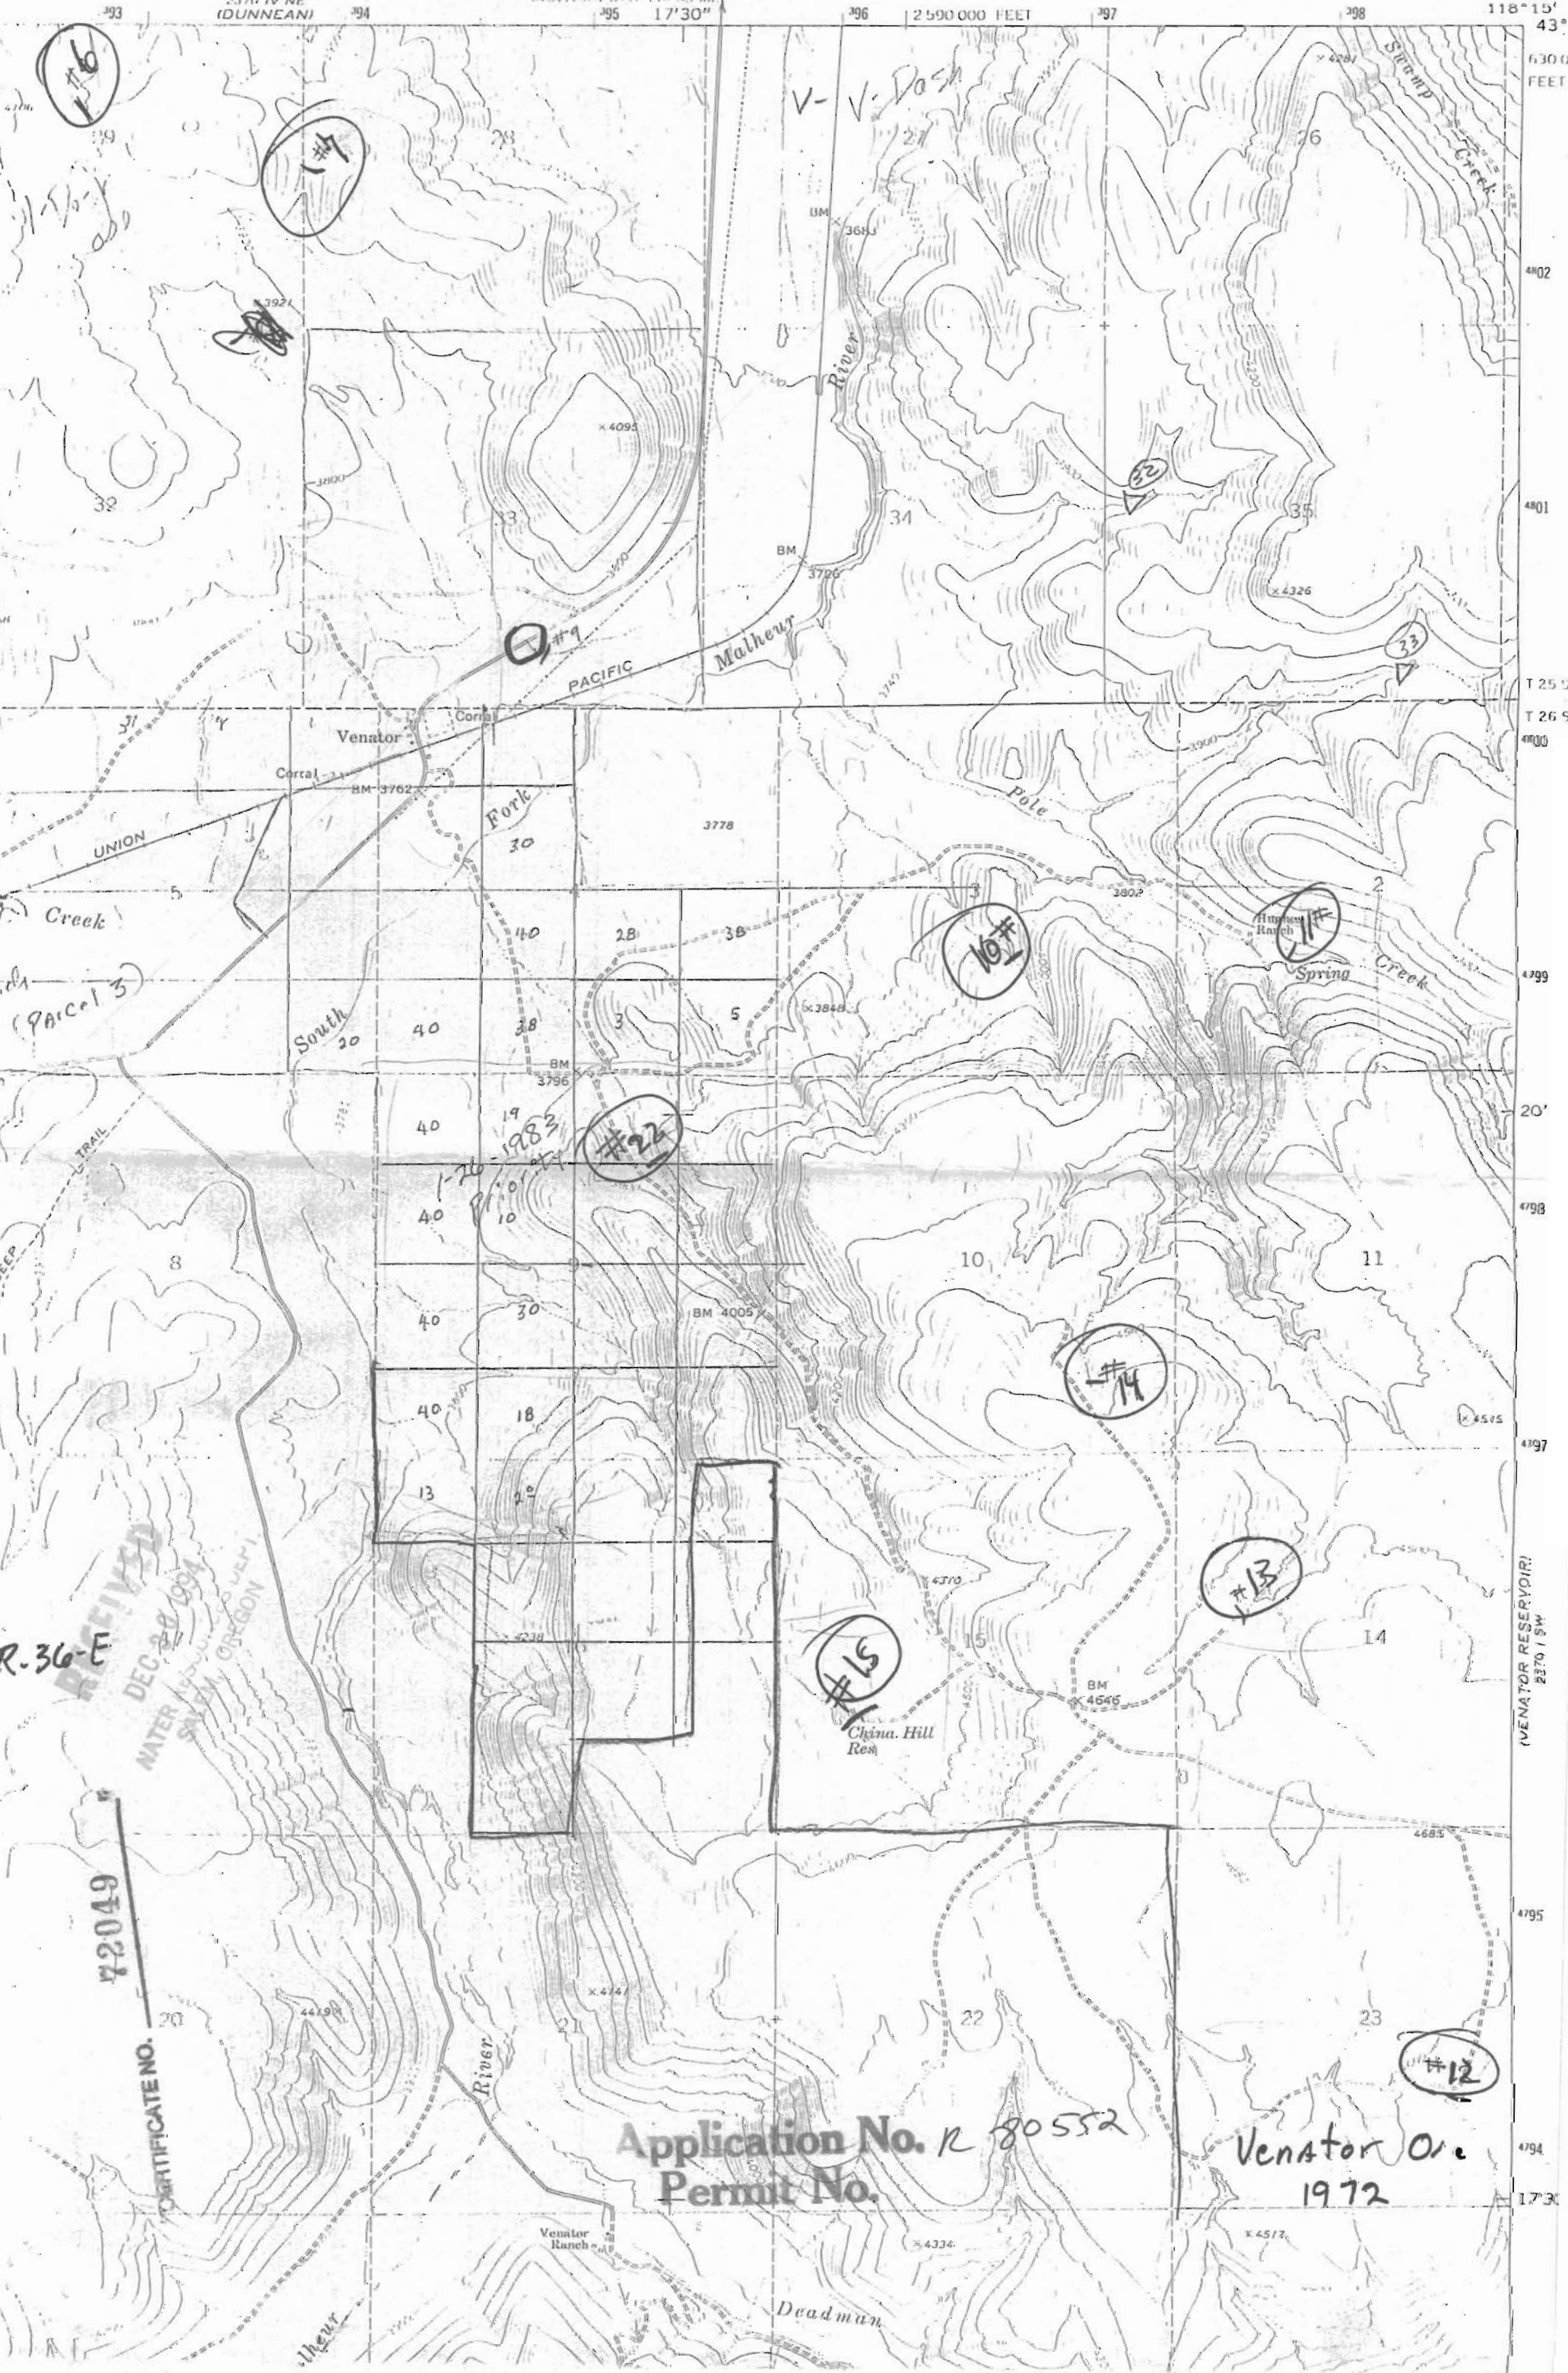

16

1

9

10

12

14

13

15

12

Application No. R 80552  
Permit No.

Venator Or.  
1972

R-36-E

RECEIVED  
DEC 28 1994  
WATER RESOURCES DIVISION  
SALMON, OREGON

72049

CERTIFICATE NO.

Venator Ranch

Deadman

VENATOR RESERVOIR  
2370 I SW