

2370 IV NE
(DUNNEAN)


JUNCTION U.S. 201.35 MI.
17'30"

2 590 000 FEET

118°15'

43°

CERTIFICATE NO. 72051

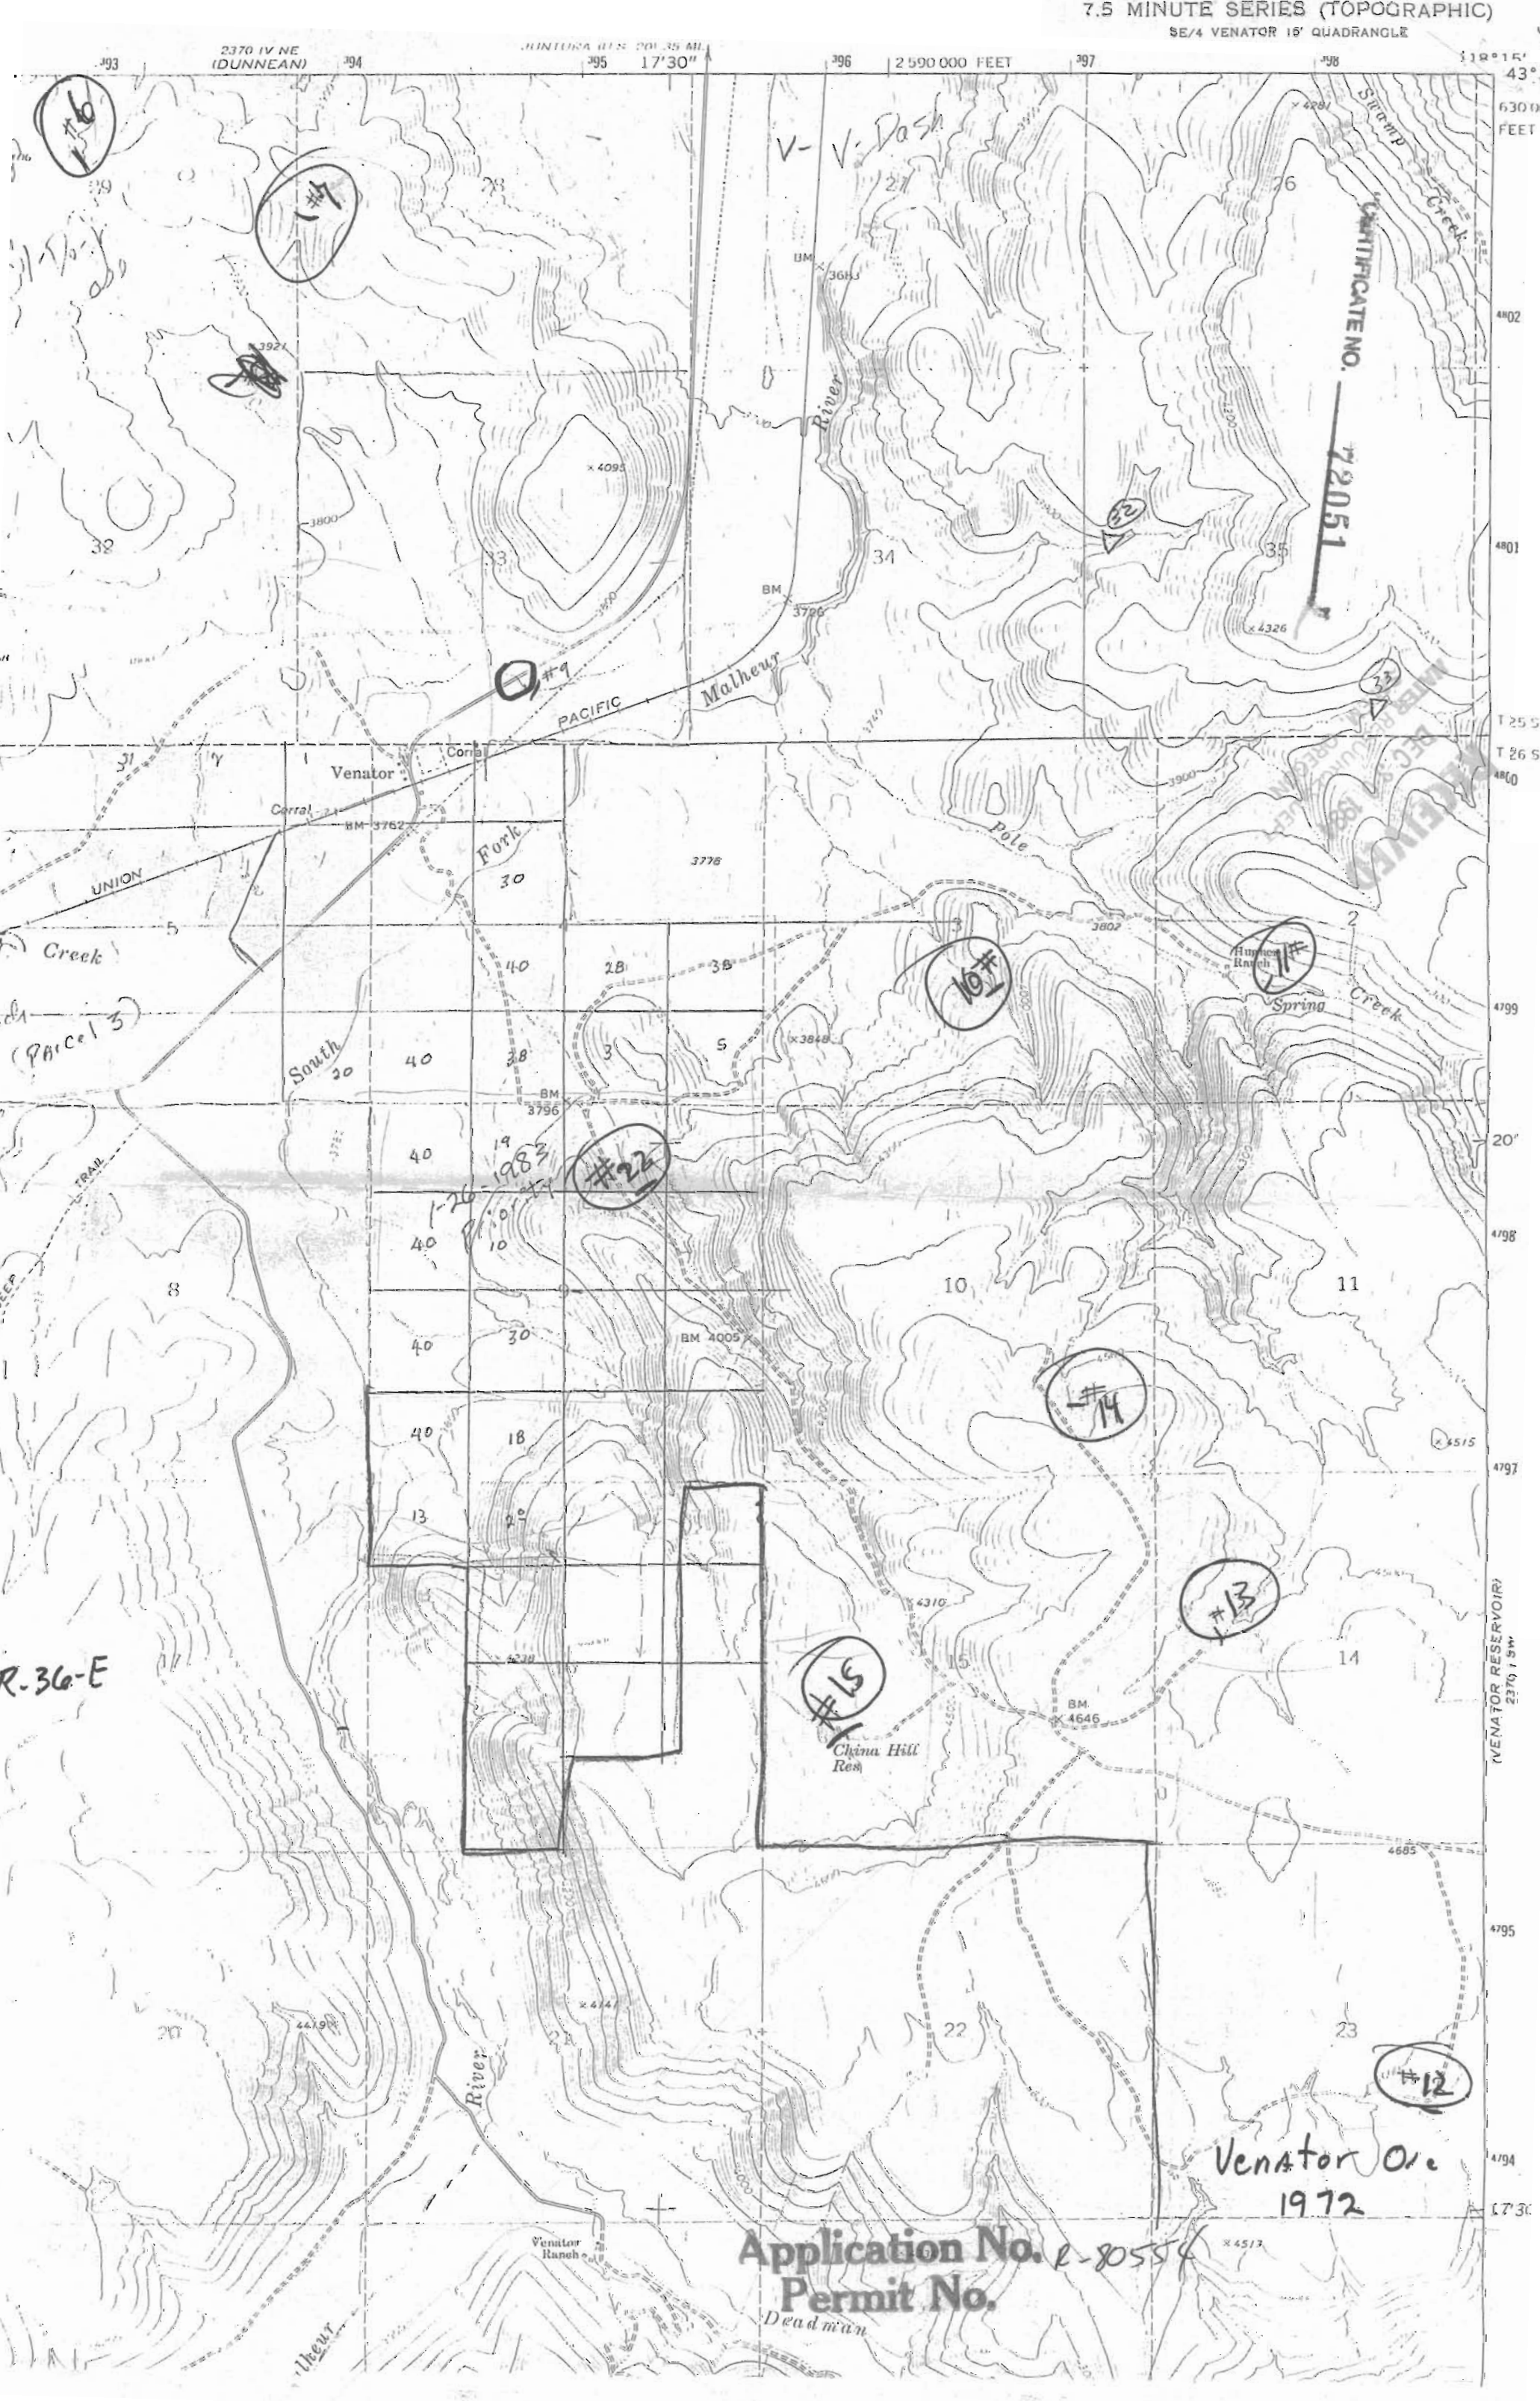

R-36-E

Venator Ore
1972

Application No. R-80554
Permit No.
Deadman