

37316

RECEIVED

DEC 27 1994


WATER RESOURCES DEP.
SALEM, OREGON

T.26 S.R.4 W.W.M.

Application No. R 80561

Permit No. 72053

"CERTIFICATE NO."

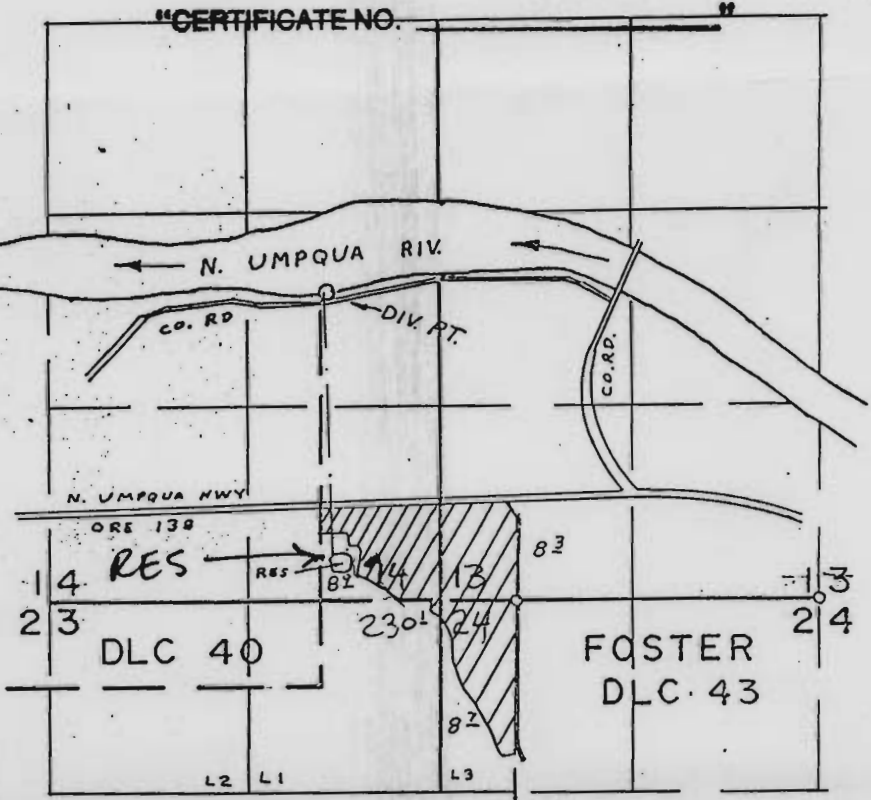

DIV. PT. LOC. 2080' N & 770' W FROM SE COR. SEC. 14

FINAL PROOF SURVEY
UNDER

Application No. 50476 Permit No. 37316
IN NAME OF

GLEN W. WECKS

Surveyed AUG. 29 1974, by L. H. NUNN