


SECTION 36 T.26S. R.4W. W.M.
DOUGLAS COUNTY

REVISED ON
8-6-91

26 4 36

THIS MAP WAS PREPARED FOR
ASSESSMENT PURPOSE ONLY.

1"=400'

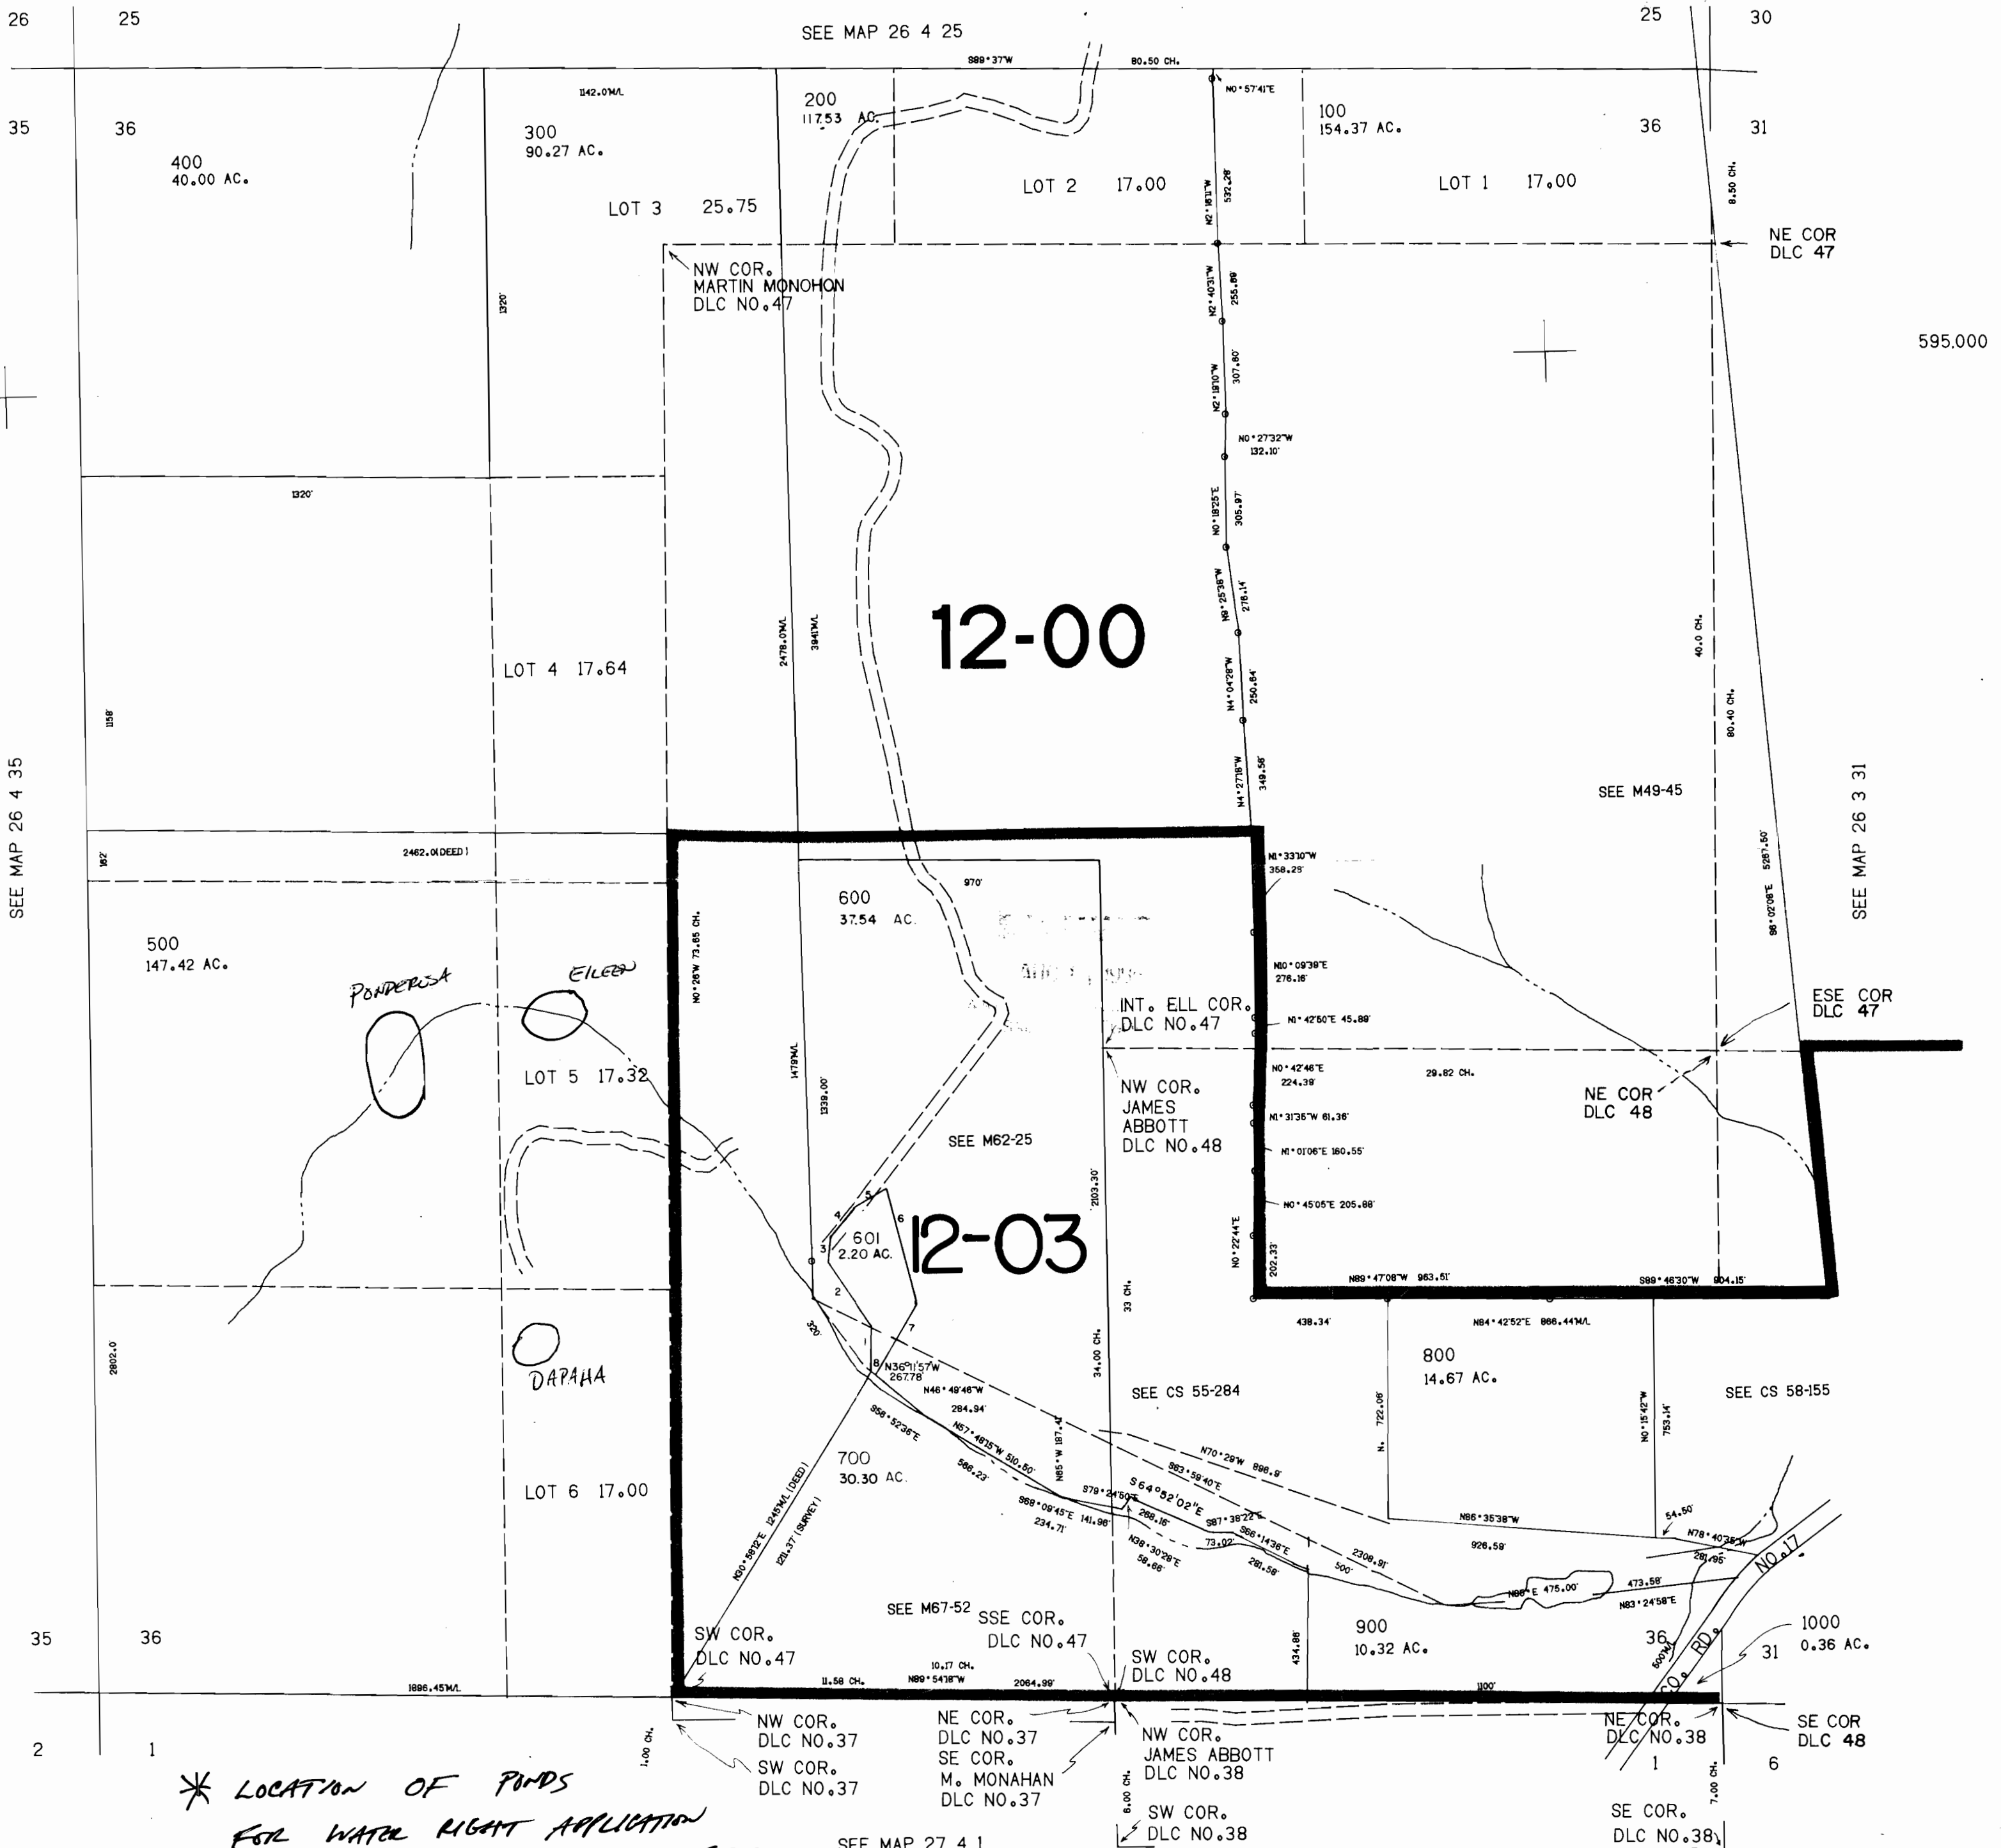

26 4 36