

SE1/4 SEC. 25 T.8S. R.38E. W.M.

BAKER COUNTY

CERTIFICATE NO. 72062


8 38 25D

RECEIVED

JAN - 3 1995

WATER RESOURCES DEP.
SALEM, OREGON

SEE MAP 8 38 25

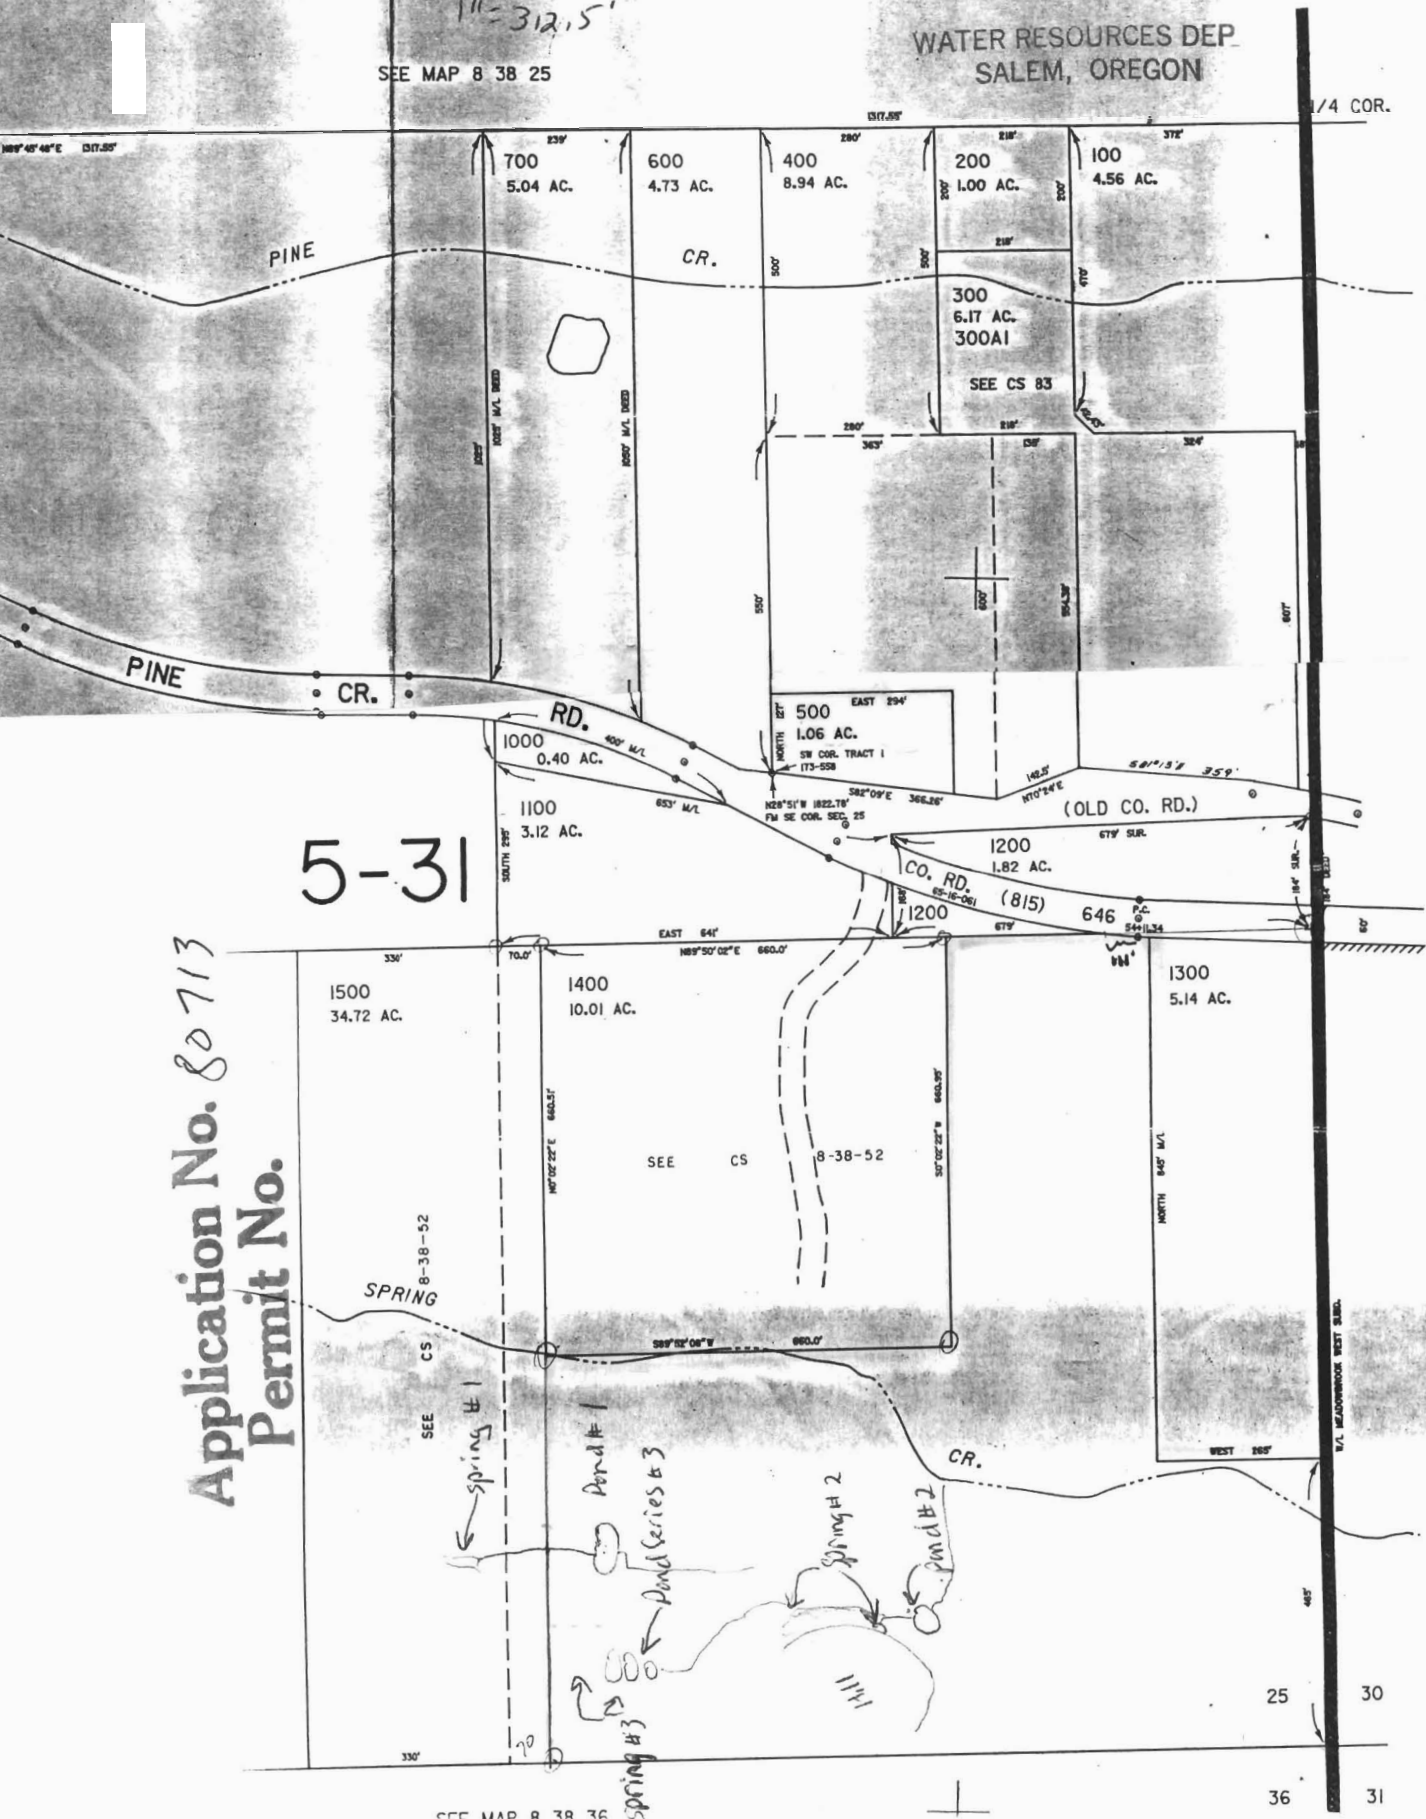

SEE MAP 8 39 30C

SEE MAP 8 38 36

36 31