


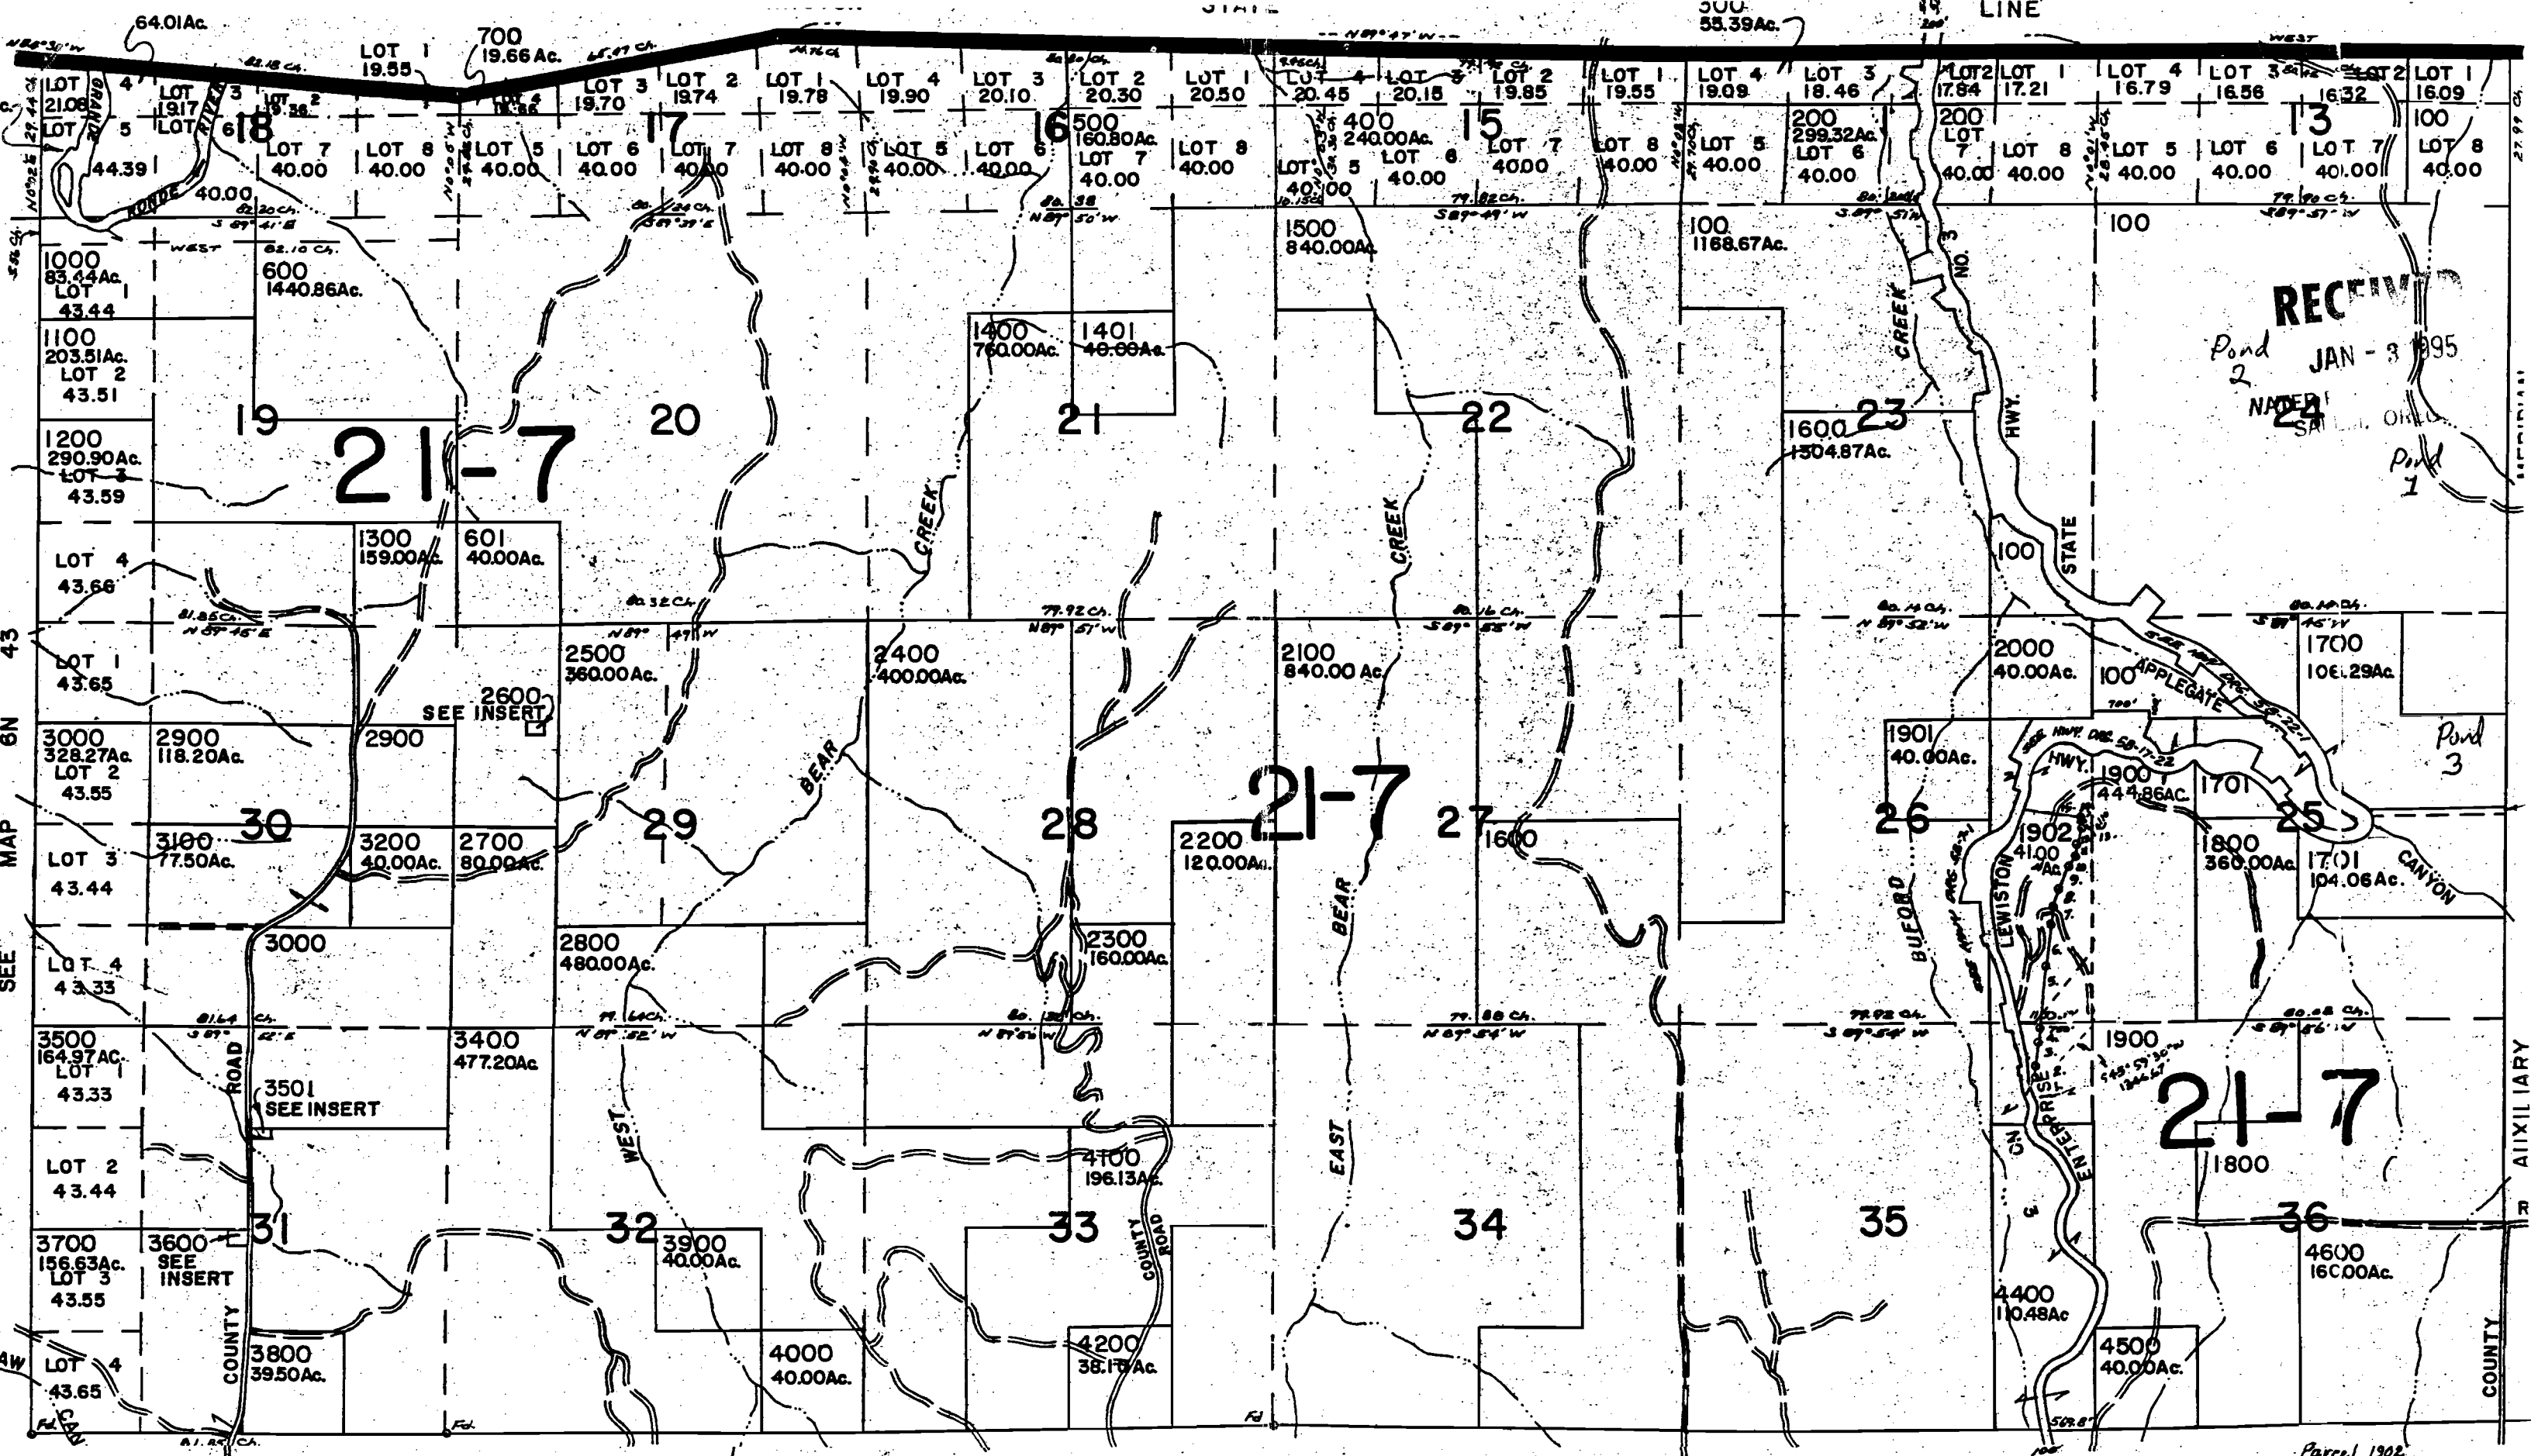

RECEIVED
JAN - 3 1995
Pond 2
Pond 1

SEE MAP 5N 44

CERTIFICATE NO. 72070 6N 44

- Parcel 1902
- 1. N. 34° 19' E. 147.33'
 - 2. N 16° 26' E 180.60'
 - 3. N 3° 55' E 317.72'
 - 4. N 5° 59' E. 199.40'
 - 5. N 6° 46' E. 820.23'
 - 6. N 6° 48' E 515.95'
 - 7. N 7° 35' E 272.40'

INSERT
SEC- 31
1" = 200'

INSERT
SEC- 29 1" = 200'

N.W. COR.
S.W. 1/4 NE 1/4
SEC. 31

55 rods = 9075
E. of NE COR. of
S.E. 1/4 NE 1/4
SEC. 29

WASHINGTON "CERTIFICATE NO. 72070

WASHINGTON

STATE

LINE

