

SECTION 2 T.3S. R.2E. W.M.
CLACKAMAS COUNTY

D.L.C.
CHARLES WALKER NO. 43

3 2 E 2
8 INDEX


This map was prepared for
assessment purpose only.

1" = 400'

SCALE 1:9600.



TL	AD
2400	18317
2401	18318

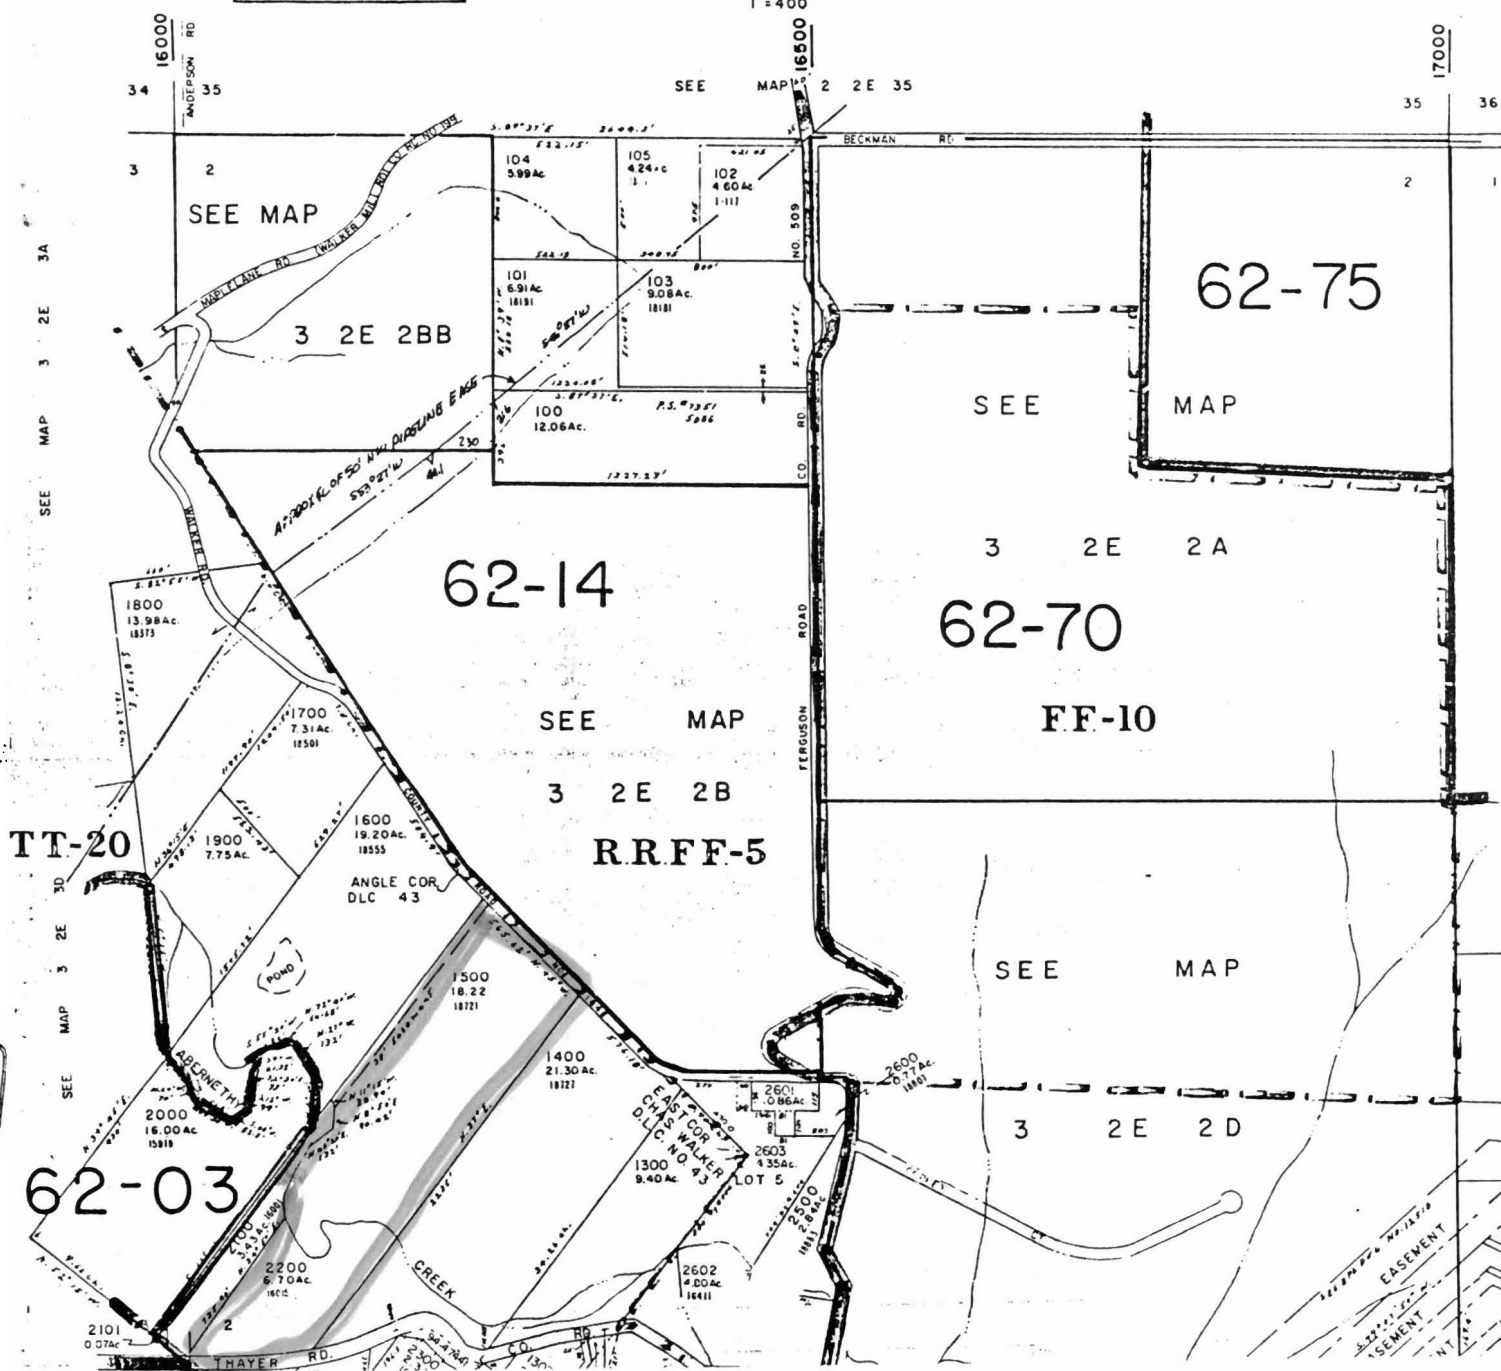

Cancelled T.L.
200 THRU 211
400 THRU 1200
2700 THRU
4202
300
301
302
303
2401/5
2301

Application No. **18500**
Permit No. **18500**

Handwritten signature/initials

RECEIVED
AUG 05 1994
DEPT. OF REVENUE STATE OF OREGON
ASSESSMENT & APPRAISAL DIV.